

Deephead & Hirs
Approved London 28/1/26
Horn 11/2/26

S.A. 8 ⁷⁴⁰ 1500. K20.
CRANKSHAFT (BALANCED DESIGN.)

SCALES:- 1:50, 1:20, 1:10, 1:2, 1:1.


© 2021
Eloyds Reg
Foundation

J. Cuming.
W. Slessor.
16/4/76.

Shafting

Kincaid K. 20

Depl of K15 Approved 28/6/26

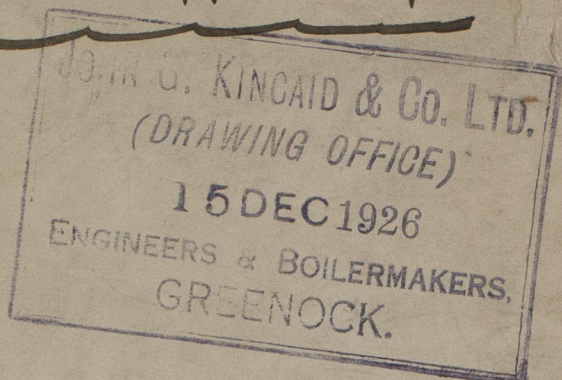

Butest Couage

Grk Rpt No 1886)

RETAIN



© 2021

W1645-0135

Lloyd's Register
Foundation