
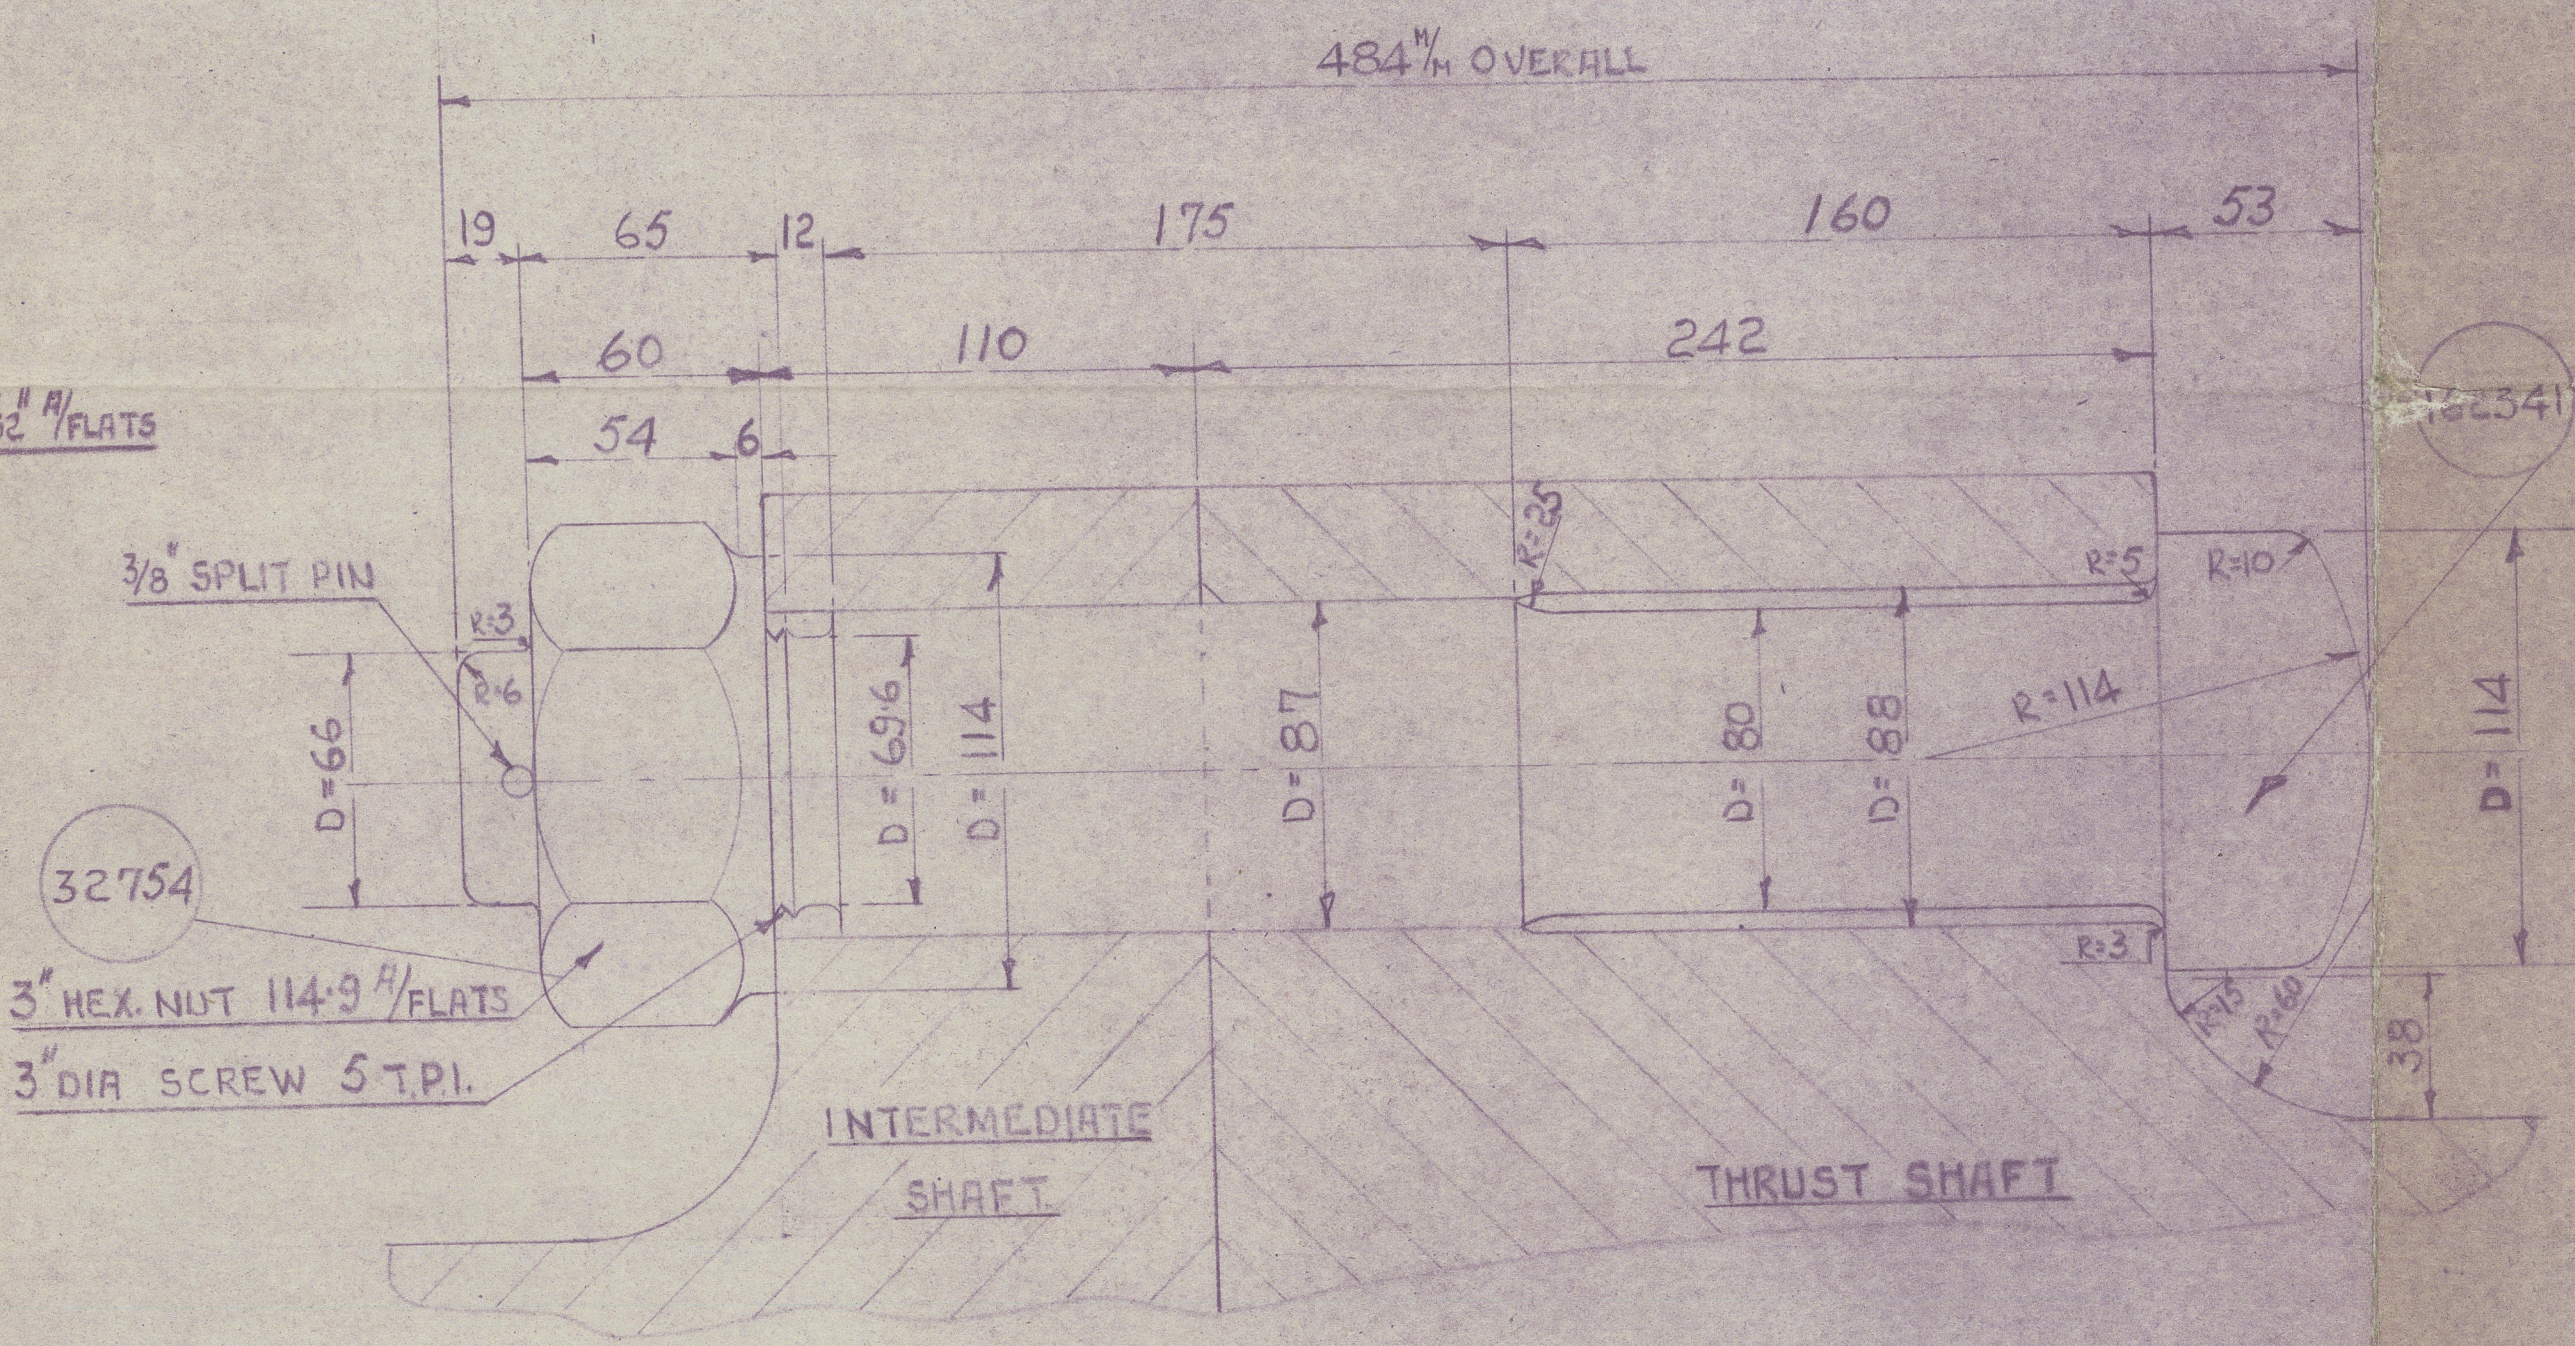
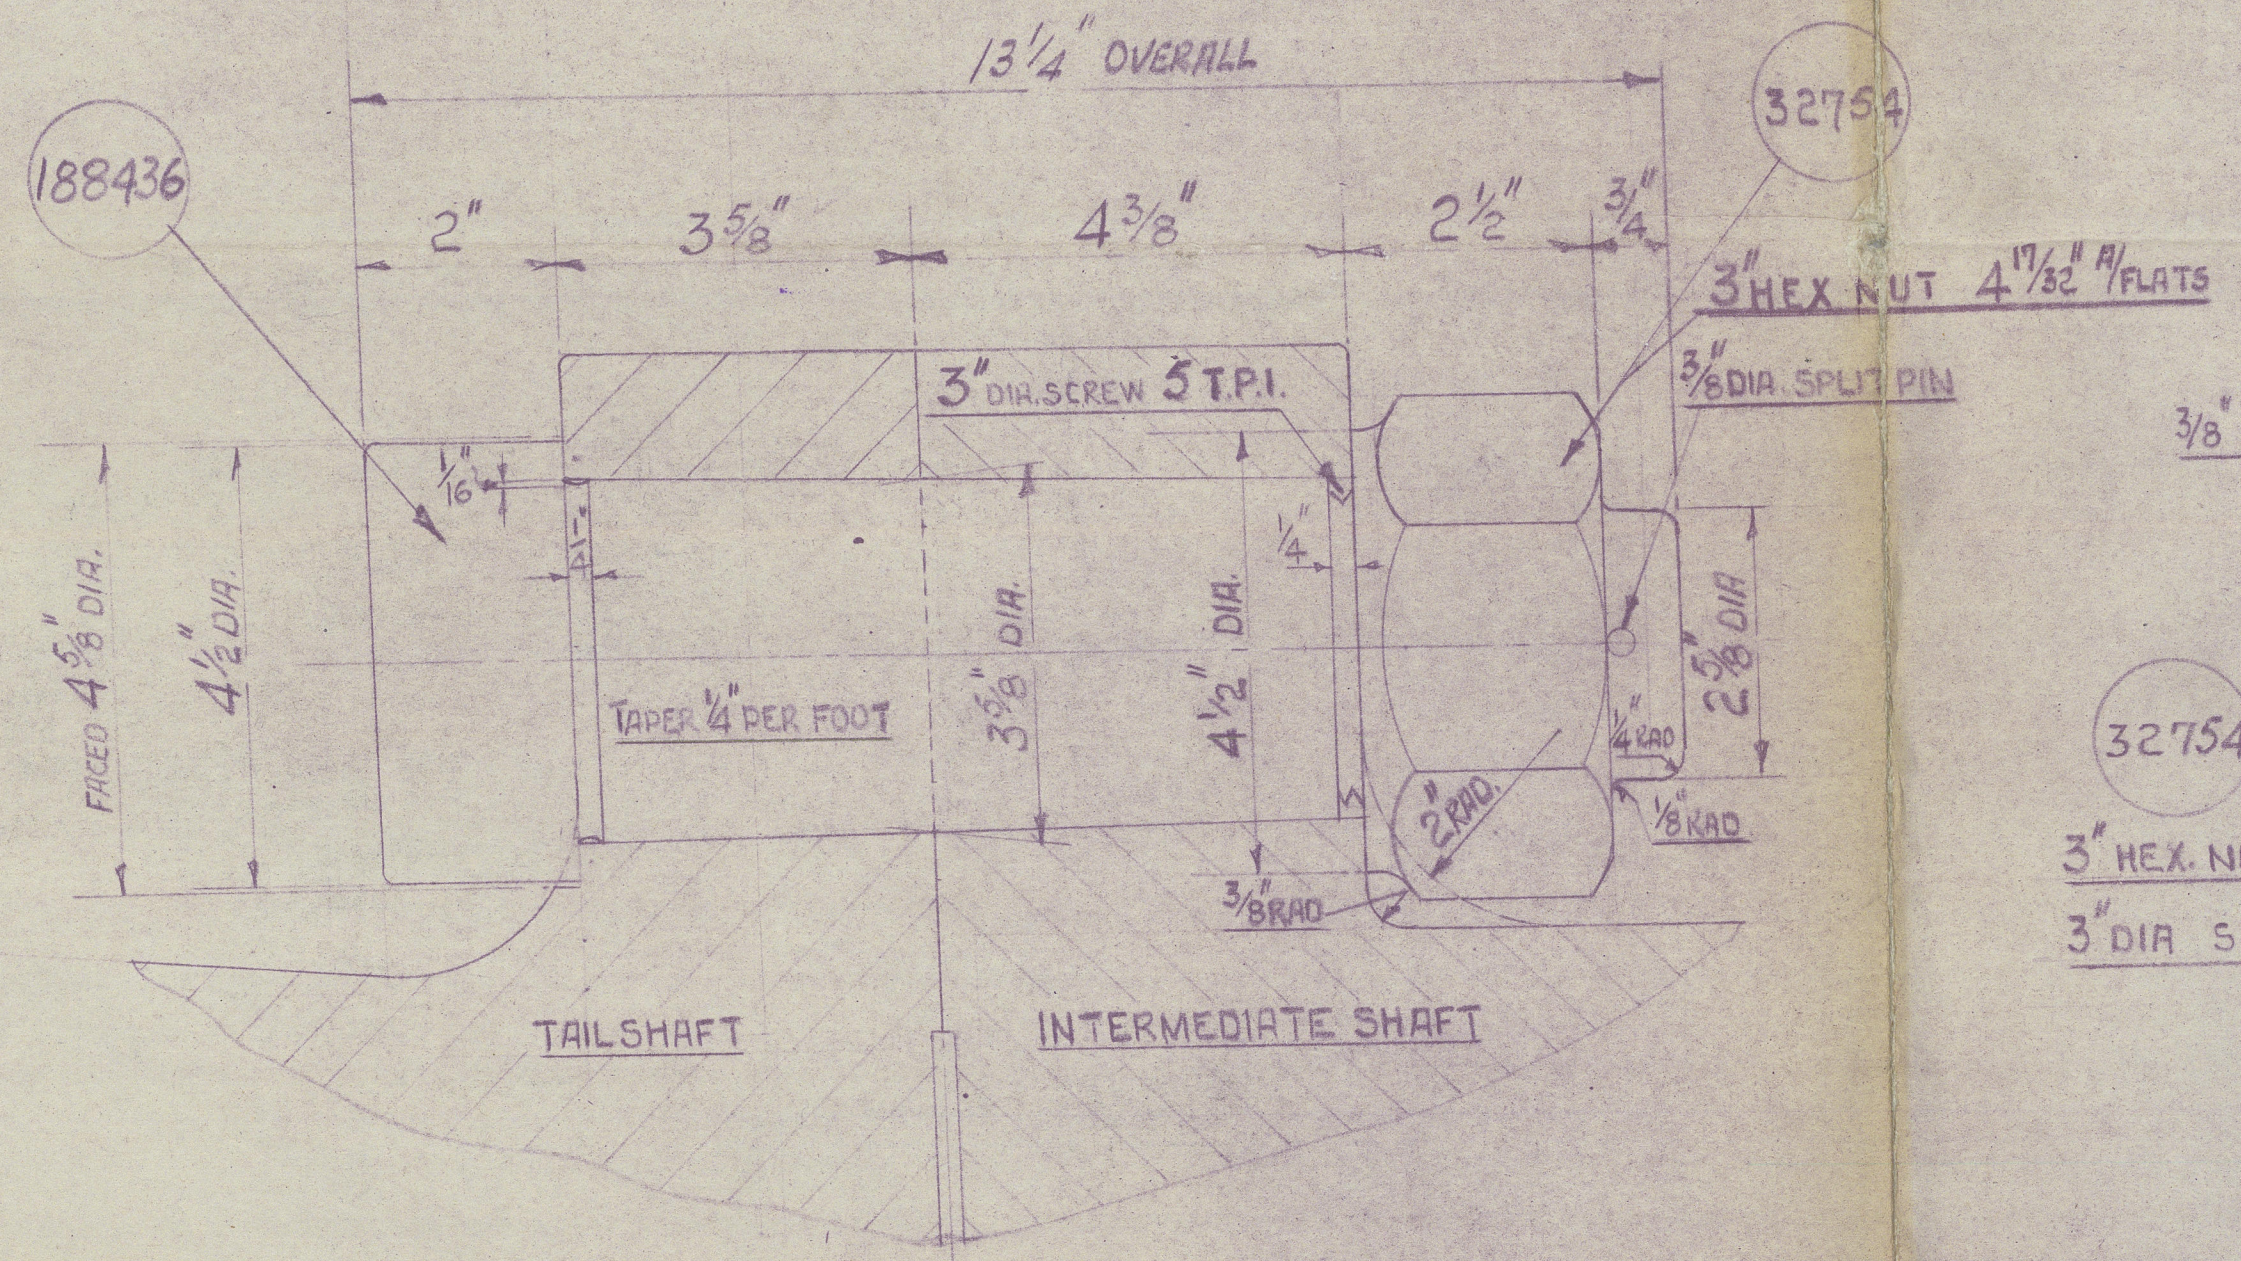


NOTE: DIMENSIONS MARKED THUS, ⊗
ARE DRAWING DIMENSIONS.
CORRECT DIMENSIONS TO BE
TAKEN FROM SHIP.

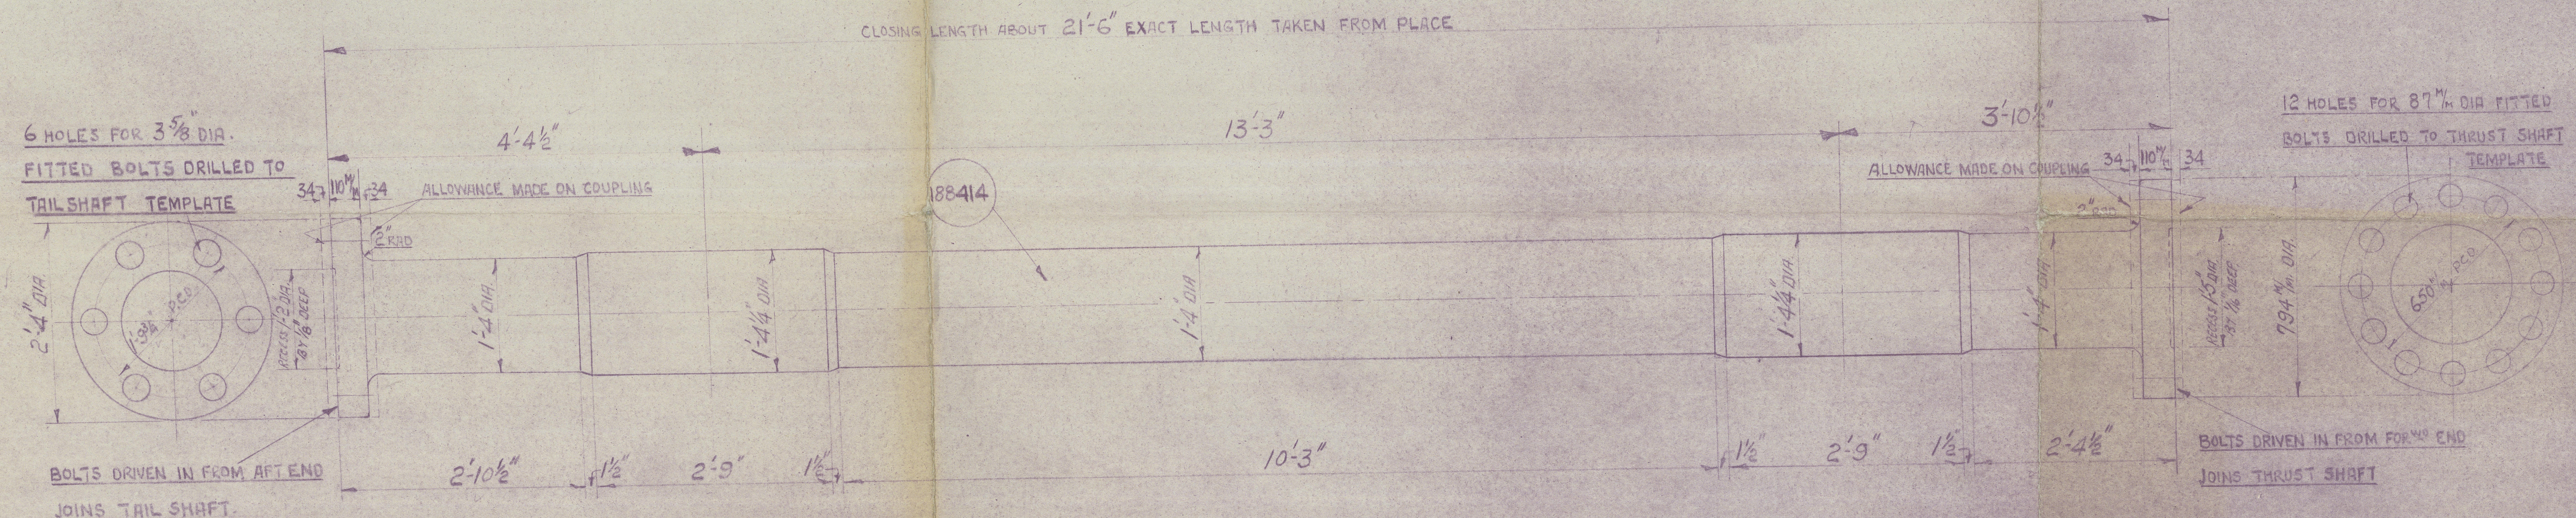

NO. OFF SHIP	DESCRIPTION	PATTERN NUMBER	MAT'L	WT. IN LBS	REMARKS	SHOP OF JIS
1	TAIL SHAFT	188431	M.S.3			
1	" " " LINER	188432	G.M.10			
1	" " " KEY	188433	M.S.1		EXISTING PARTS TO BE USED	
2	" " " SET PIN (CH. HD.)	C.35	"			
1	" " " NUT (L.H. THRD.)	188434	W.I.			
1	" " " LOCKING PLATE	188435	M.S.1			
1	" " " SET PIN	C.15	"		STD. DR. NO. 25209	
1	INTERMED. SHAFT	188414	M.S.3			
6	" " " COUPLING BOLT	188436	"	3 5/8" DIA.		
6	" " " NUT	32754	W.I.	3/8" DIA.		
6	" " " SPLIT PIN	—	STEEL			
—	THRUST SHAFT COUPLING BOLT	162341	M.S.3		ORD. ON DES. NO. 72126	
—	" " " NUT	32754	W.I.			
—	" " " SPLIT PIN	—	STEEL	3/8" DIA.		

G.O.N° A21

MV "BRITISH COURAGE"

DETAILS OF SHAFTING.

SCALE: 1" = 1 FT. 1/2 F.S.

APPROVED

LLOYD'S REGISTER OF SHIPPING

J. B. Beveridge

DATE 23/3/44

SHAFTING LINER, KEY & COUPLING BOLTS MACHINED ALL OVER

TAIL SHAFT NUT & LOCKING PLATE MACHINED WHERE MARKED THUS ▽

TO LLOYD'S SURVEY TESTS & REQUIREMENTS

P. D. SMITH

18-2-44

ALTERATION
PLAN

British Courage

Arrgt Shaptnis

(12712)

Glasgow Road 68982

29



© 2021

Lloyd's Register
Foundation