

29/6/20


3 1/2" ER. BILGE SUCT ✓

1 1/2" BILGE PUMP DIRECT SUCT  
P-12000

3 1/2" BILGE SUCT FROM DRAIN PNT ✓

AFT.

FOR

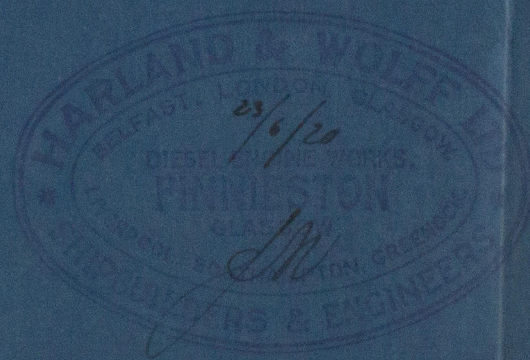

3 1/2" ER. BILGE SUCT ✓

5 BILGE PUMP DIRECT BILGE SUCT ✓

4 1/2" BILGE PUMP DIRECT SUCT ✓

28-6-20

57

PORTION OF BILGE SUCT IN LLOYD'S REGISTER FOUNDATION



W1647-0212

Glasgow  
Harland & Wolff  
Suctions in Machinery Space  
T. Austin Ship No 578-9

---

No 578 Korsethurn

No 579 Somatshurn

---

GLASGOW REPORT No.

41086.

W1647- 0212



© 2020

Lloyd's Register  
Foundation