
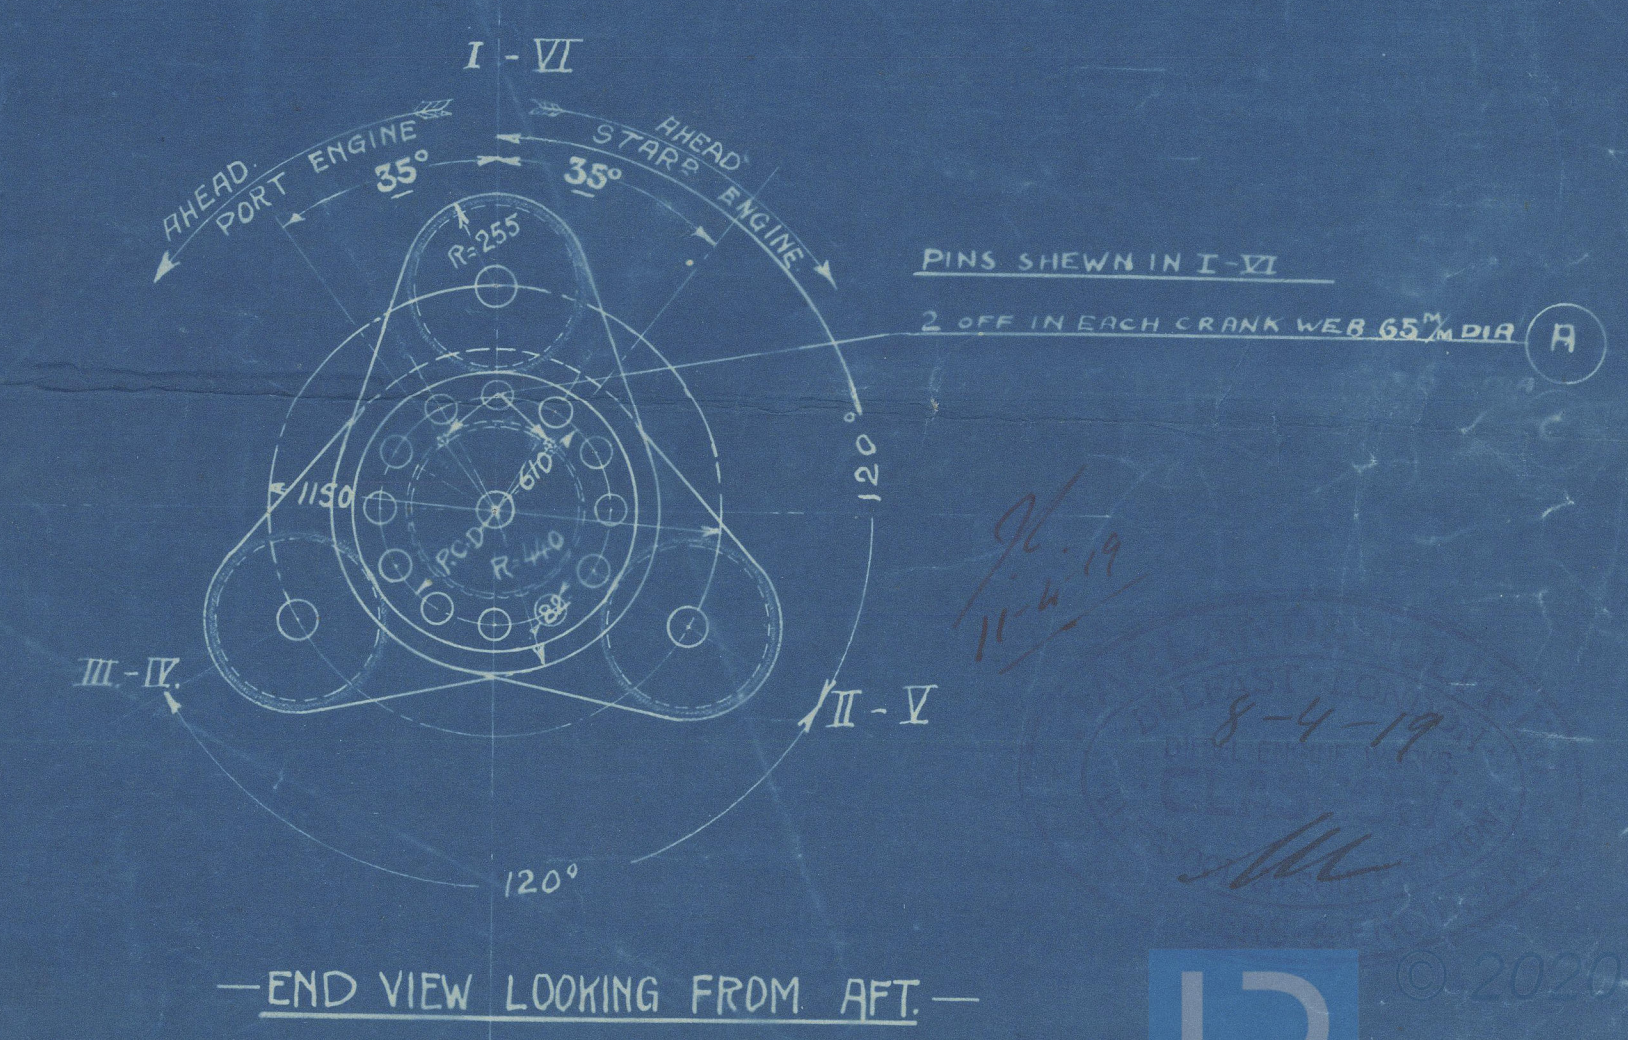


12/4/19 4353.

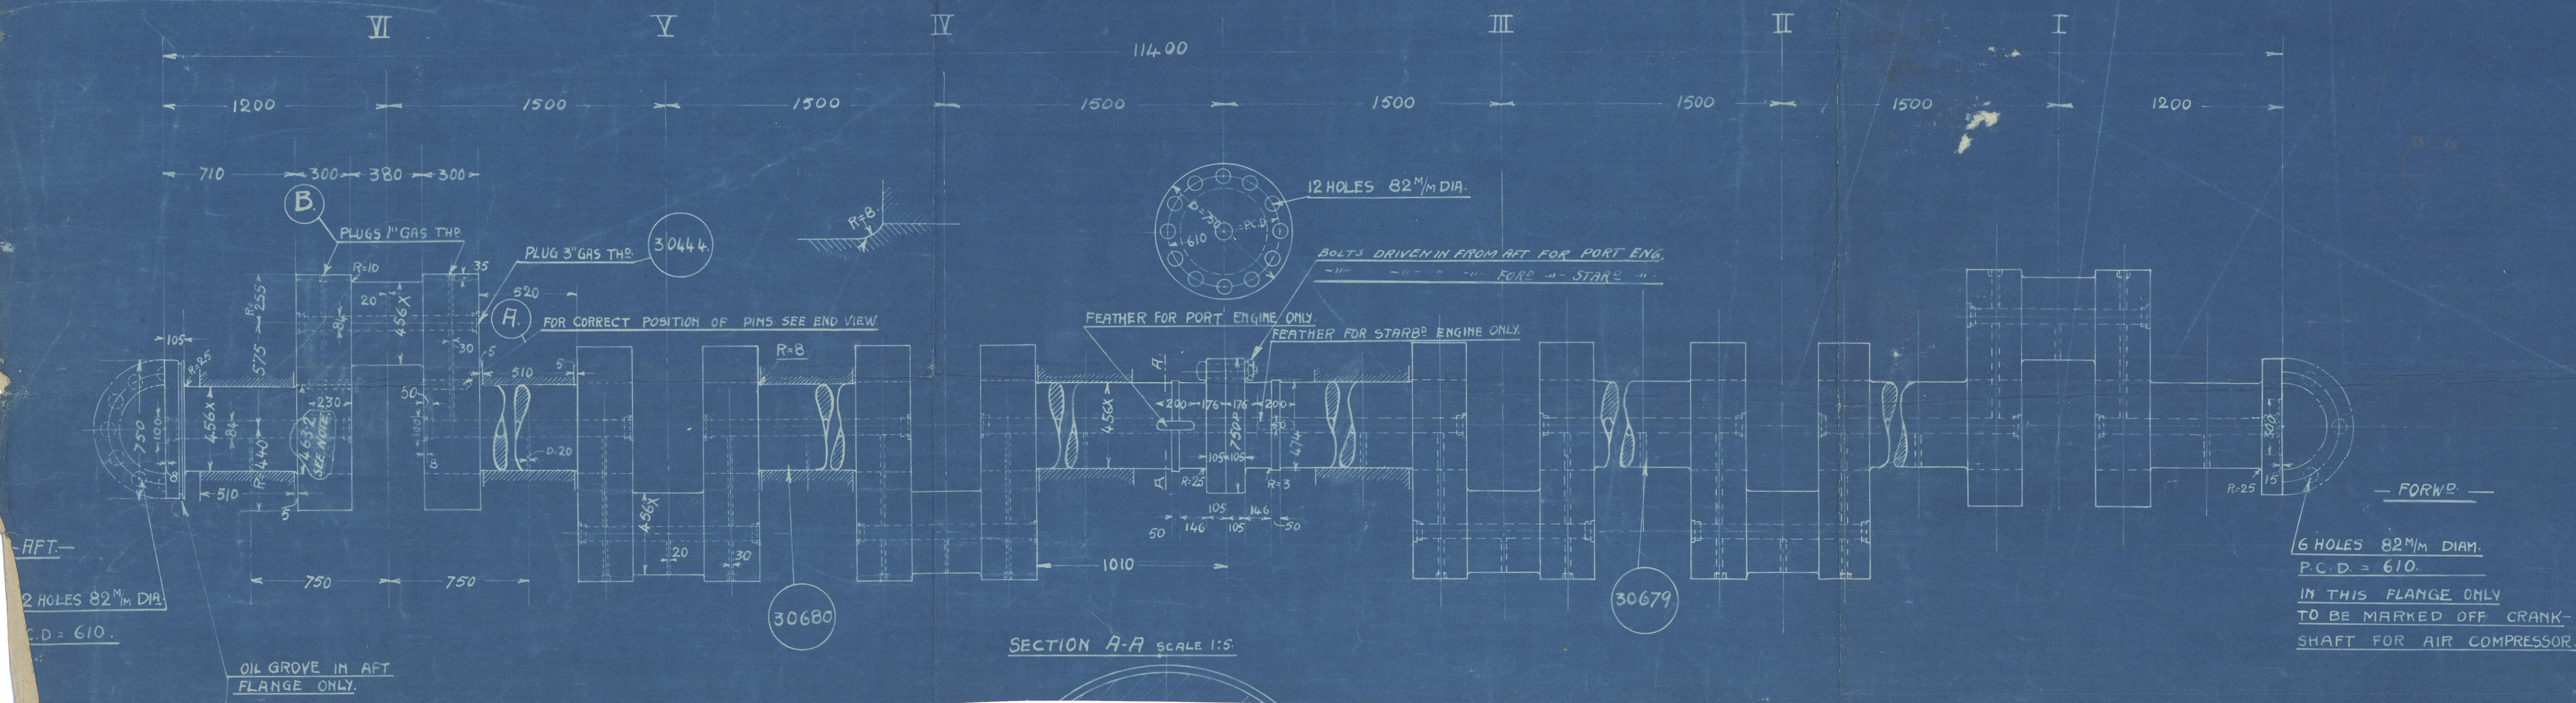

Es

Harland & Wolff's  
Main Crank Shafts

Engine nos 5780-5790

Shaft no 578<sup>B/8</sup> 579<sup>B/8</sup>


Plan no 4353

App'd Plan

No 578 Dorsetshire

No 579 Somersetshire

GLASGOW REPORT No. 41086.

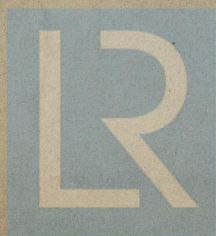

© 2020

Lloyd's Register  
Foundation

W164-0213