

M. V's. "DORSETSHIRE" & "SOMERSETSHIRE."


GENERAL ARRANGEMENTS. [AS FITTED.]

SCALE $\frac{1}{16}$ INCH = ONE FOOT.

BERTH NUMBERING:-
WHERE BERTHS ARE IN DOUBLE TIER,
EVEN NUMBERS DENOTE UPPER BERTHS.

"D" DECK.


"D" DECK TO "C" DECK 8'-0"

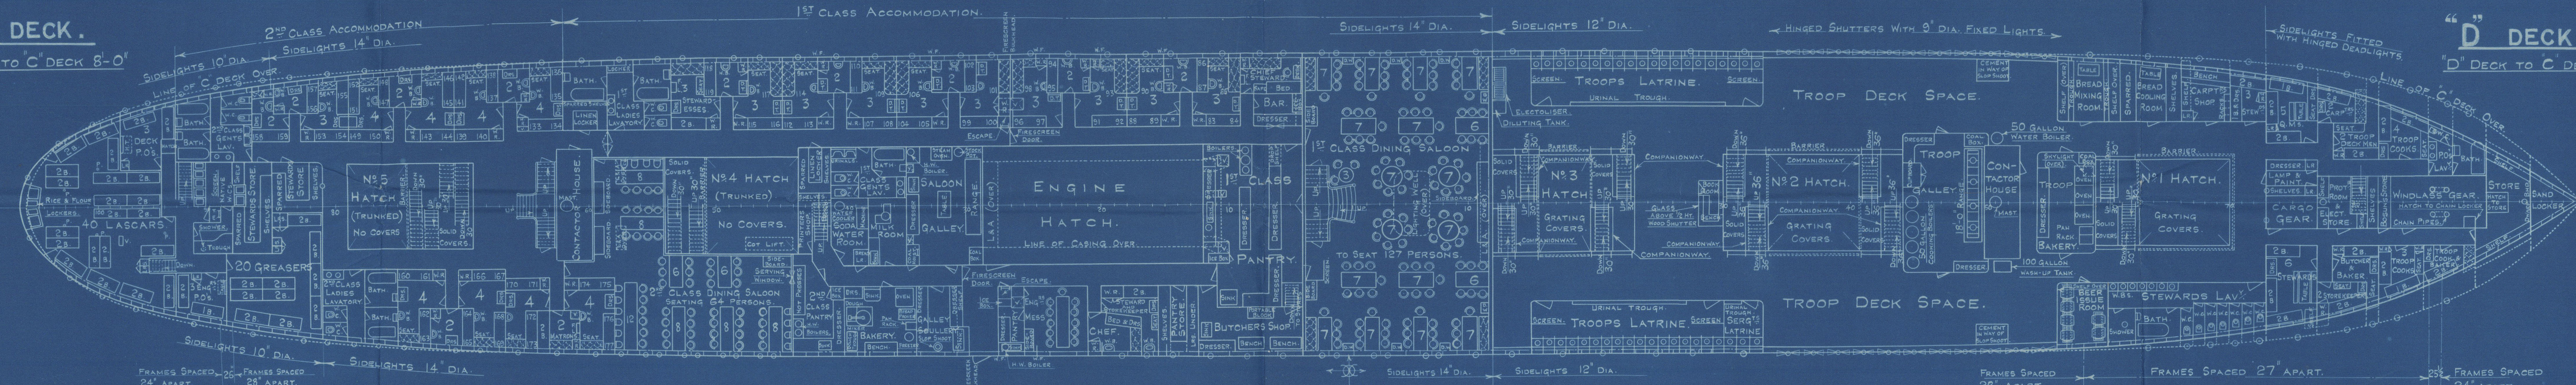

"E" DECK.

"E" DECK TO "D" DECK 8'-0"


EXCEPT IN WAY OF ENGINE CASING.

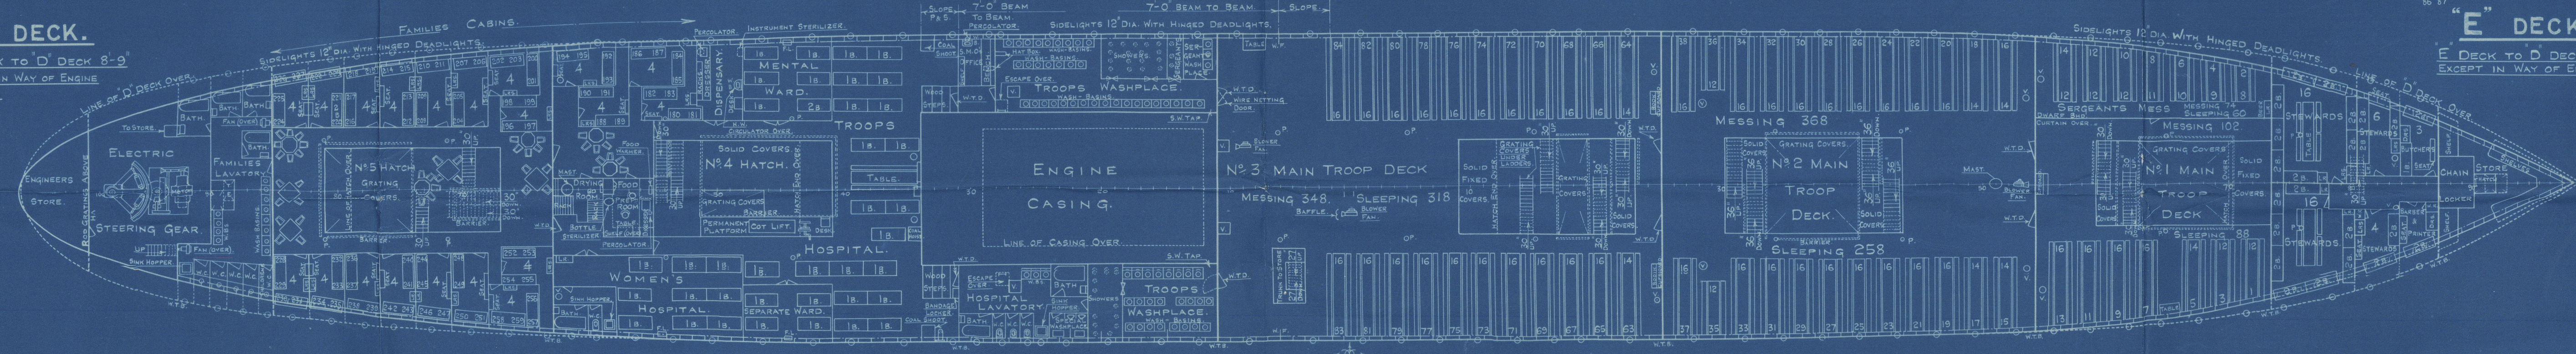


"F" DECK.

"F" DECK TO "E" DECK 10'-0"


EXCEPT IN WAY OF ENGINE CASING.

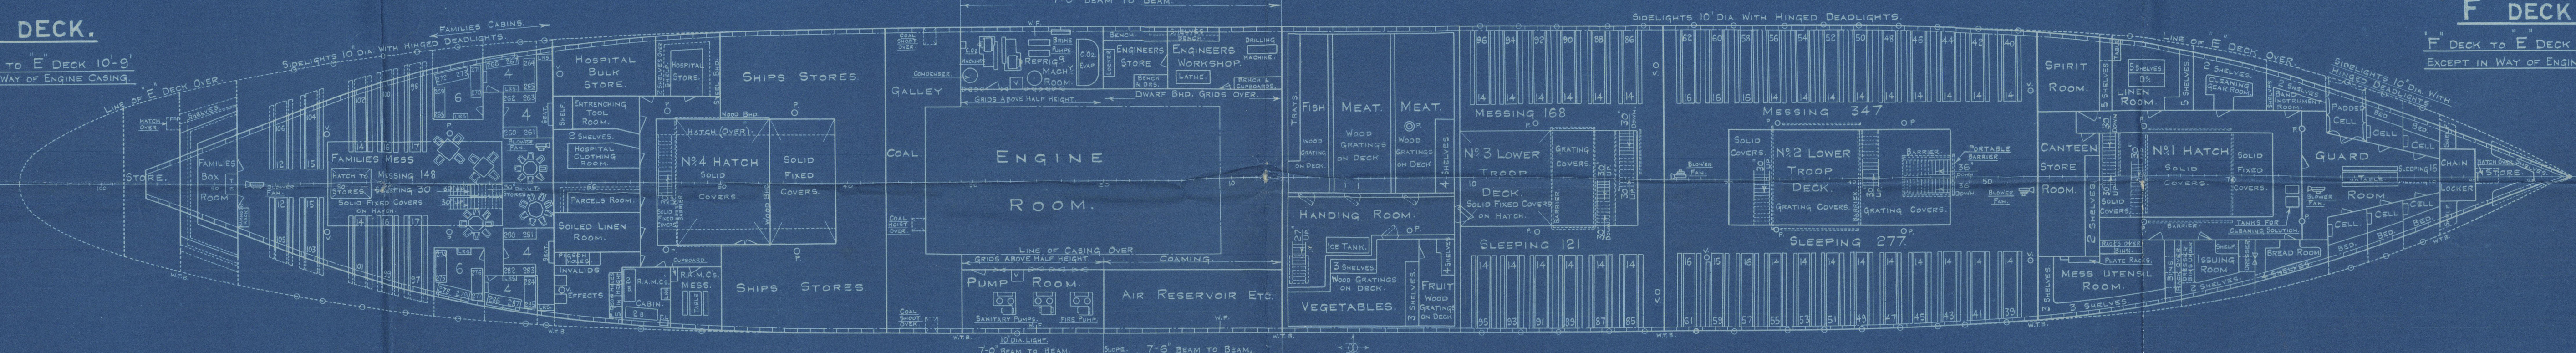


TUNNEL DECK.

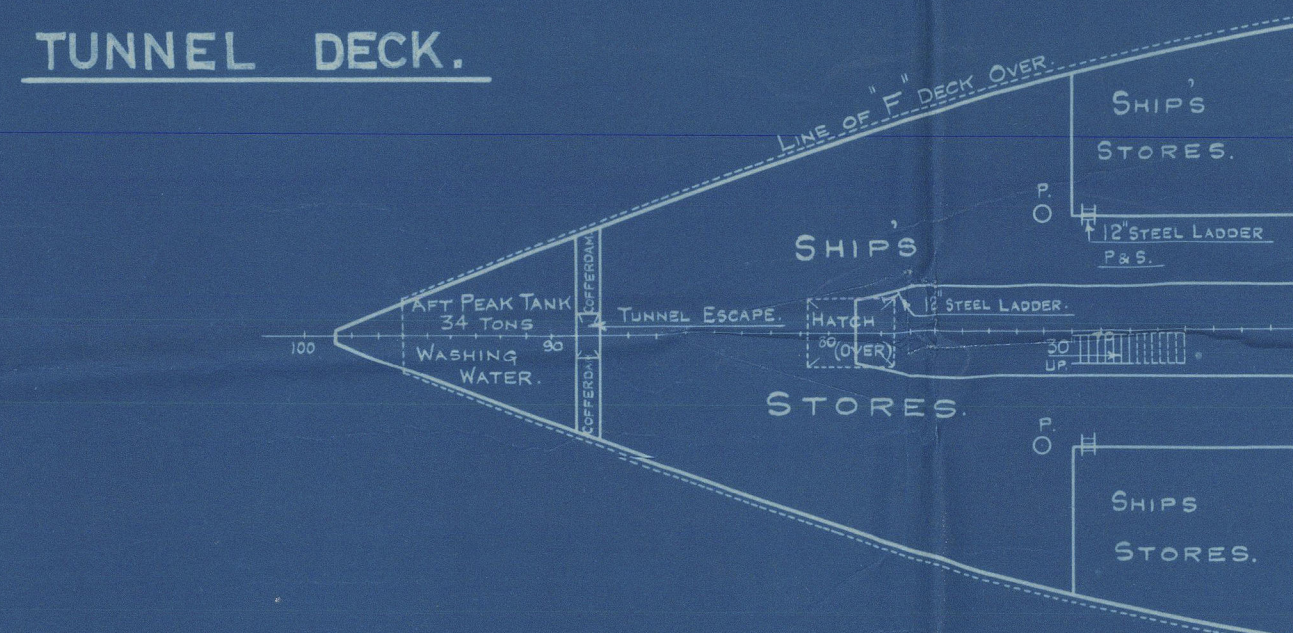

HOLD.

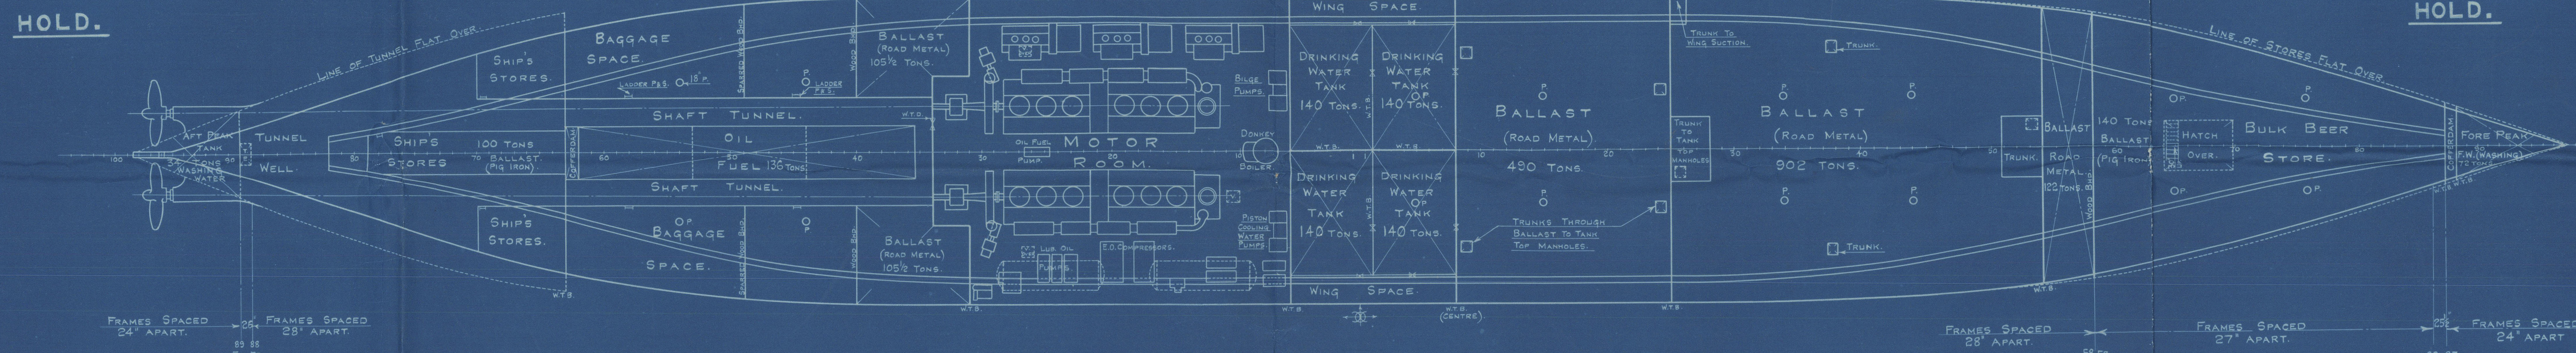

TANKS IN DOUBLE BOTTOM.

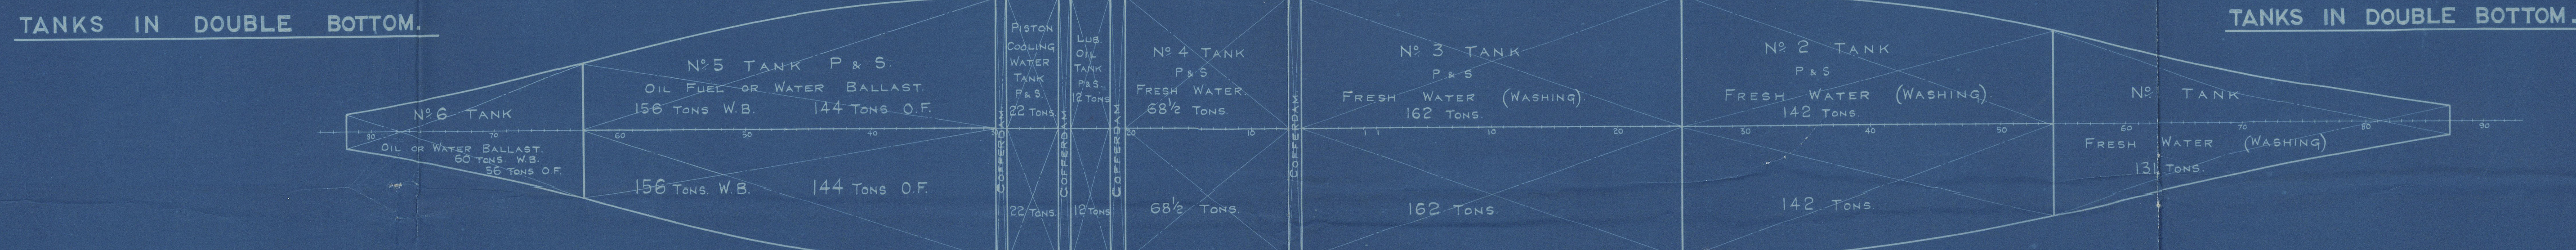

DECK COVERINGS.

- "D" DECK.
- 2" PITCH PINE ON EXPOSED DECK BETWEEN FRG. 12 & 73 FORWARD.
 - 2" PITCH PINE IN 1ST & 2ND CLASS CABIN ACCOMMODATION, ALSO POLE ACCOMMODATION.
 - CEMENT & GRANITE CHIPPINGS WITH RUBBLING IN 1ST & 2ND CLASS DINING SALOONS.
 - TILES IN 1ST & 2ND CLASS LAVATORIES, P.O.'S LAV. PANTRIES, BAR, SODA WATER ROOM, MILK ROOM, BAKERS SHOP, GALLERY, BUTCHERS SHOP.
 - GRANOLITHIC IN TROOPS LAVINER, STEWARDS LAV., BREAD ROOMS, BEER ISSUE ROOM, AND CARPENTERS WORKSHOP.
 - 2 1/2" GRADE TEAK IN NATIVE CREWS QUARTERS AFT.
 - WOOD GRATINGS ON DECK IN LINEN LOCKERS, STORES, & PRINTERS SHOP.
 - CEMENT IN NATIVE CREWS LAVATORY.

- "E" DECK.
- NON-SLIP TILES IN FAMILIES LAVATORY, HOSPITAL LAVS., AND FOOD PREPARATION ROOM.
 - GRANOLITHIC IN TROOPS WASHPLACES.
 - WOOD GRATINGS ON DECK IN DYING ROOM.
 - BASE STEEL IN STEERING GEAR SPACE AND FORE PEAK STORE.

- "F" DECK.
- 2" GRASS PINE IN TROOP SPACES, FAMILIES MESS, P.A.M. OF CABIN AND MESS, GUARD ROOM AND CELLS.
 - GRATINGS ON DECK IN STORE ROOMS.

"D" DECK.

"D" DECK TO "C" DECK 8'-0"

"E" DECK.

"E" DECK TO "D" DECK 8'-0"

EXCEPT IN WAY OF ENGINE CASING.

"F" DECK.

"F" DECK TO "E" DECK 10'-0"

EXCEPT IN WAY OF ENGINE CASING.

STORES FLAT.

8'-0" PARALLEL TO "F" DECK AT SIDE.

HOLD.

TANKS IN DOUBLE BOTTOM.

'Somersetshire' & 'Dorsetshire'

General Arrangement

Dorsetshire. Son. 14520

RETAIN



© 2020

Lloyd's Register
Foundation

W164-0217