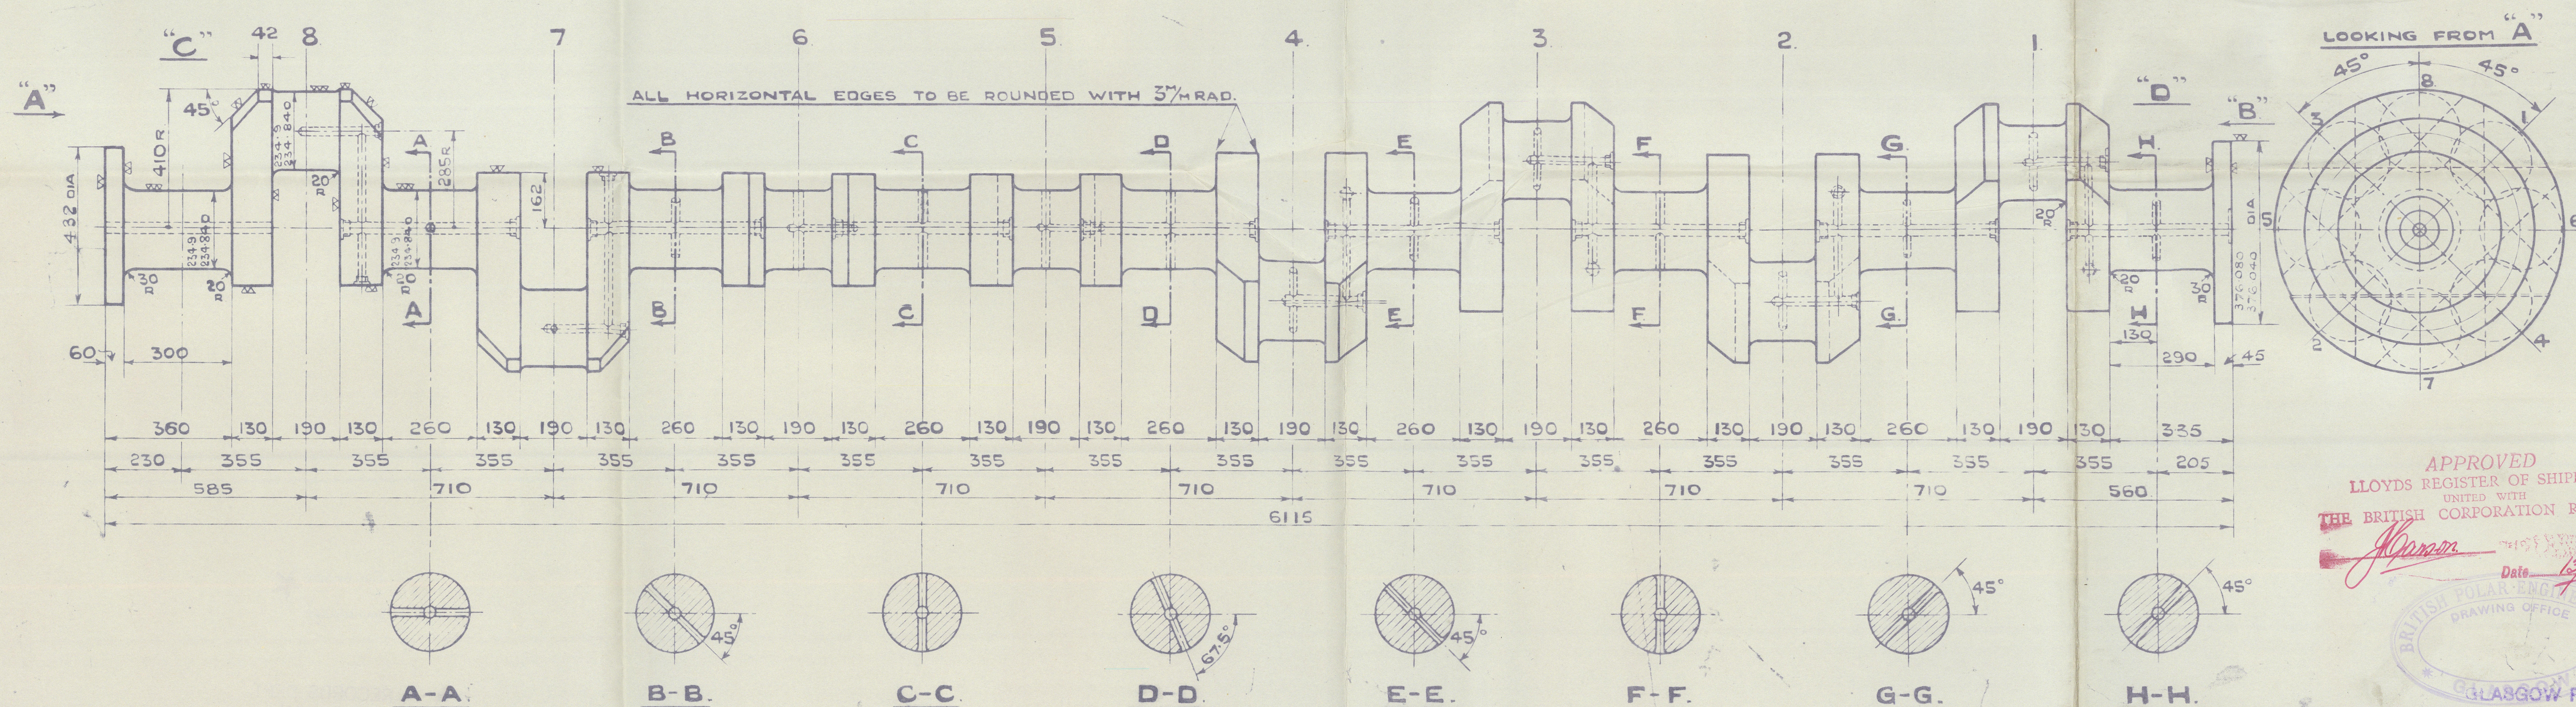
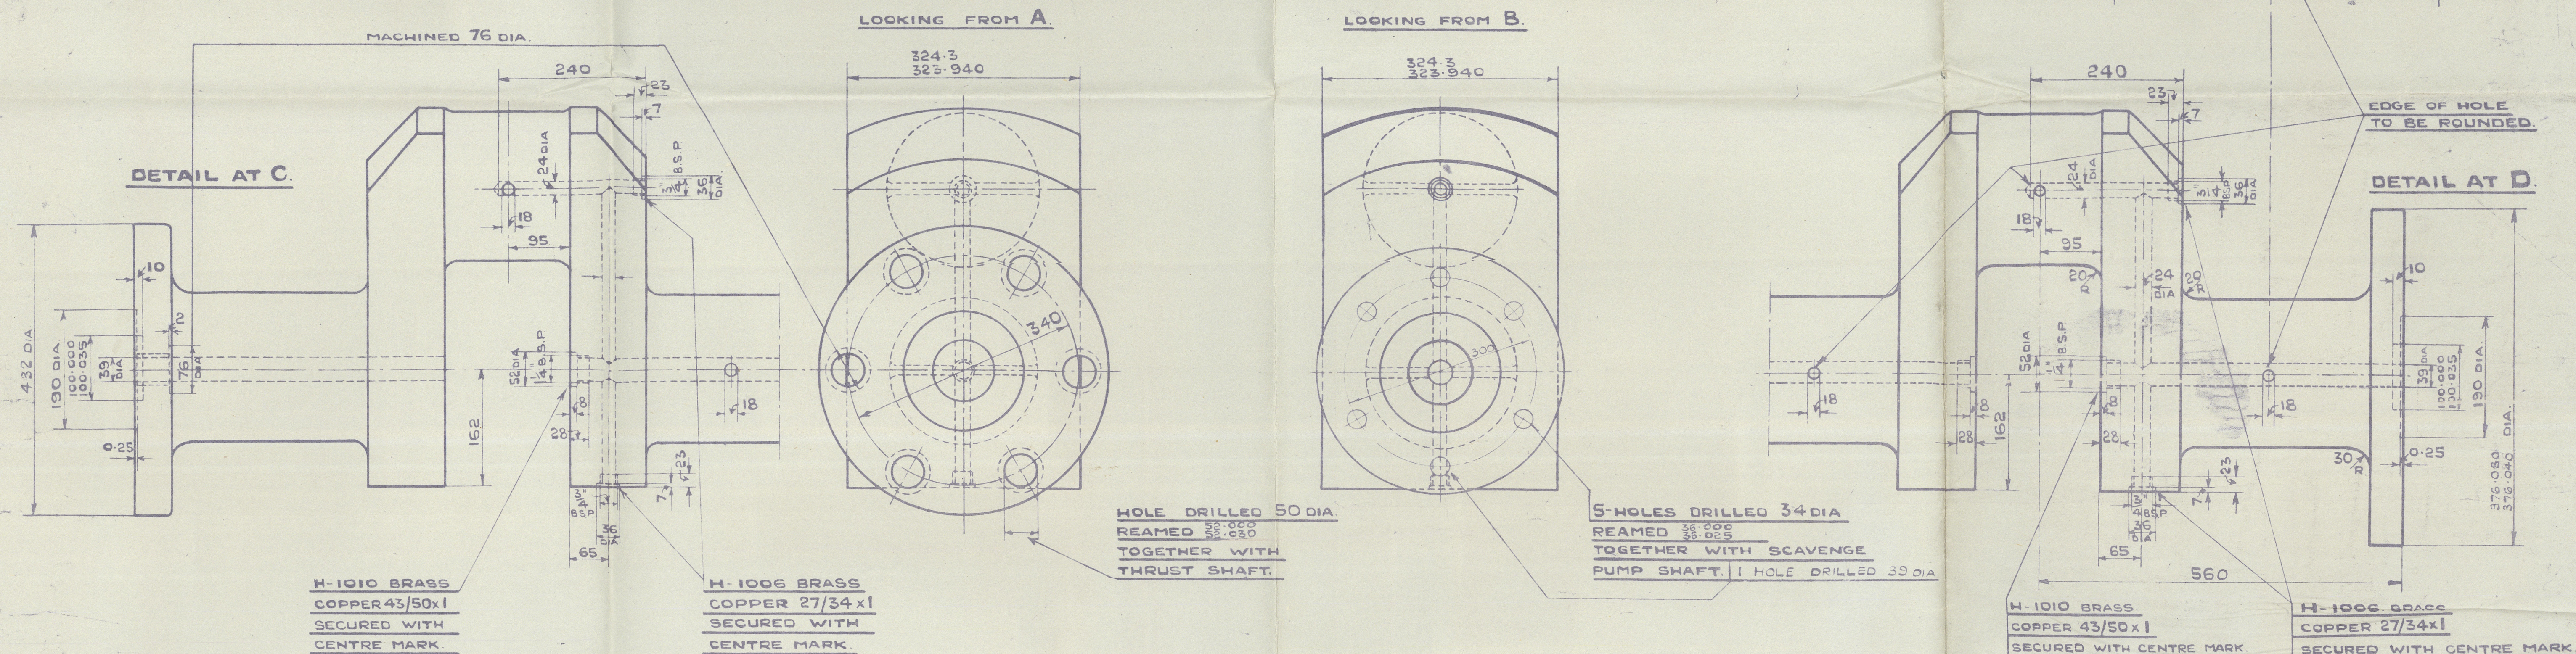


[illegible]

TEST PIECE NO. 1. TAKEN FROM EACH END OF SHAFT.

ULT. TENSILE STRENGTH	32/36 TONS/IN ²
YIELD POINT	NOT LESS THAN 18 TONS/IN ²
ELONGATION PLUS U.T.S. TO BE NOT LESS THAN	57.
COLD BEND TEST	180° ON 1/4" RADIUS.

APPROVED
LLOYDS REGISTER OF SHIPPING
UNITED WITH
THE BRITISH CORPORATION REGISTER

James Date 12/3/52

GLASGOW REPORT No 79405


SURVEYOR'S COPY.

CRANKSHAFT

ITEM NO M8A324. MAT-FS. SCALE-1:10-1:15.

DR'G. Nº 1M8A324

© 2021
Lloyd's Register
Foundation

'GUILDFORD' 
brankshaft.

RECORDS DEPT.
LONDON

9

RETAIN



© 2021

Lloyd's Register
Foundation

W1648-0021