

13-12-27

MIDSHIP SECTION

OF

KETCH-RIGGED YACHT

OF

COMPOSITE CONSTRUCTION.

SCALE 1" = 1 FOOT.

EQUIPMENT.

TWO ANCHORS OF $1\frac{1}{4}$ & $\frac{3}{8}$ CWTs. EX STOCK.
 15 FATHOMS $\frac{1}{16}$ " CHAIN CABLE.
 60 FATHOMS $3\frac{1}{2}$ " HEMP HAWSER.
 60 FATHOMS $2\frac{1}{2}$ " HEMP HAWSER.

BUILT TO LLOYD'S CLASS 18 A. 1 AS FOLLOWS:-


12 YEARS FOR MATERIAL.

2 YEARS FOR MIXED MATERIALS.

1 YEAR IF BUILT UNDER ROOF.

3 YEARS IF ALL FASTENINGS OF NAVAL
 BRASS.

18 YEARS TOTAL.

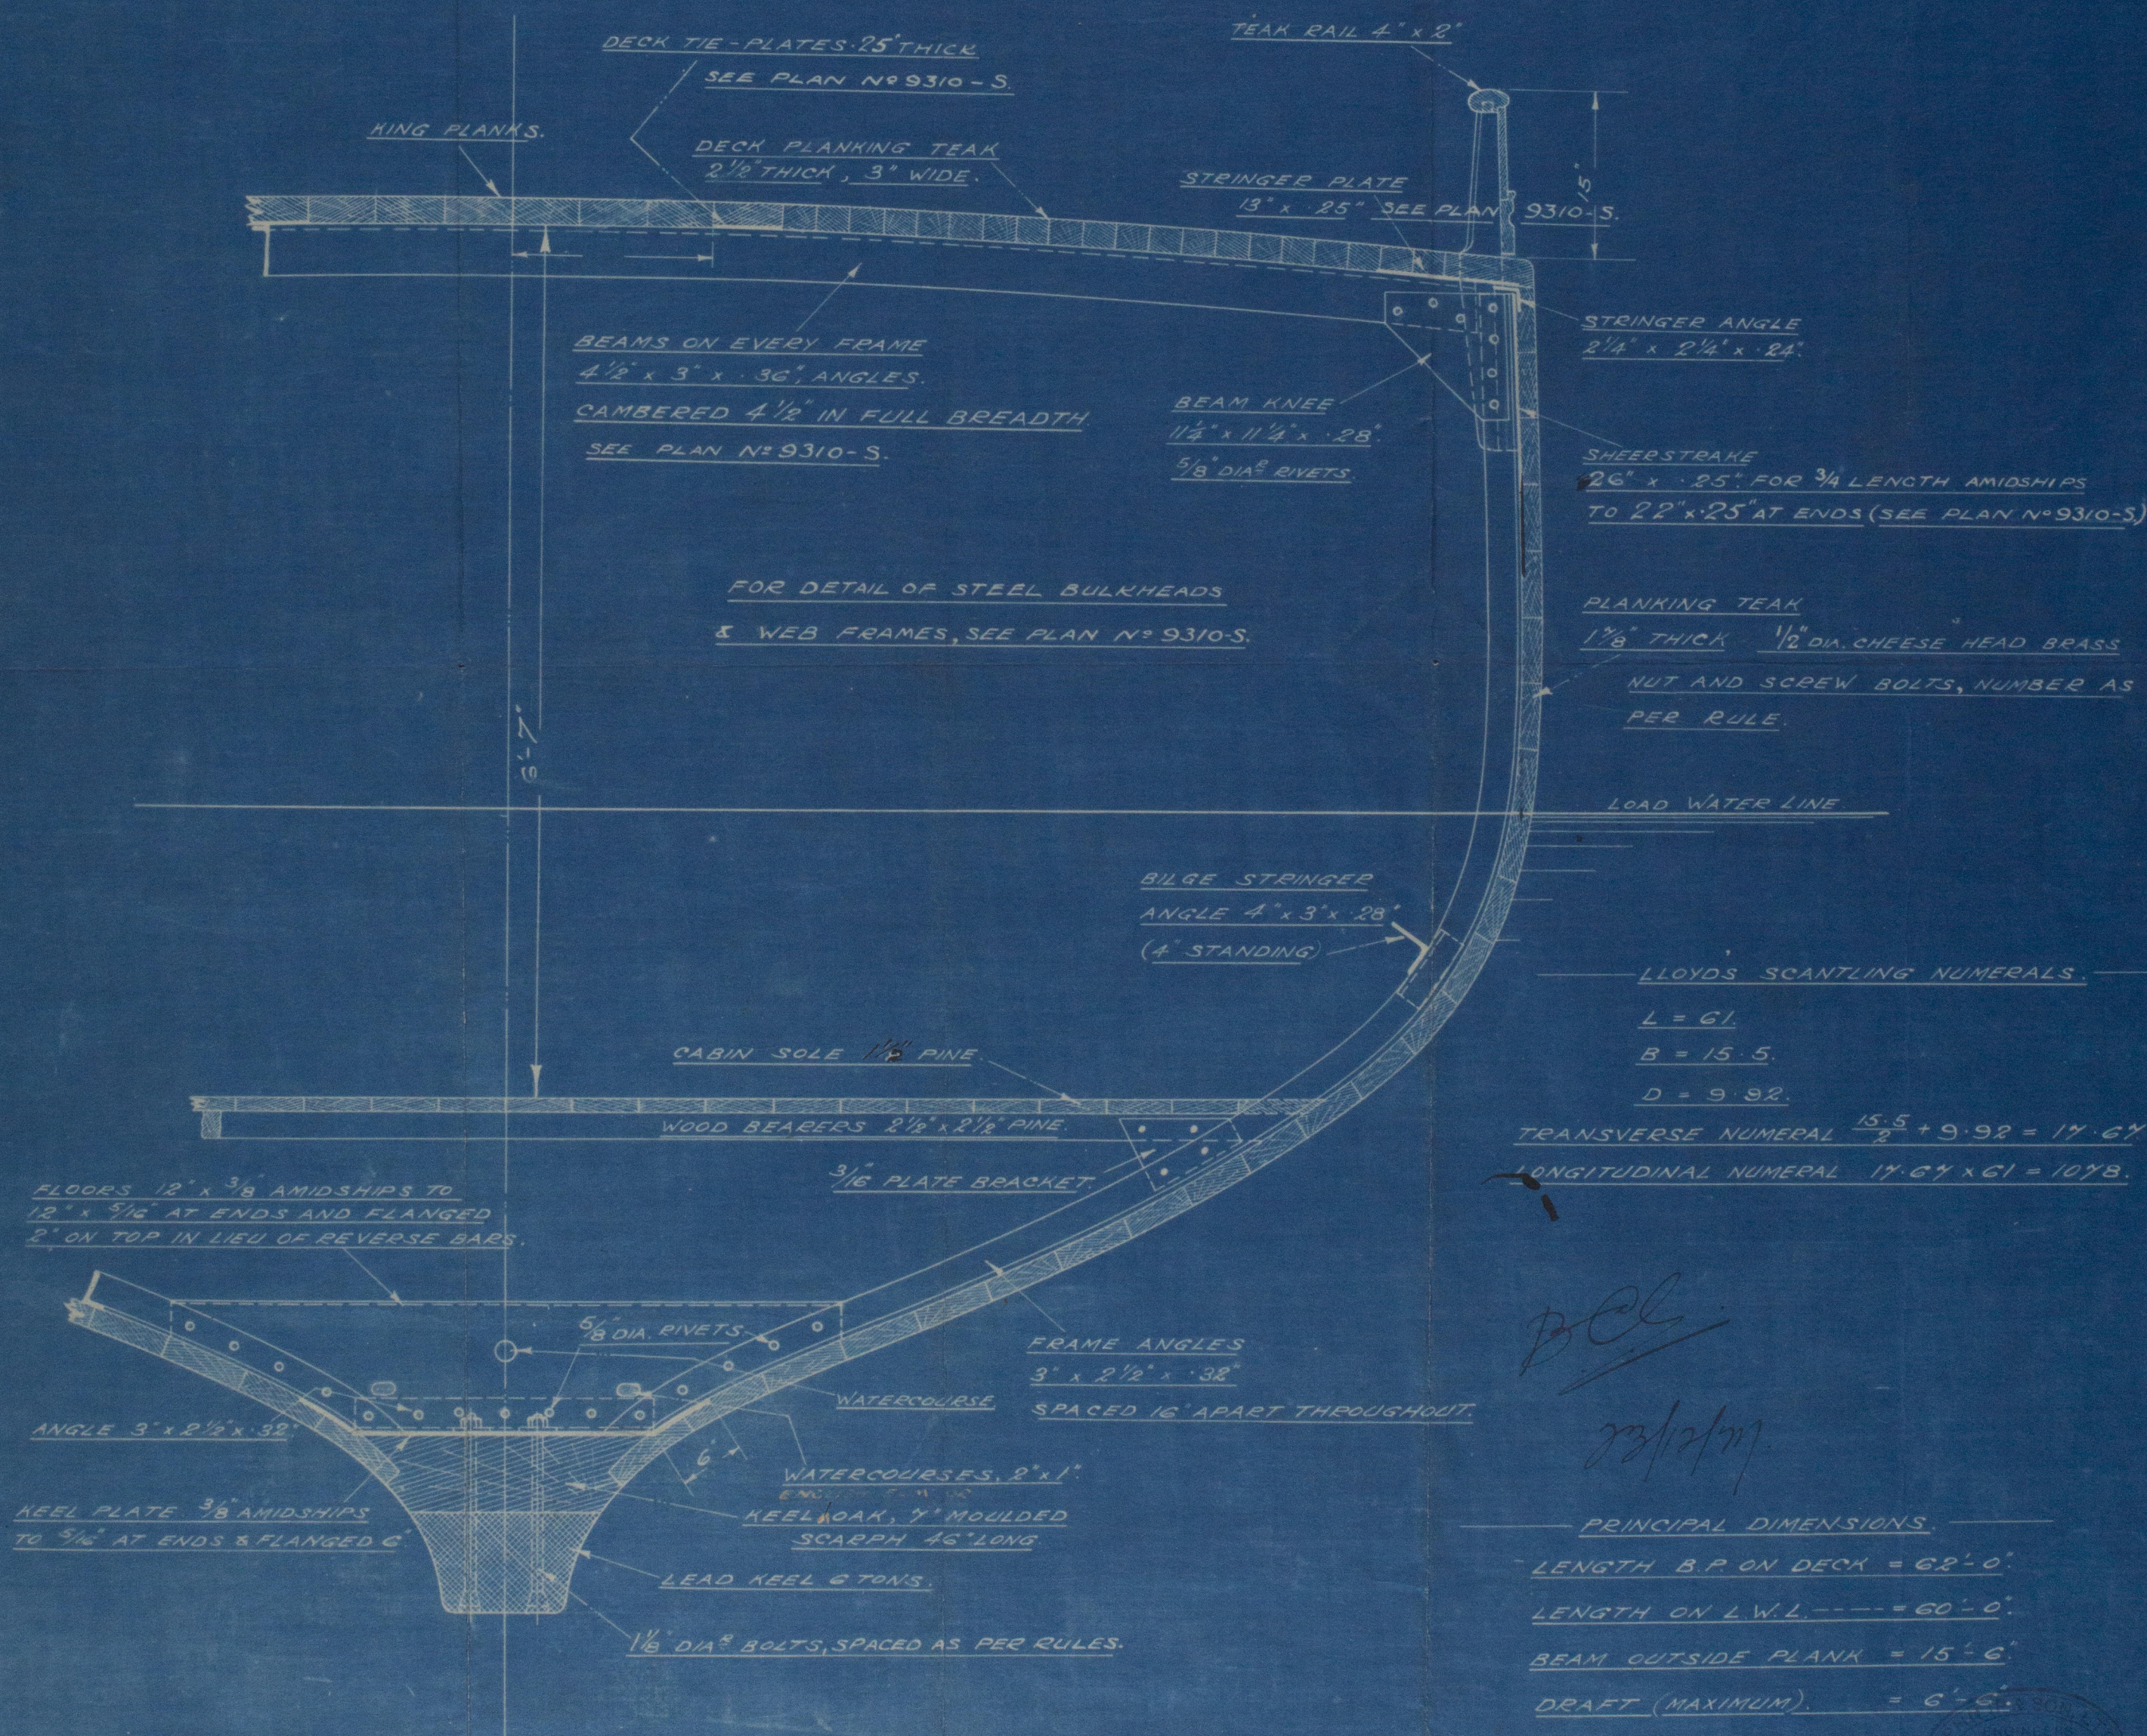

LLOYD'S SCANTLING NUMERALS.

L = 61.

B = 15.5.

D = 9.92.

TRANSVERSE NUMERAL $\frac{15.5}{2} + 9.92 = 17.67$

LONGITUDINAL NUMERAL $17.67 \times 61 = 1078$.


PRINCIPAL DIMENSIONS.

LENGTH B.P. ON DECK = 62'-0".

LENGTH ON L.W.L. --- = 60'-0".

BEAM OUTSIDE PLANK = 15'-6".

DRAFT (MAXIMUM) = 6'-6".

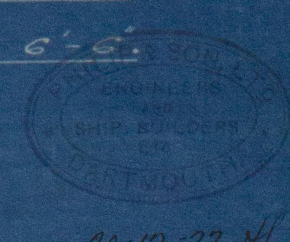


DES N° 9298-S

3-12-27

BOAT N° 727.



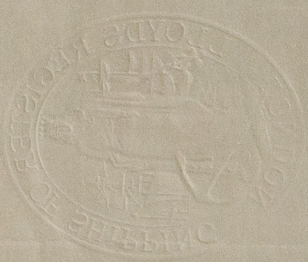


W1648-0046

RETAIN

Philip's Yard No 727

Midship section

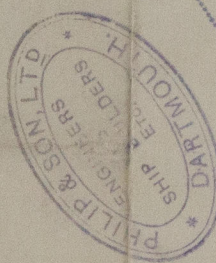

© 2021

Lloyd's Register
Foundation