

# PROPOSED CONVERSION.

## SAILING BARGE TO MOTOR COASTER.

SCALE:  $\frac{1}{4}$  = ONE FOOT

FELLOWS & COMPANY LTD.

SHIPBUILDERS

SOUTHAM

GREAT YARMOUTH




1. 3. 38.

### DIMENSIONS.

LENGTH B.P. 91'-0"

BREADTH M.L.D. 23'-0"

DEPTH M.L.D. 9'-6"

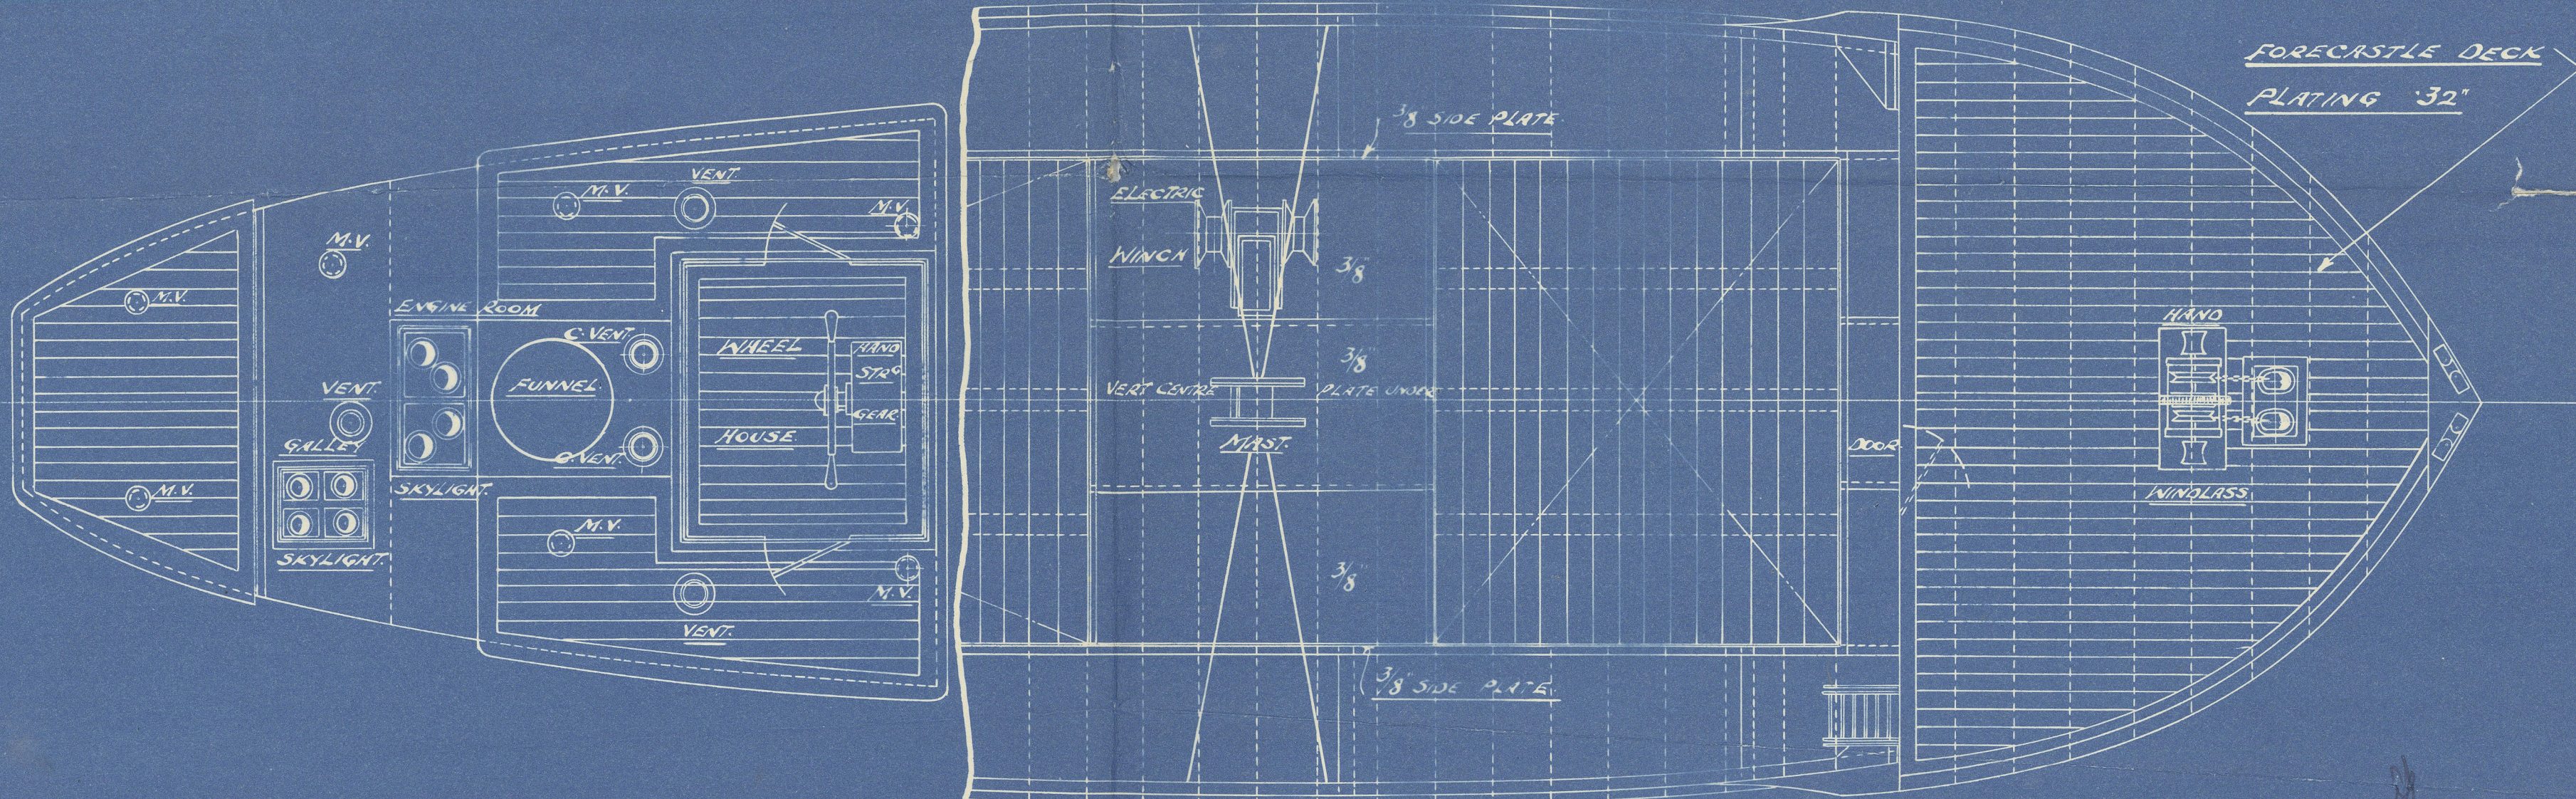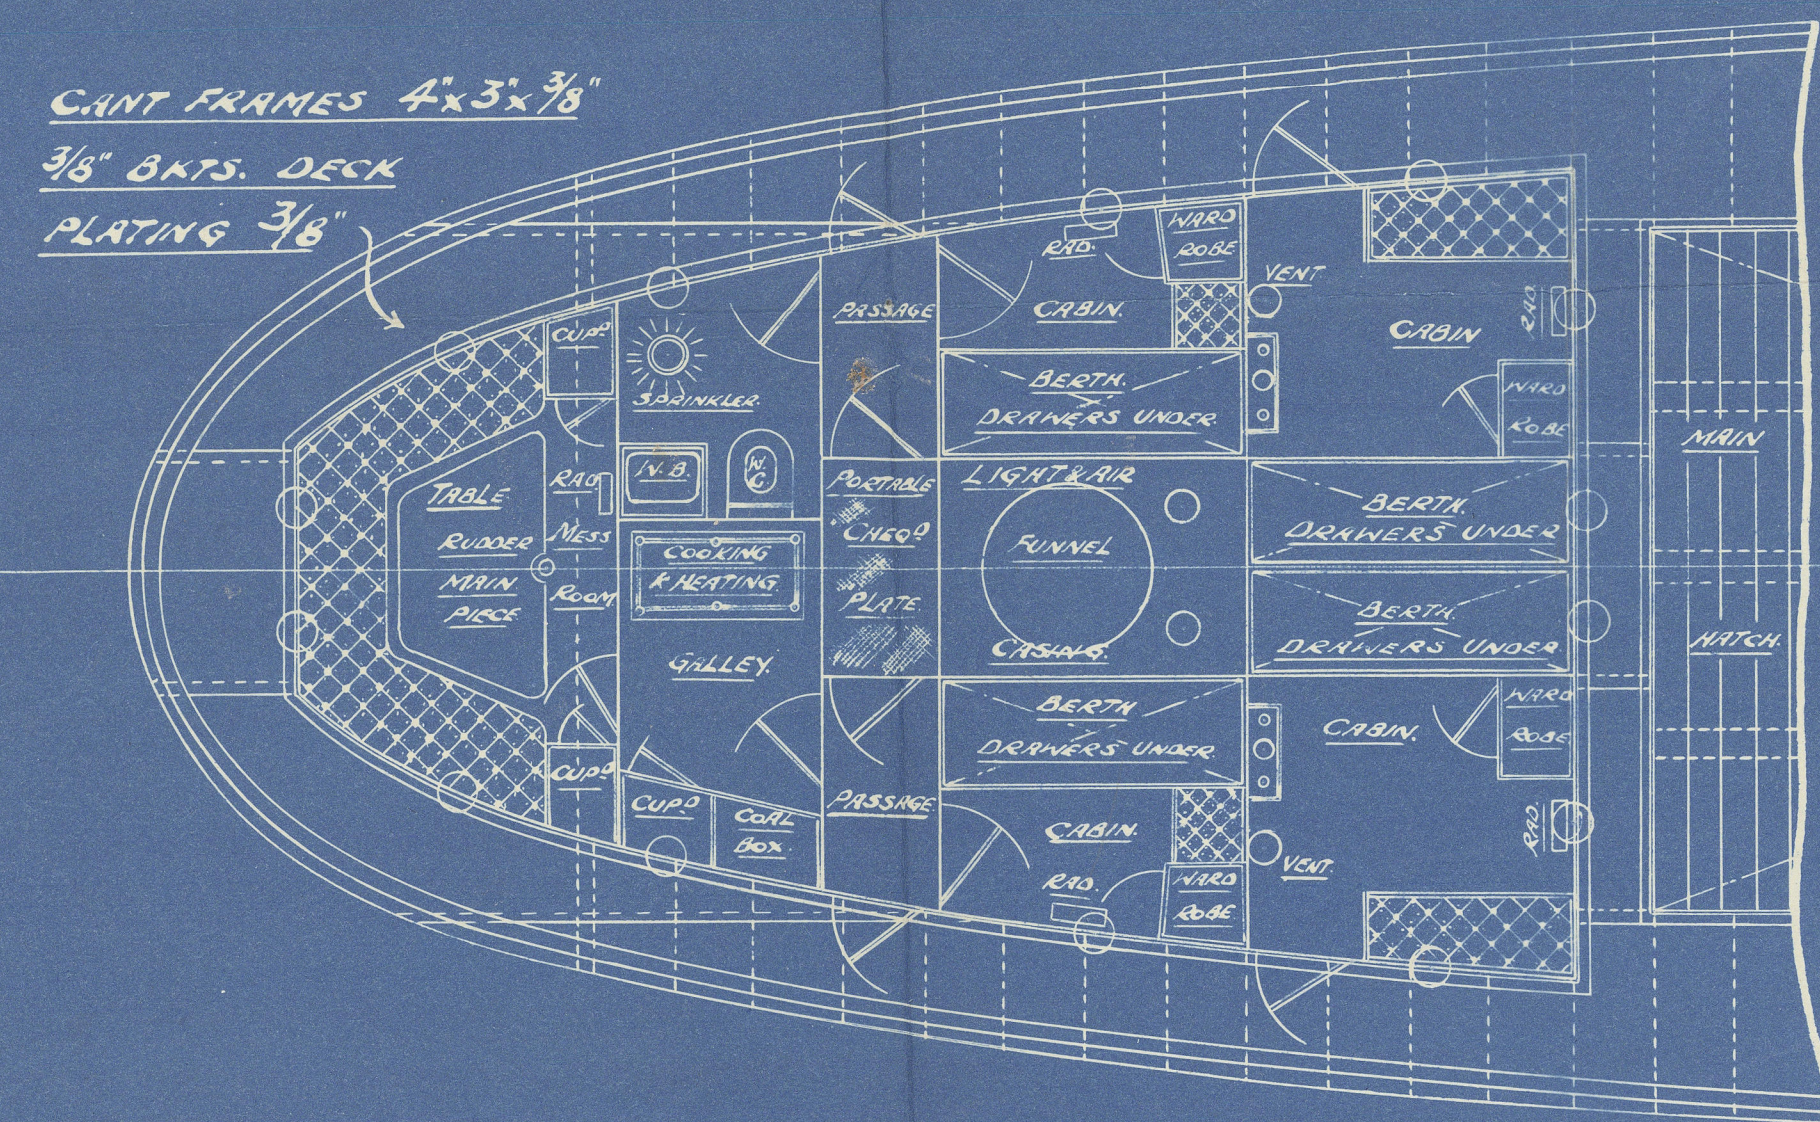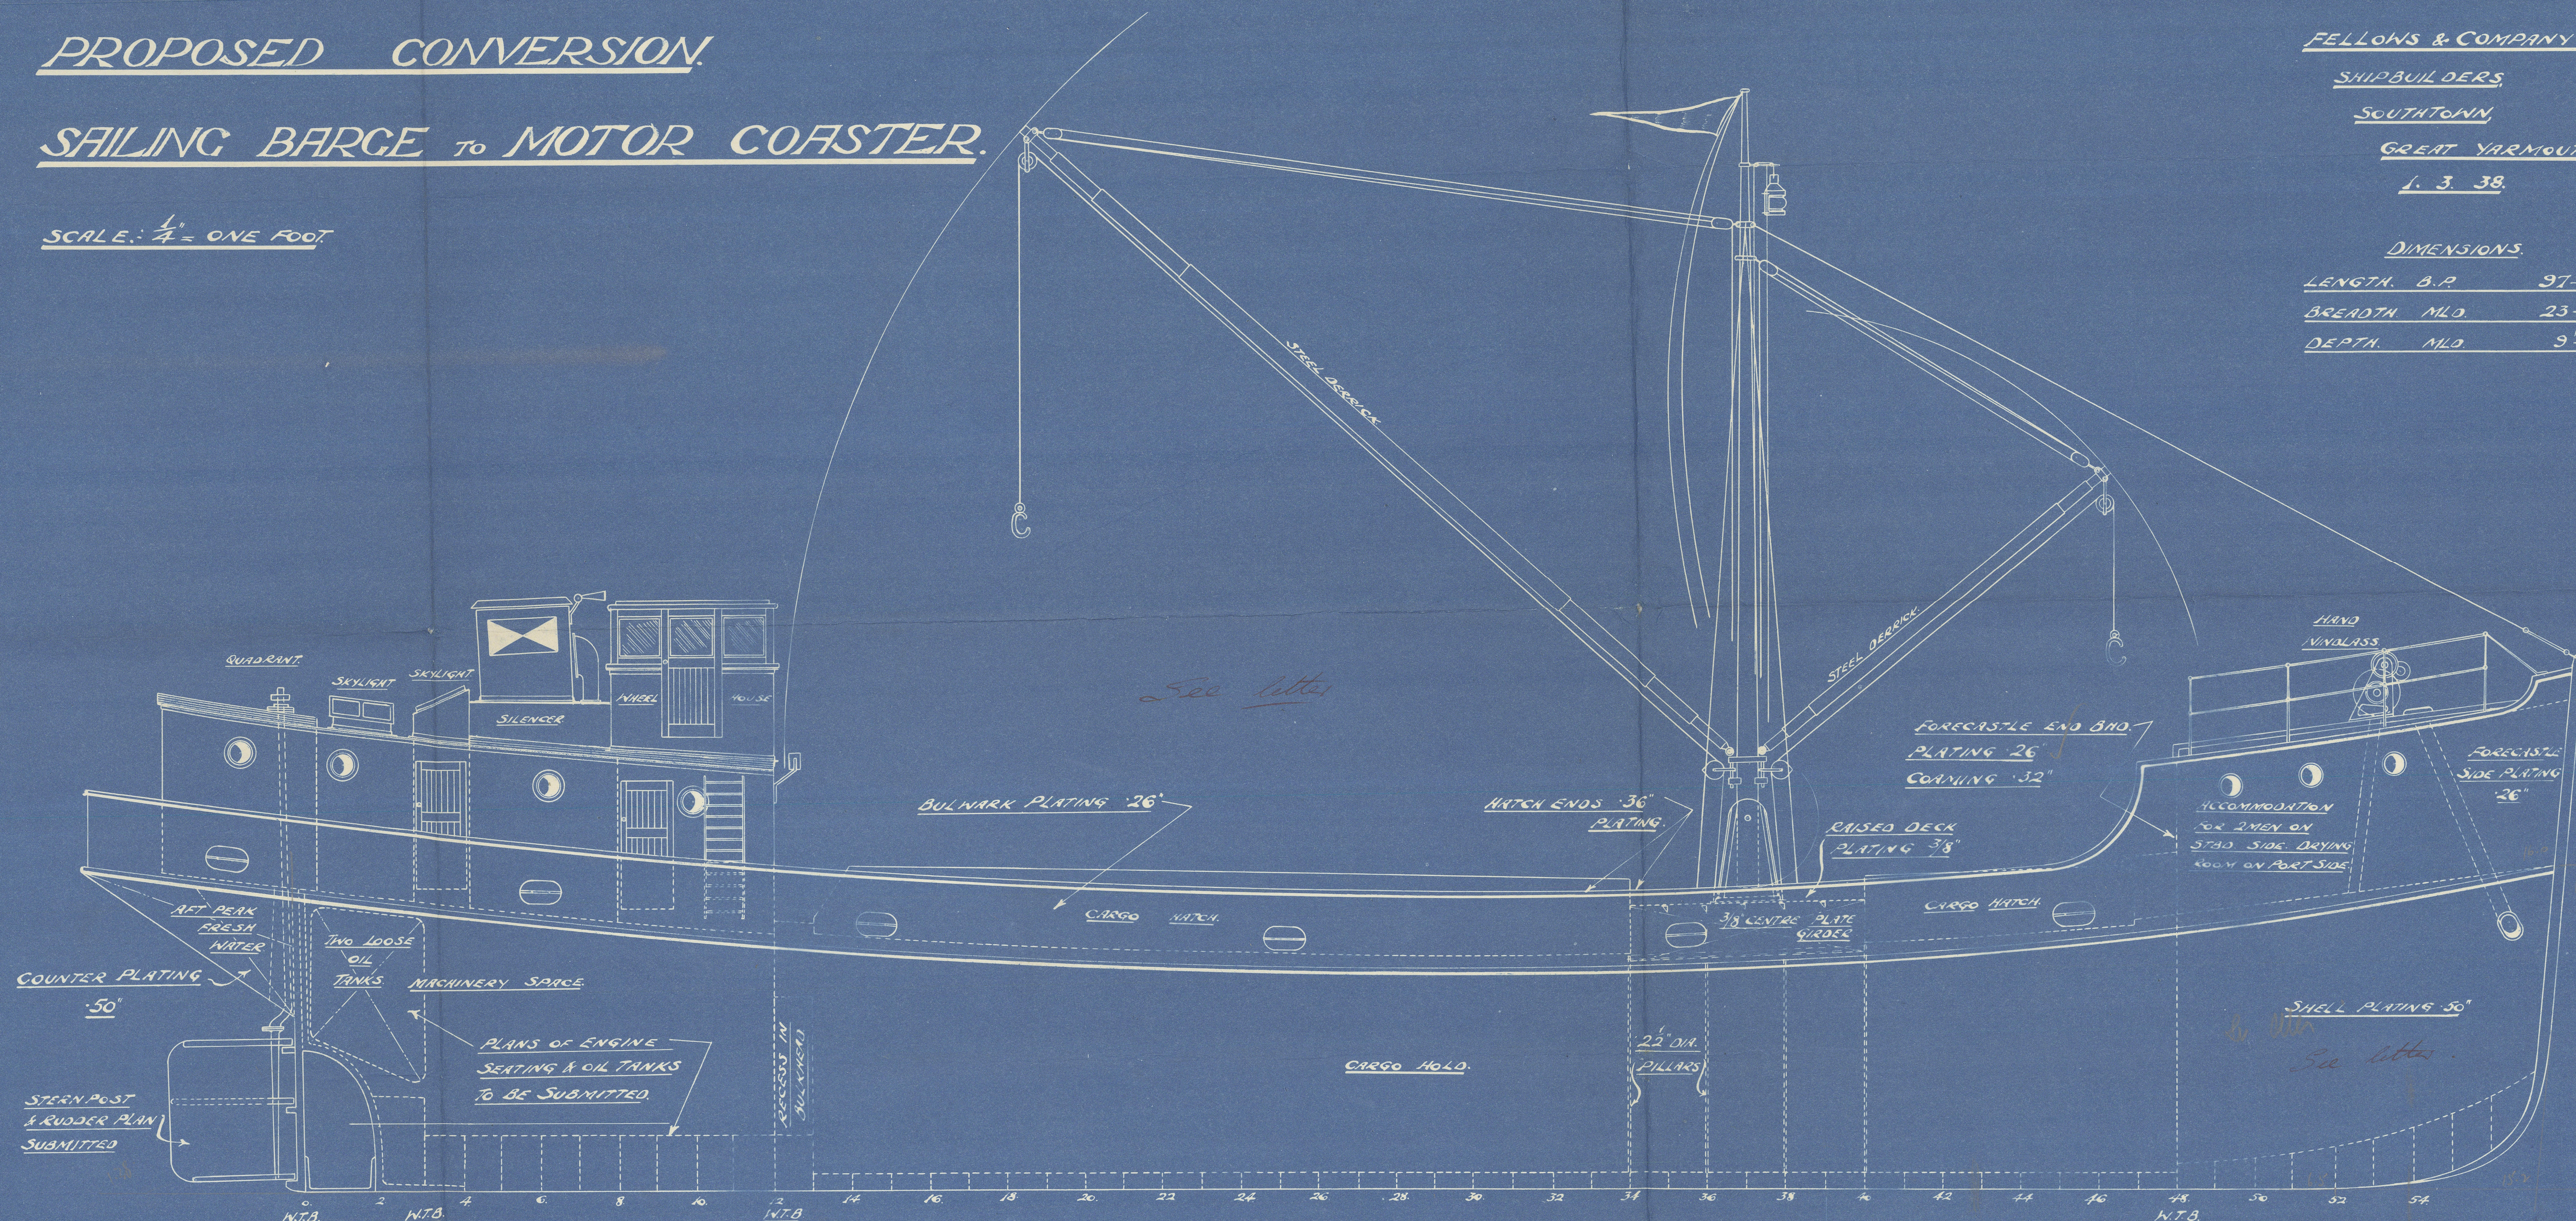

1. 3. 38.



Sailing Barge

"FRED EVERARD"

Proposed alterations  
to a Motor Coaster.

London Rpts 106514

106790

RETAIN



© 2021

Lloyd's Register  
Foundation

W1648+0245