


# PROFILE & DECKS.

LENGTH B.P. 385'0".  
 BEAM EXTREME 52'0".  
 DEPTH MOULDED 29'6".  
 TO CLASS B.S.\*. BRITISH CORPORATION.  
 SCALE 8 TO 1 FOOT.

27 MAY 1914

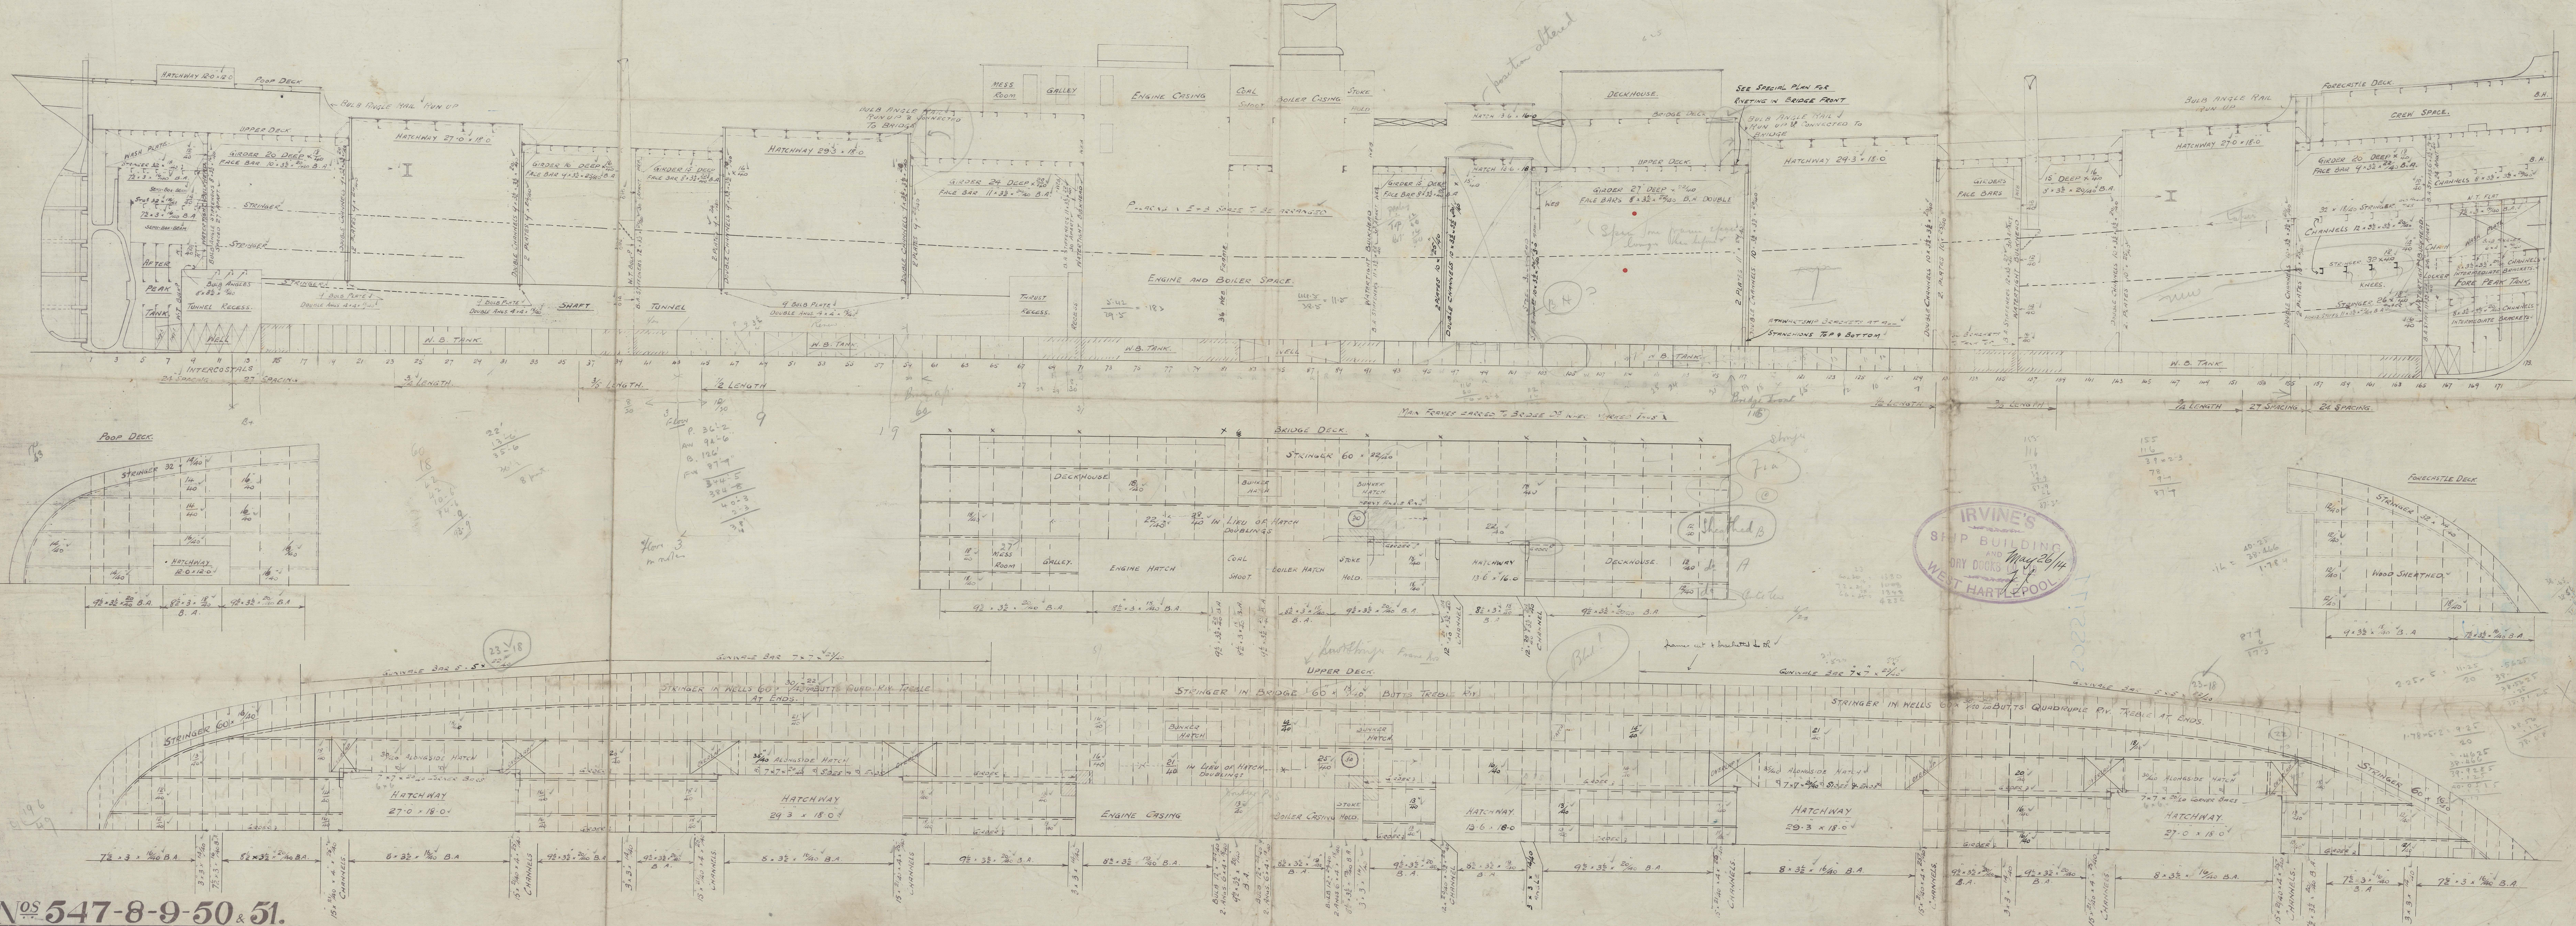

IRVINE'S  
 SHIP BUILDING  
 AND  
 DRY DOCKS  
 WEST HARTFORD POOL

NOS 547-8-9-50 & 51.



Irvins 547-8-9-50-1

Profile & Deck

★ ILISSOS

385' x 52' x 29' 6"

Cloth Copy

ILLOSSOS (LR. WRECK

SS.

Derwent River

now ILLOSSOS

Gambia River

AEAS,

Swan River

Sagama River NITSA

Gampian Range

now "Manchester Spinner"

RECORDS DEPT.  
LONDON

3

RETAIN

LR

© 2021

Lloyd's Register  
Foundation