
  
 30.9.01

S.S. Iowa

No 349.  
 SECTIONAL ELEVATION (OF FORE END).  
 S-S. 500' x 58' x 45'-9" KEEL TO DECK.  
 Scale 1/8" = 1 FOOT.

AMENDED PLAN SHOWING LOWER ORLOP DECK BEAMS  
 IN No 2 HOLD DISPENSED WITH WEB FRAMES FITTED.

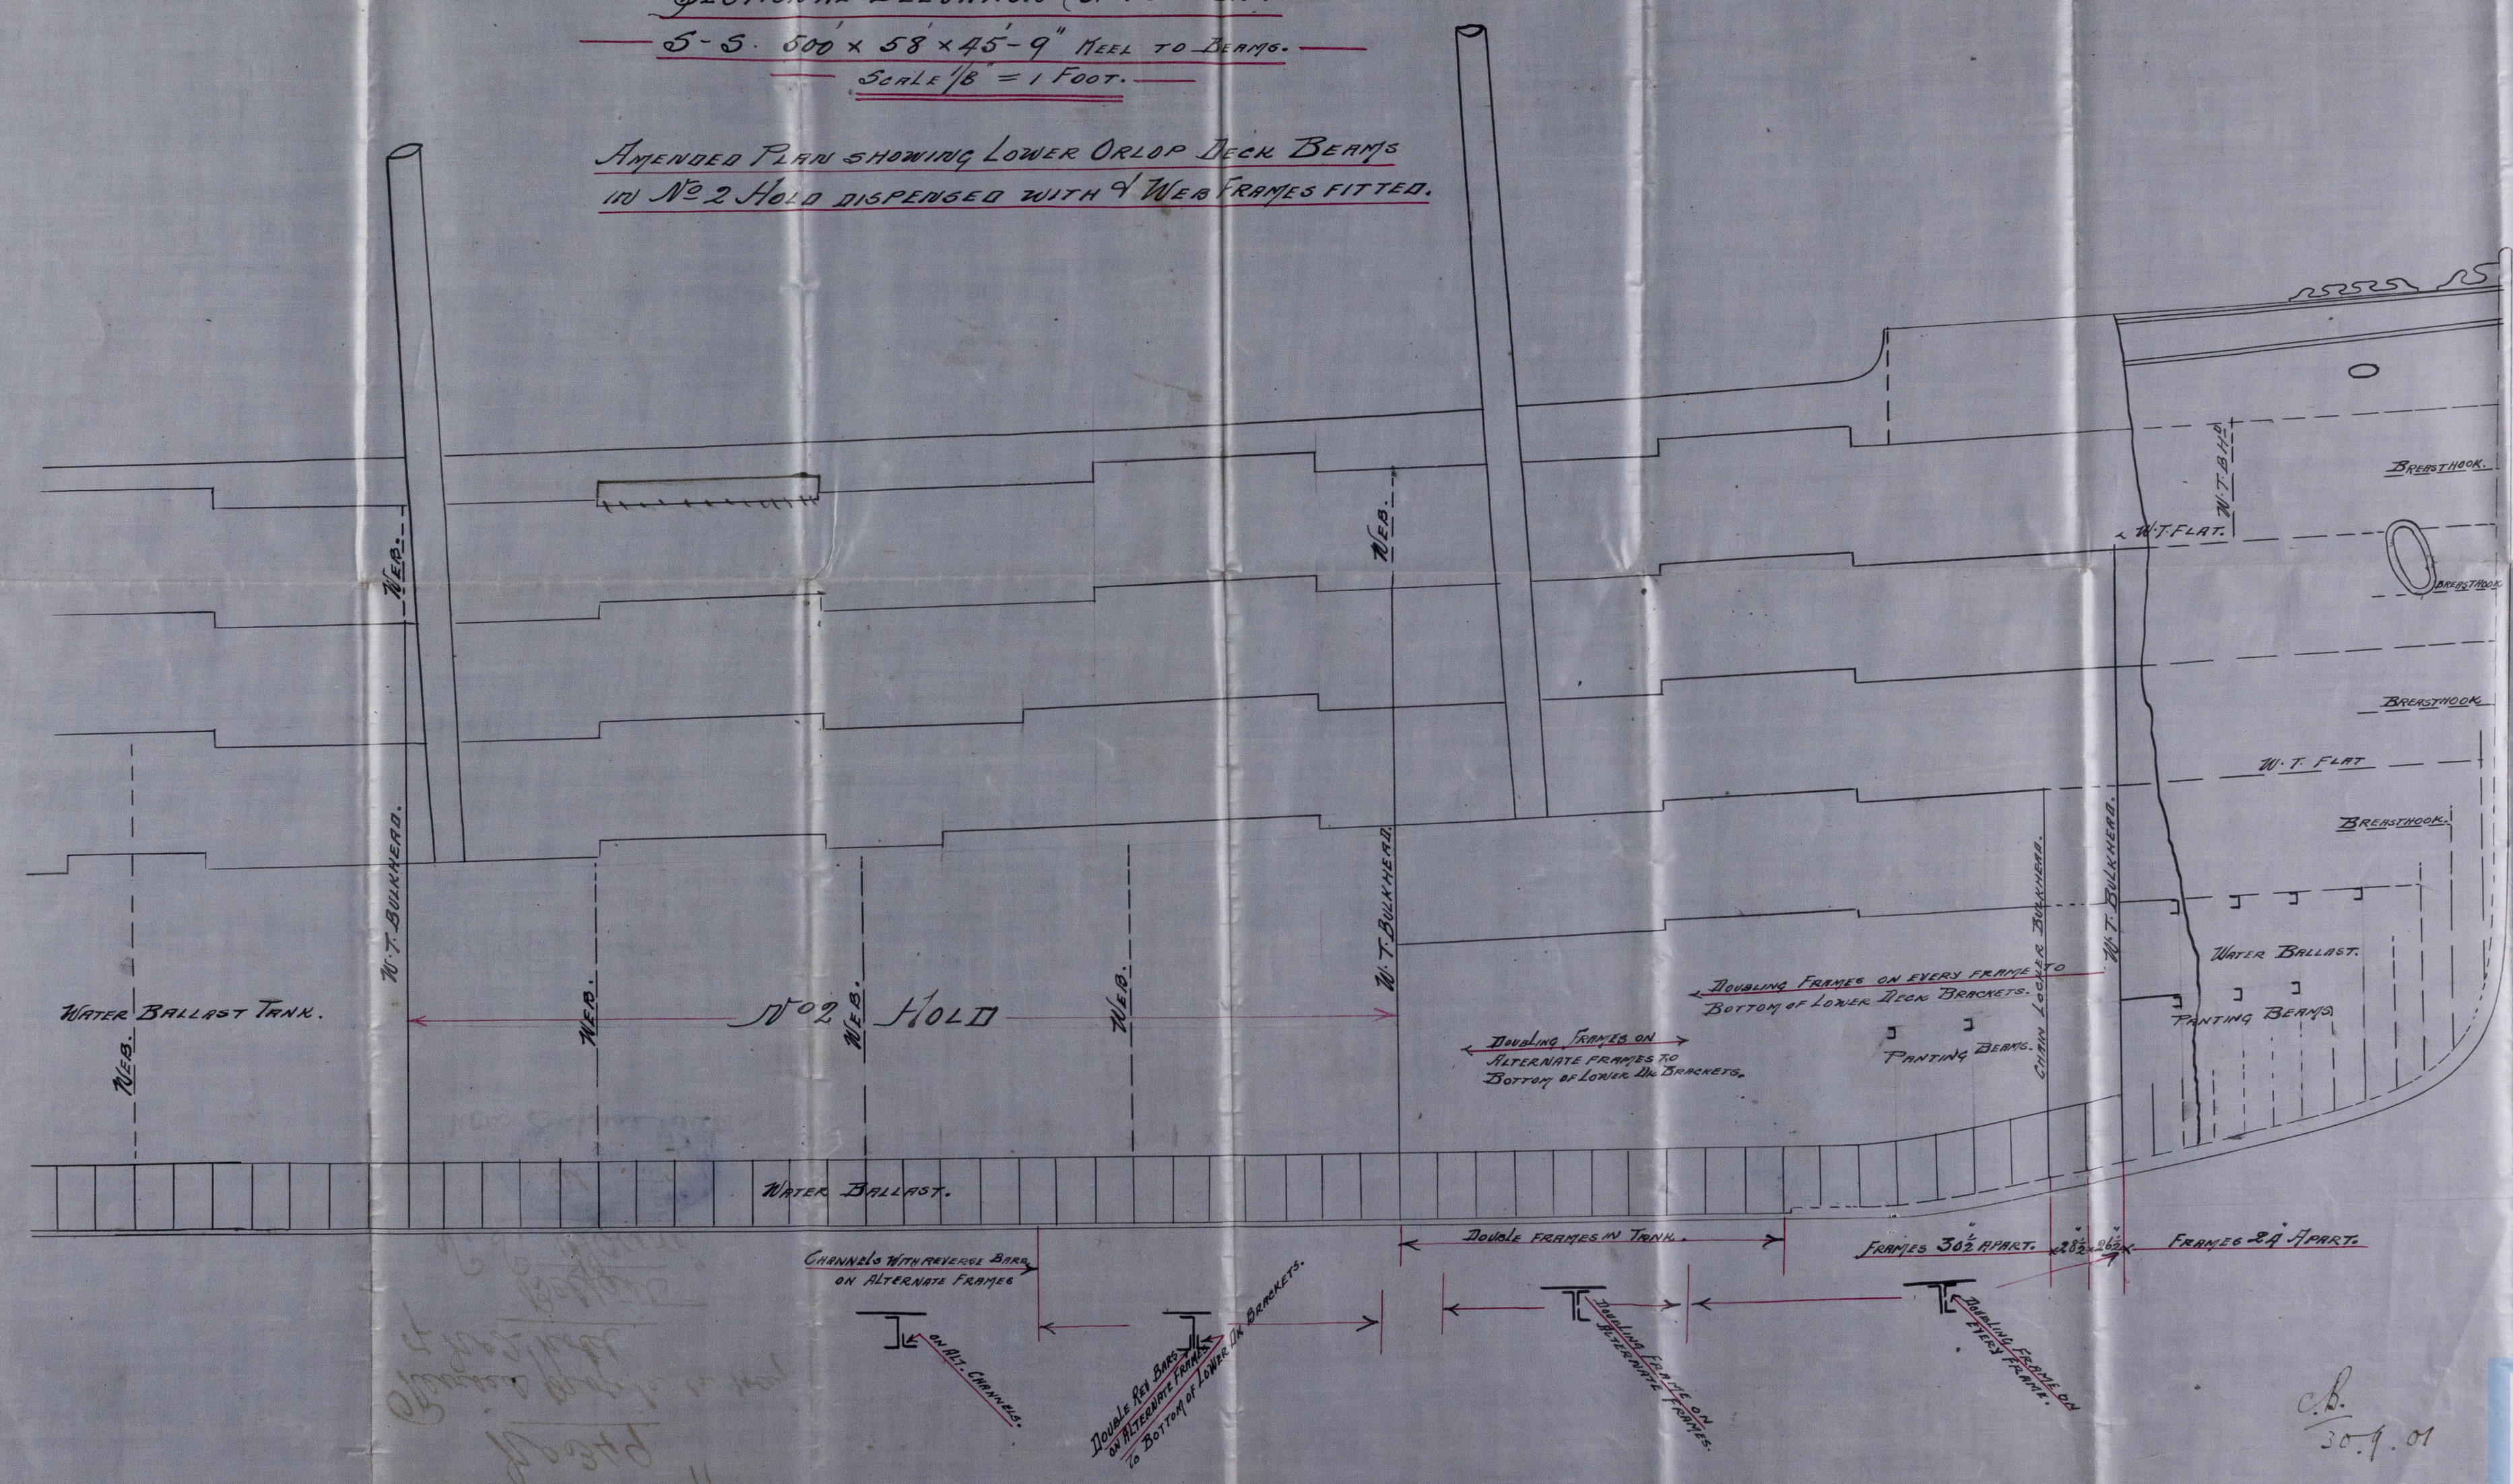

LLOYD'S REGISTER  
 OF SHIPPING  
 LONDON  
 25.9.01

  
 Lloyd's Register  
 of Shipping  
 LONDON



Harland & Wolff  
No 349

Revised profile in way  
of No 2 hold

Belfast  
S. S. Louisa

LOYD'S REGISTER OF SHIP  
Rel. 5509  
SEP 1889

now Empire Bitten

W165-0025

LR

© 2021

Lloyd's Register  
Foundation