

(588) 11.5.20  
8.11.20.

# N<sup>os</sup> 587-8 MIDSHIP SECTION

DIMENSIONS: 600' 73' 44" K to B.  
SCALE: 1/8" = 1 FOOT


## NUMERALS

B + D	35 67 + 73	108 67
L x (B + D)	108 67 x 600	65 202
d	44 16 (10.5 + 8.0 + 4.92)	20 74
1/2 (at Long Bridge)	600 61 18	9 80
1/2 (Fore of Long Bridge)	600 52 67	11 39

To CLASS A.1 AT LLOYD'S  
SHELTER DECK WITH FREEBOARD

## EQUIPMENT NUMBER

L x (B + D)	65 202
SHELTER Dk	3600
FORECASTLE Dk	372
BRIDGE Dk	4050
PROMENADE Dk	2240
HOUSES	1875
TOTAL	77339

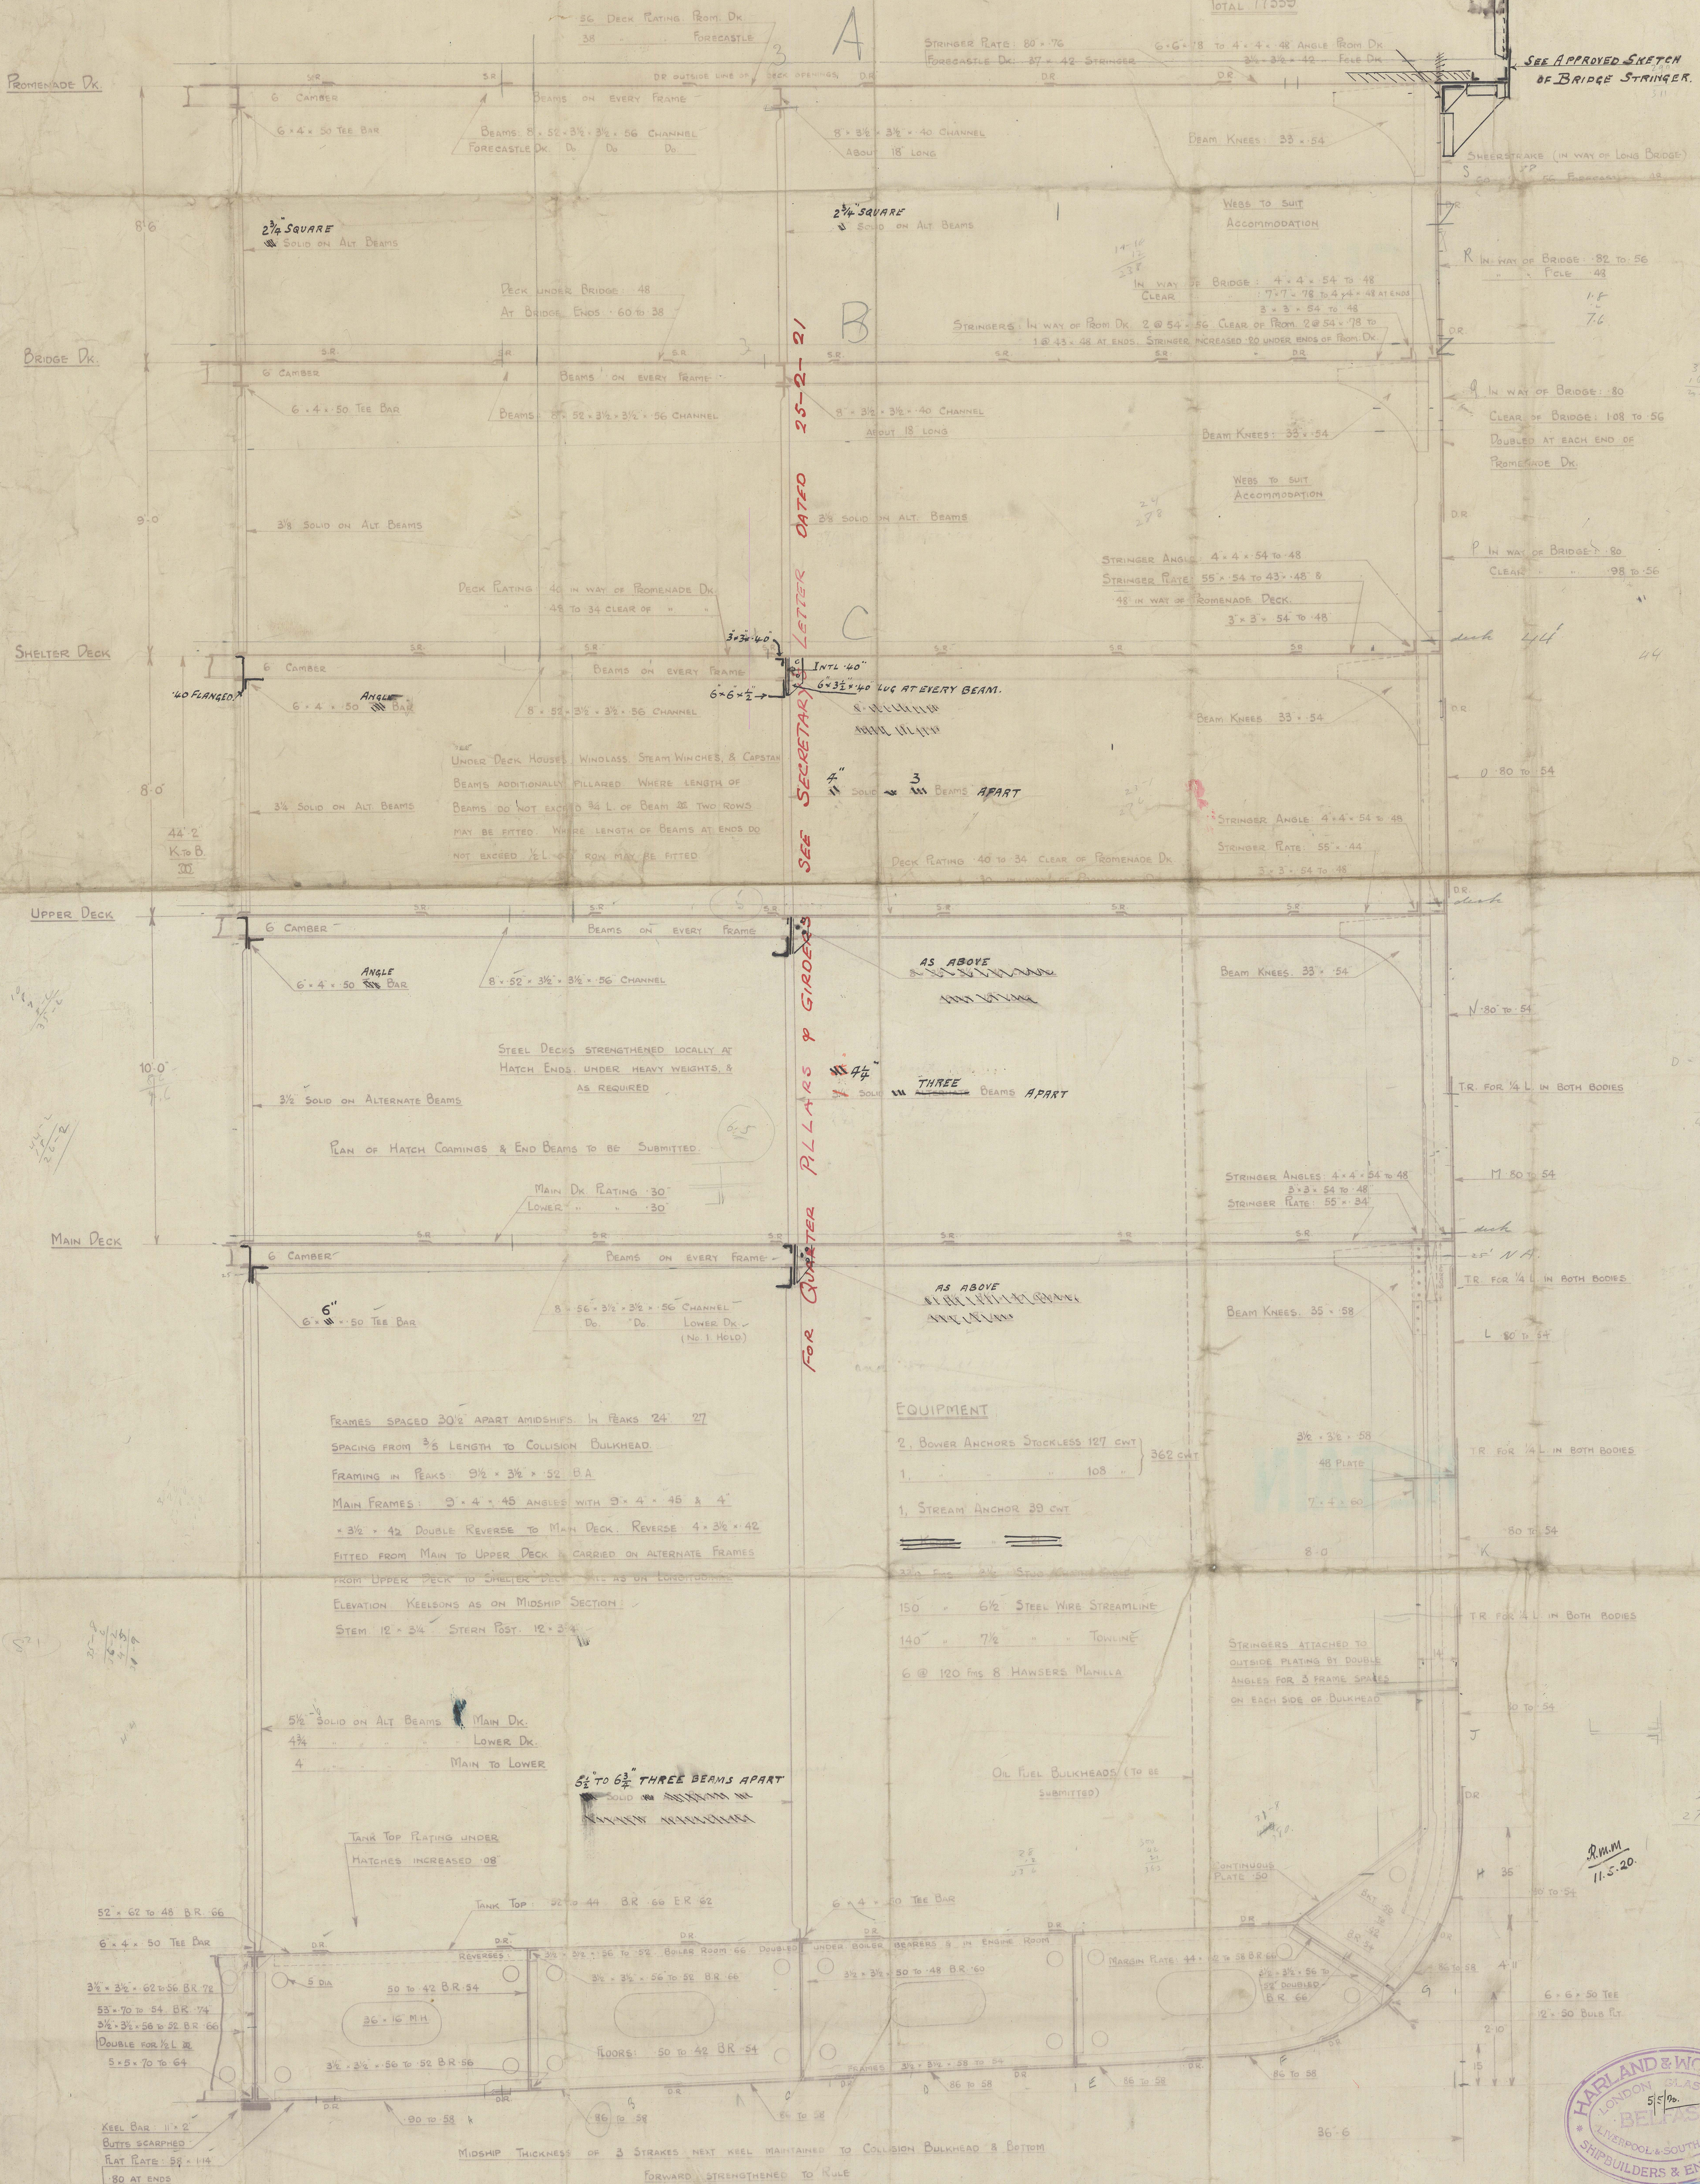



Harland & Wolff Ltd.

Nº 5-87.48

Midship Section

Amended

"Mooltan"  
Bel 8970.

"Malaja"  
Bel 8986

Di. E.



© 2021

Lloyd's Register  
Foundation

W1650-0387



Delivery book.

Wheeler R 532 1534

Curse box 3

Stephan Chetral 159

Wmoff ground 660-1





42-3  
9-0  
51-3