

L.P. 48 18179.

DRUM-BOILER FOR S.S. PALLAS, EX WELLPARK, BELONGING TO
HAGF. AKTIEBOL. PALLAS, GÖTEBORG.
SCALE 1/10 FULL SIZE. MILLIMETRE MEASURE.

NUMBER OF BOILER 1259.




16:10:06

TO LLOYD'S RULES:
WORKING PRESSURE 6 KG. PR. C/M = 85 LBS PR. SQ. INCH.
MATERIAL PRIME MARTIN STEEL.
MACHINE RIVETED WHERE POSSIBLE.
PLATES NOS. 1-5 AND RIVETS TO HAVE:
TENSILE STRENGTH 41-47 KG. PR. MM.²
ELONGATION IN 200 MM. 20-20 P.C.
SUM — 61-67
PLATES NOS. 6-8 AND STAYS TO HAVE:
TENSILE STRENGTH — 43-50 KG.
ELONGATION IN 200 MM. 20-20 P.C.
SUM — 63-70

Obs!

Denna ritning får ej kopieras, ej heller
göras tillgänglig för konkurrensfirmor.
GÖTEBORGS MEK. VERKSTADS
KONSTRUKTIONSBYRÅ

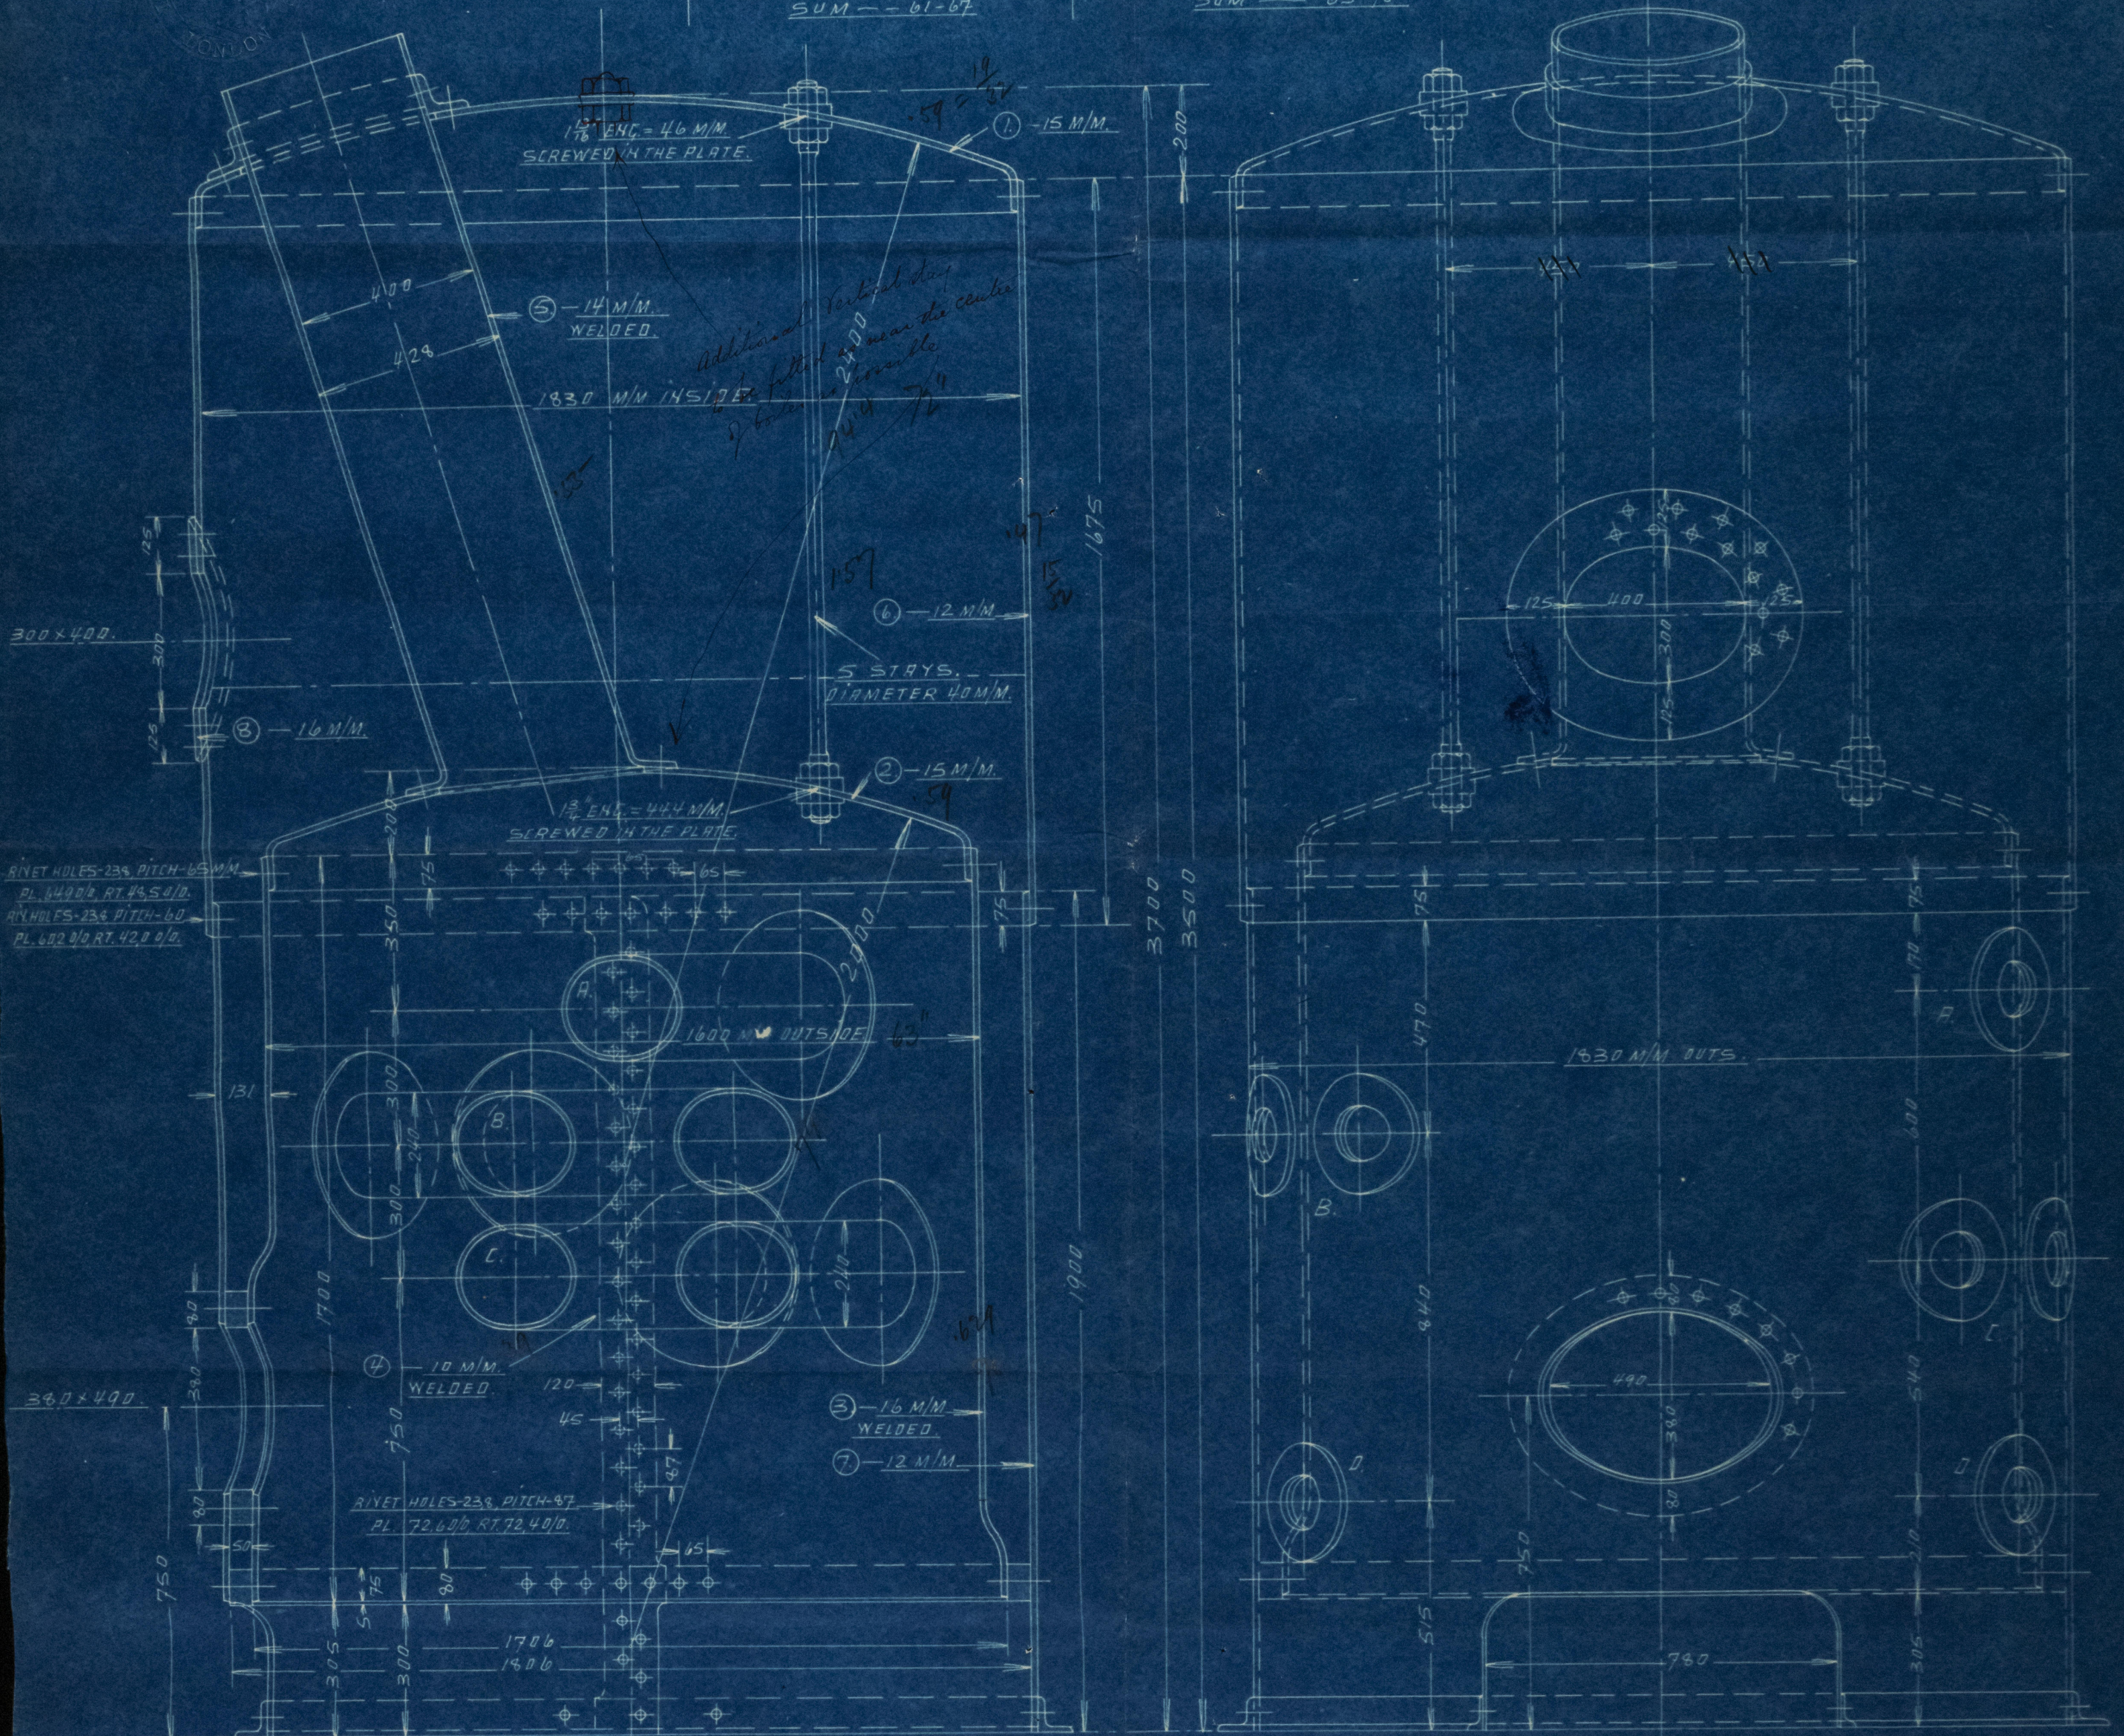


KONSTRUKTION

WIS-0132

S.S. "Pallas"

Göteborg.

Donkey Boiler.

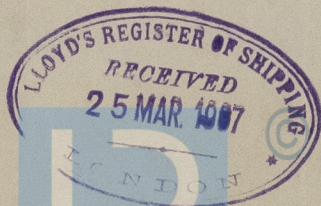

© 2021

Lloyd's Register
Foundation

W1657-0132