
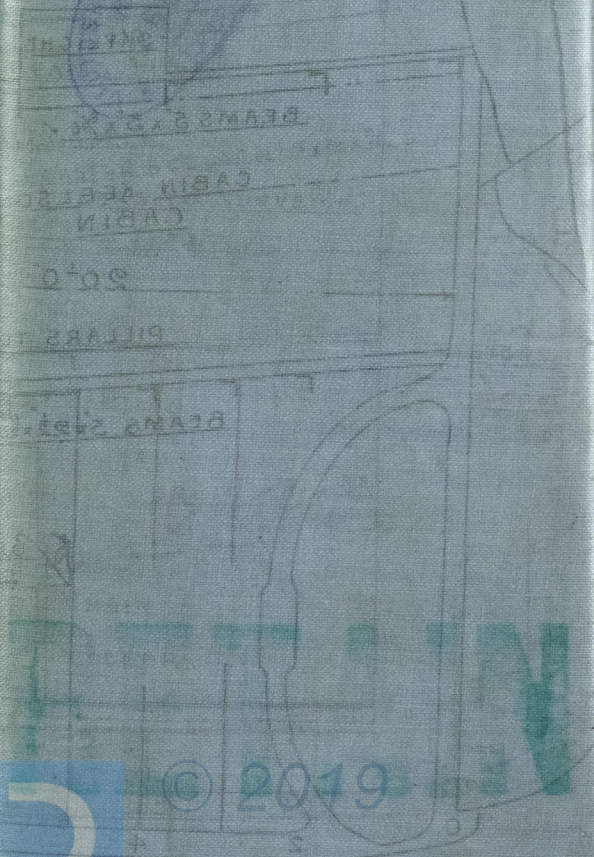


s/s 'aries' s/s 'lynx'

Hull Report No 17834

" " " 17945

SORANUS

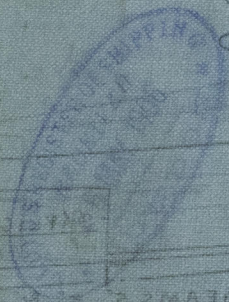


© 2019

Lloyd's Register
Foundation


W1654-0098

CHIRANE & SONS
STEEL BUILDERS
20/11/05

PROFILE & DECK PLAN
STEEL SCREW TRAWLERS
N^o 363 & 4
127' 0" x 22' 0" x 12' 4" M^{LD} 11' 6" HOLD
SCALE 1/4" = 1' 0"

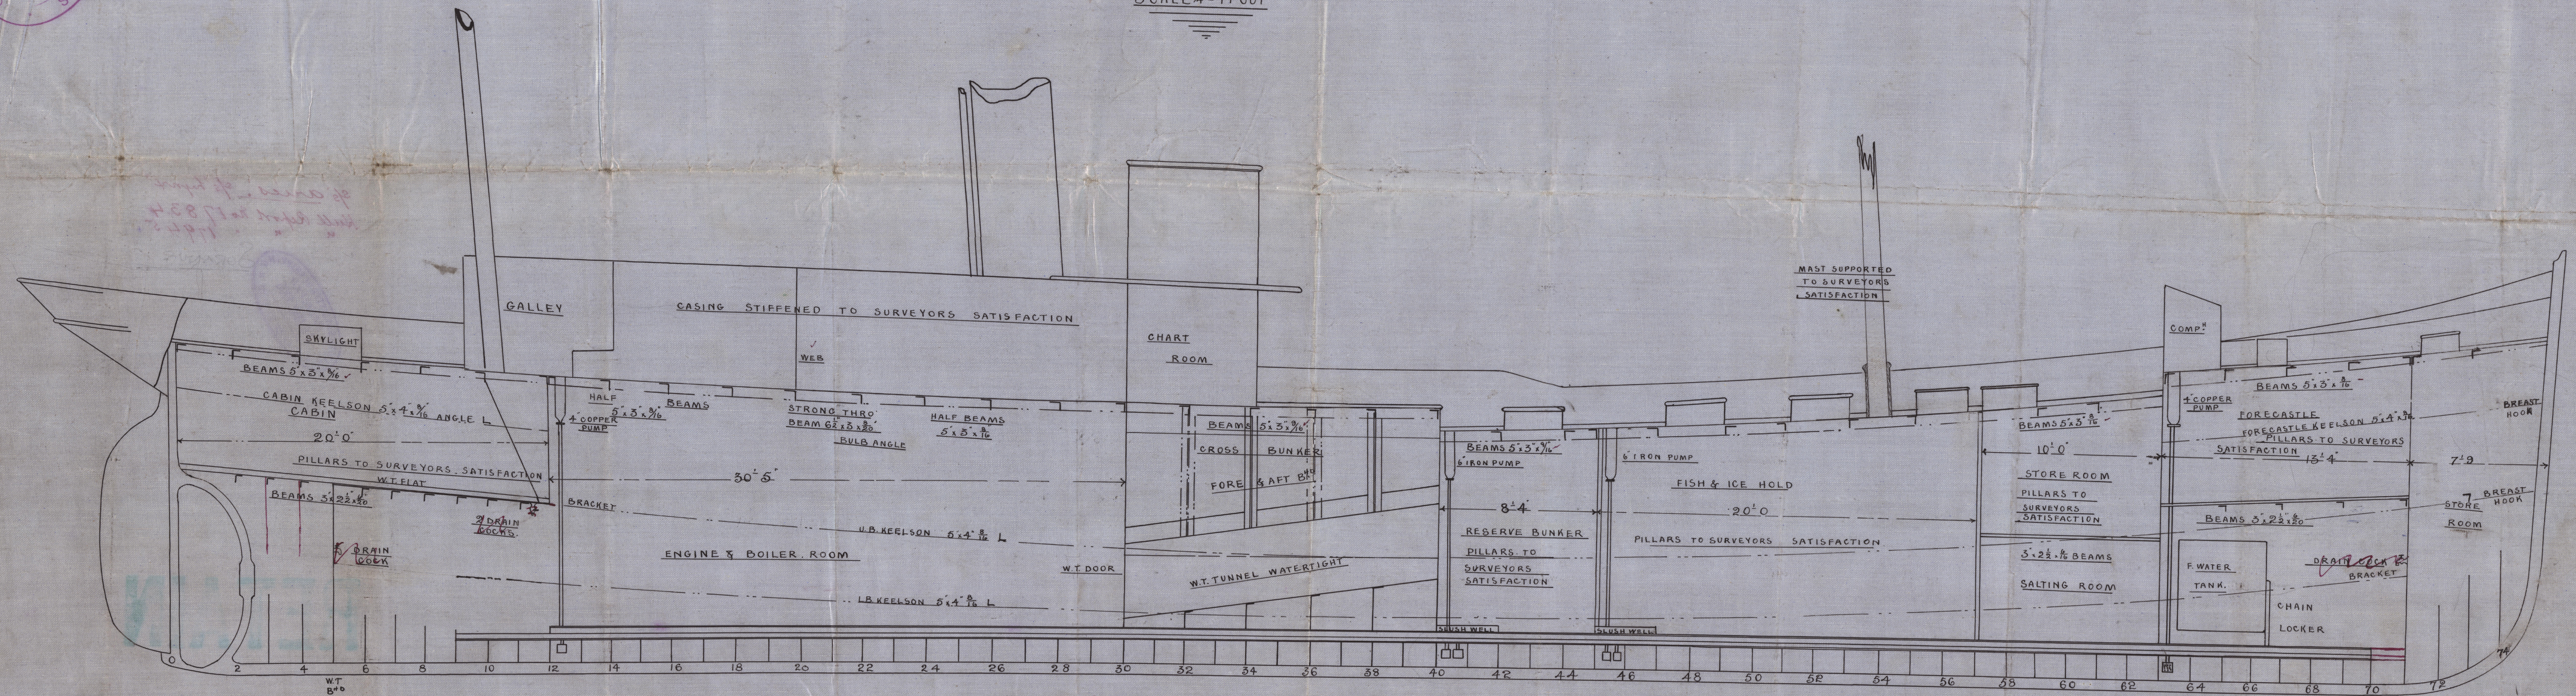

Sketch of pumping arrangements to be submitted.

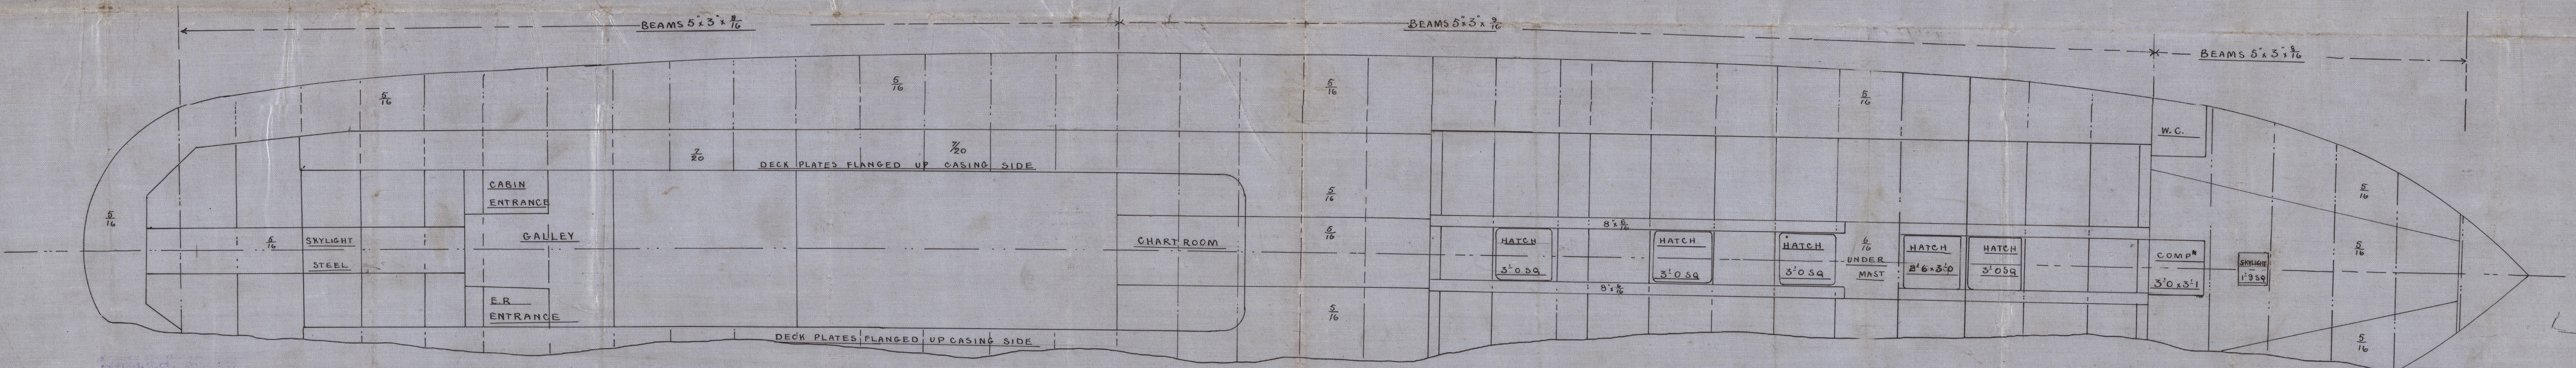

C.F.
20/11/05

LLOYD'S REGISTER
OF SHIPPING
18 NOV. 1905
+ HULL +