


Cochran & Sons

No 363-364

Midship Section.

Sp. Aris. Sp. Lynx
Hull Report No. 17834
- - - 17945

See above.

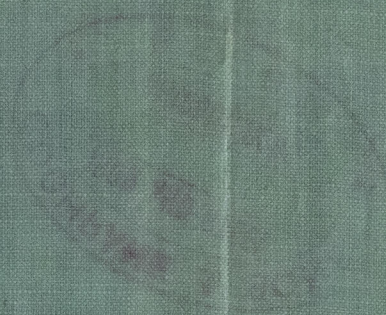

Midship Section 363-4

Midship Section 363-4



MIDSHIP SECTION
No. 363-4



© 2019

Lloyd's Register
Foundation

20-11-05

- 363 & 4

MIDSHIP SECTION

STEEL SCREW TRAWLER

LENGTH 127'0 BREADTH 22'0 DEPTH HOLD 11'6 MLD 12'4

TO CLASS 100A.1 STEAM TRAWLER

SCALE 1/2" = 1 FOOT

NUMERALS AS PER RULES


1/2 BREADTH 10.95
1/2 GIRTH 19.62
DEPTH 12.80
43.37 1st No
125.79 RULE LENGTH
5455.5123 2nd No

PROPORTIONS

DEPTHS TO LENGTH = 9.8
BREADTHS " = 5.7

EQUIPMENT

1st BOWER 5 1/2 CWTs EX STOCK
2nd BOWER 5 " " "
3rd BOWER 2 3/4 " " "
105 FATHS 1 1/2 DIA CABLE
60 " 6 HAWSER
60 " 4 1/2 WARP

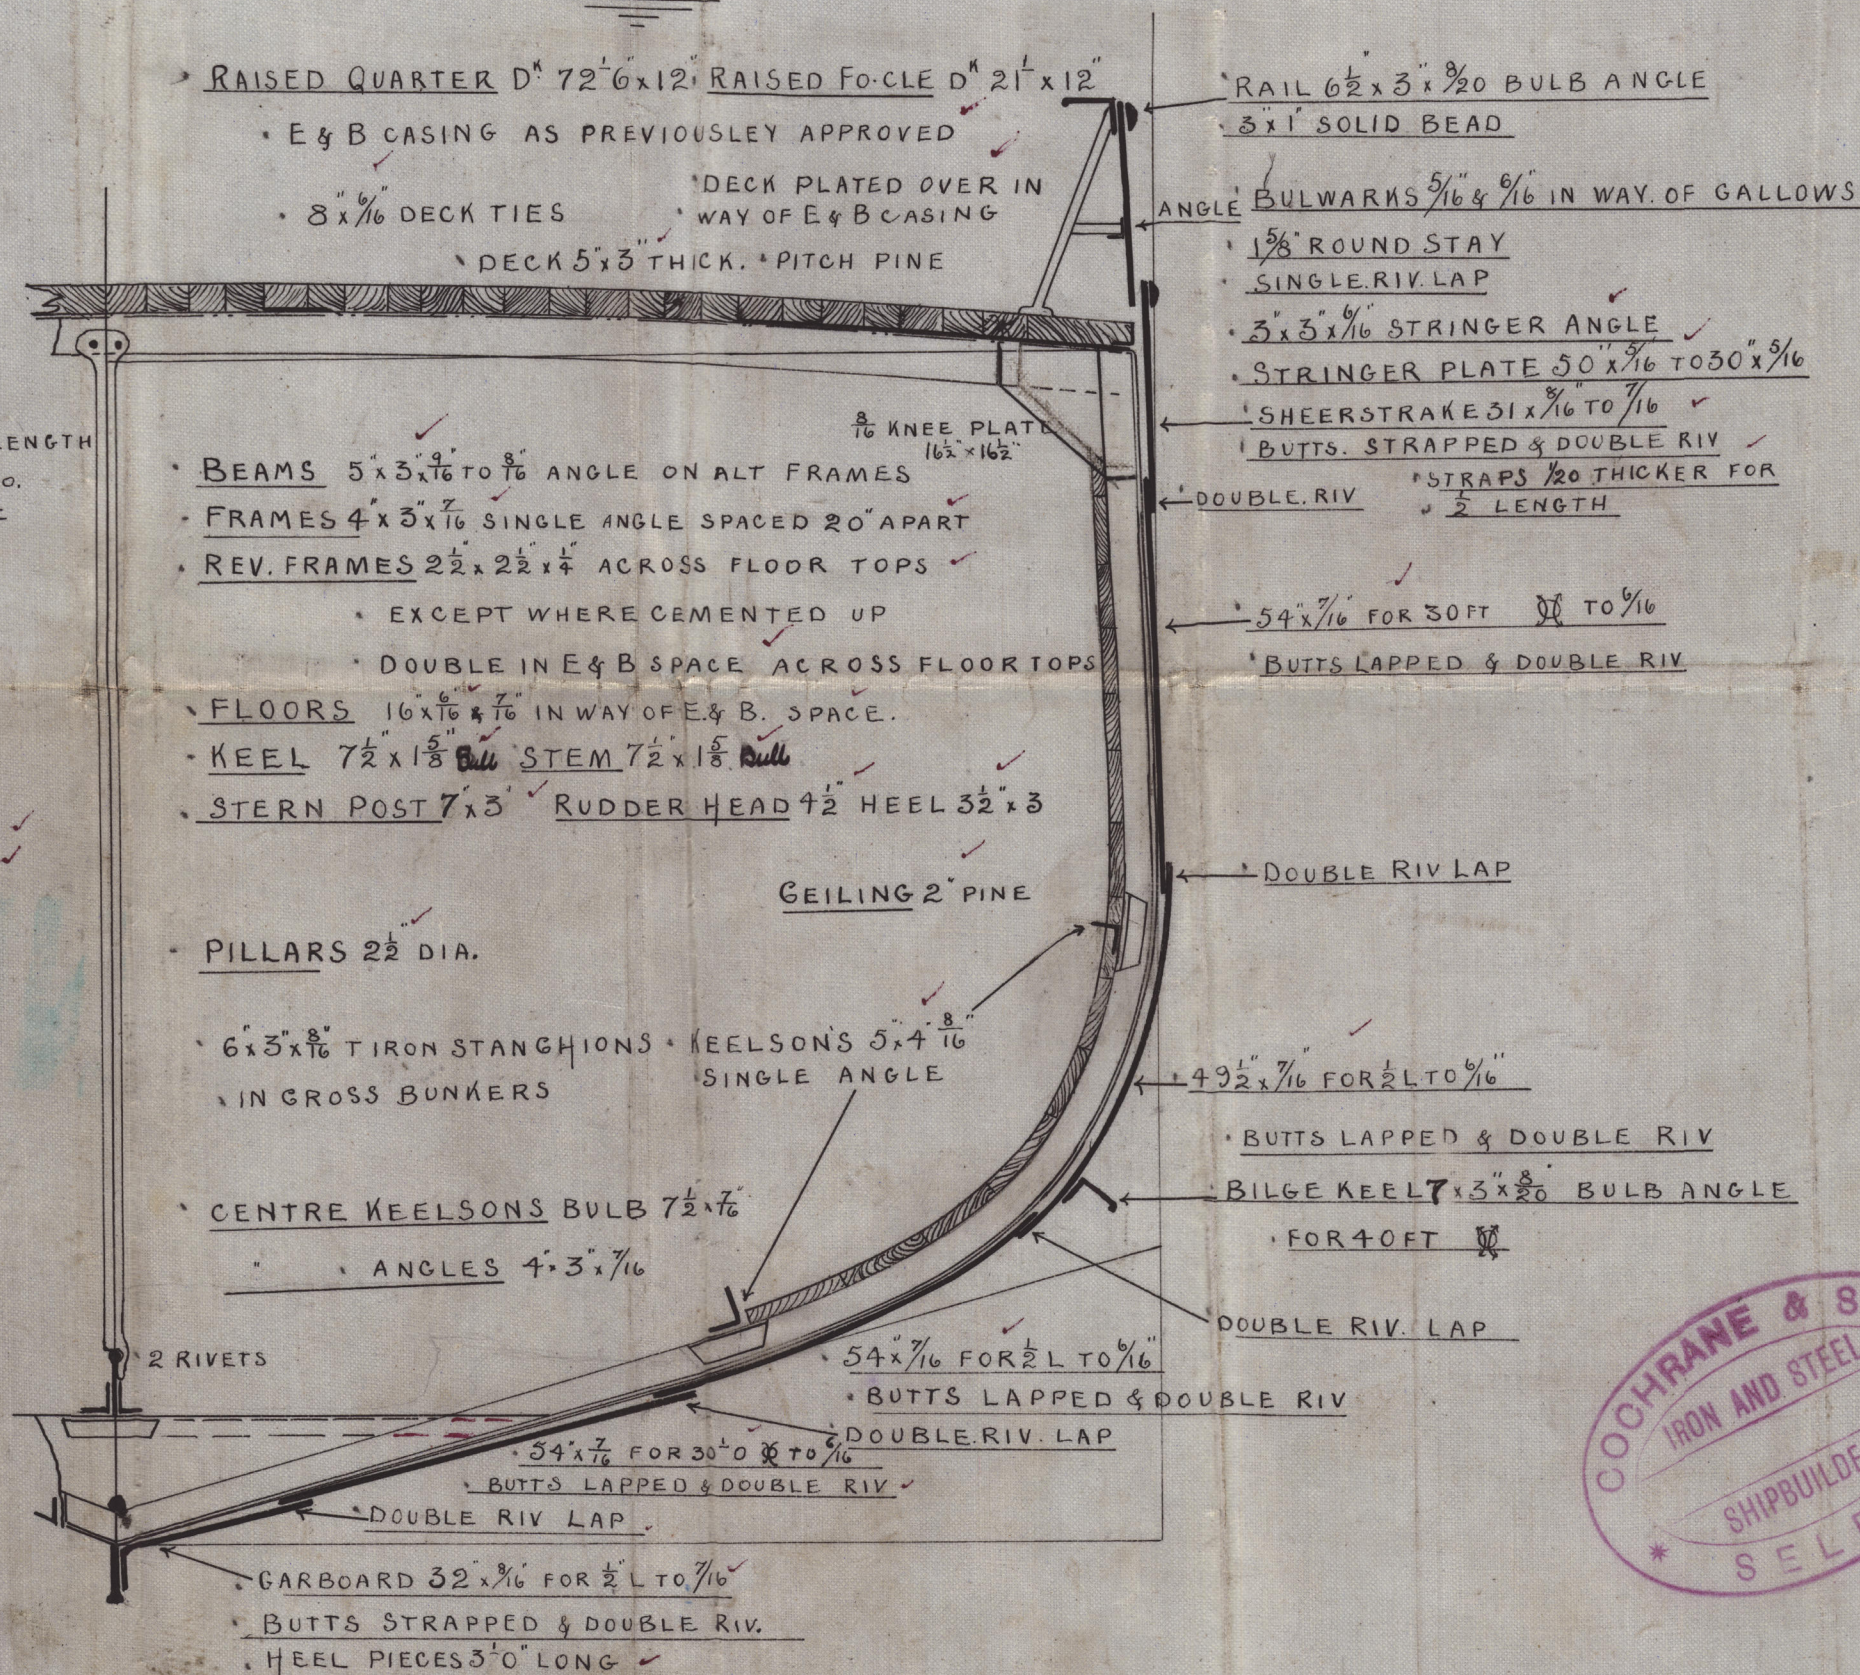

C.F.
20/11/05