

Cochran & Sons

No: 549 - ~~550.~~

No: ~~548~~ - 560.

Duplicate

Midship Section.


6 ~~Volunteer~~ Hull Report No: 25993

• Tribune " " " 26097

• Volcan " " " 26207

• Waldorf " " " 26750.*

RETAIN

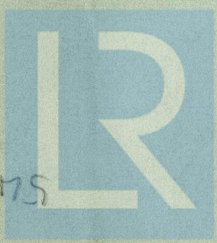

© 2019

Lloyd's Register
Foundation

95-b175

No

W1654-0137

avab p monra
 02 - p 43 con
 000 842 27
 water 6 quibell

Messrs Lloyd's Surveyors
 Hull

MIDSHIP SECTION

STEEL SCREW TRAWLERS

N^{os} 549-50 & 548+560

DIMS. LEN 133'-4" x 23'-0" E x 13'-1" MLD
 SCALE 1/2" = 1 FOOT

TO CLASS 100A1 AT LLOYDS FOR FISHING PURPOSES ENGINE
 & BOILER CASING AS PREVIOUSLY APPROVED. DECK
 PLATED OVER IN WAY OF ENGINE & BOILER CASING.

PLAN No. 2680
 FOR ENCLOSURE TO
 Messrs Lloyd's Surveyors
 Hull FROM
 COCHRANE & SONS, LTD.
 SHIPBUILDERS, GELFING
 DATE 20/3/13. RK

27.9.12
 30.10.12

20.9.12. RK

NUMERALS

B+D = 35.95
 L(B+D) = 4793.21

PROPORTIONS


W/L = 10.19
 W/L = 5.79

EQUIPMENT

1ST BOWER ANCHOR 6 CWTs EX STOCK
 2ND " " 5 1/2 " " "
 KEDGE ANCHOR 3 " " "
 120 FATHOMS 1 1/2" CABLE
 60 " 6" HAWSER
 60 " 5" WARP

RIVETING

BUTTS OF SHELL PLATING LAPPED & DOUBLE
 RIVETED EXCEPT GARBOARD & SHEERSTRAKE
 WHICH ARE TO BE STRAPPED & DOUBLE
 RIVETED LANDINGS DOUBLE RIVETED BULWARKS
 SINGLE RIVETED

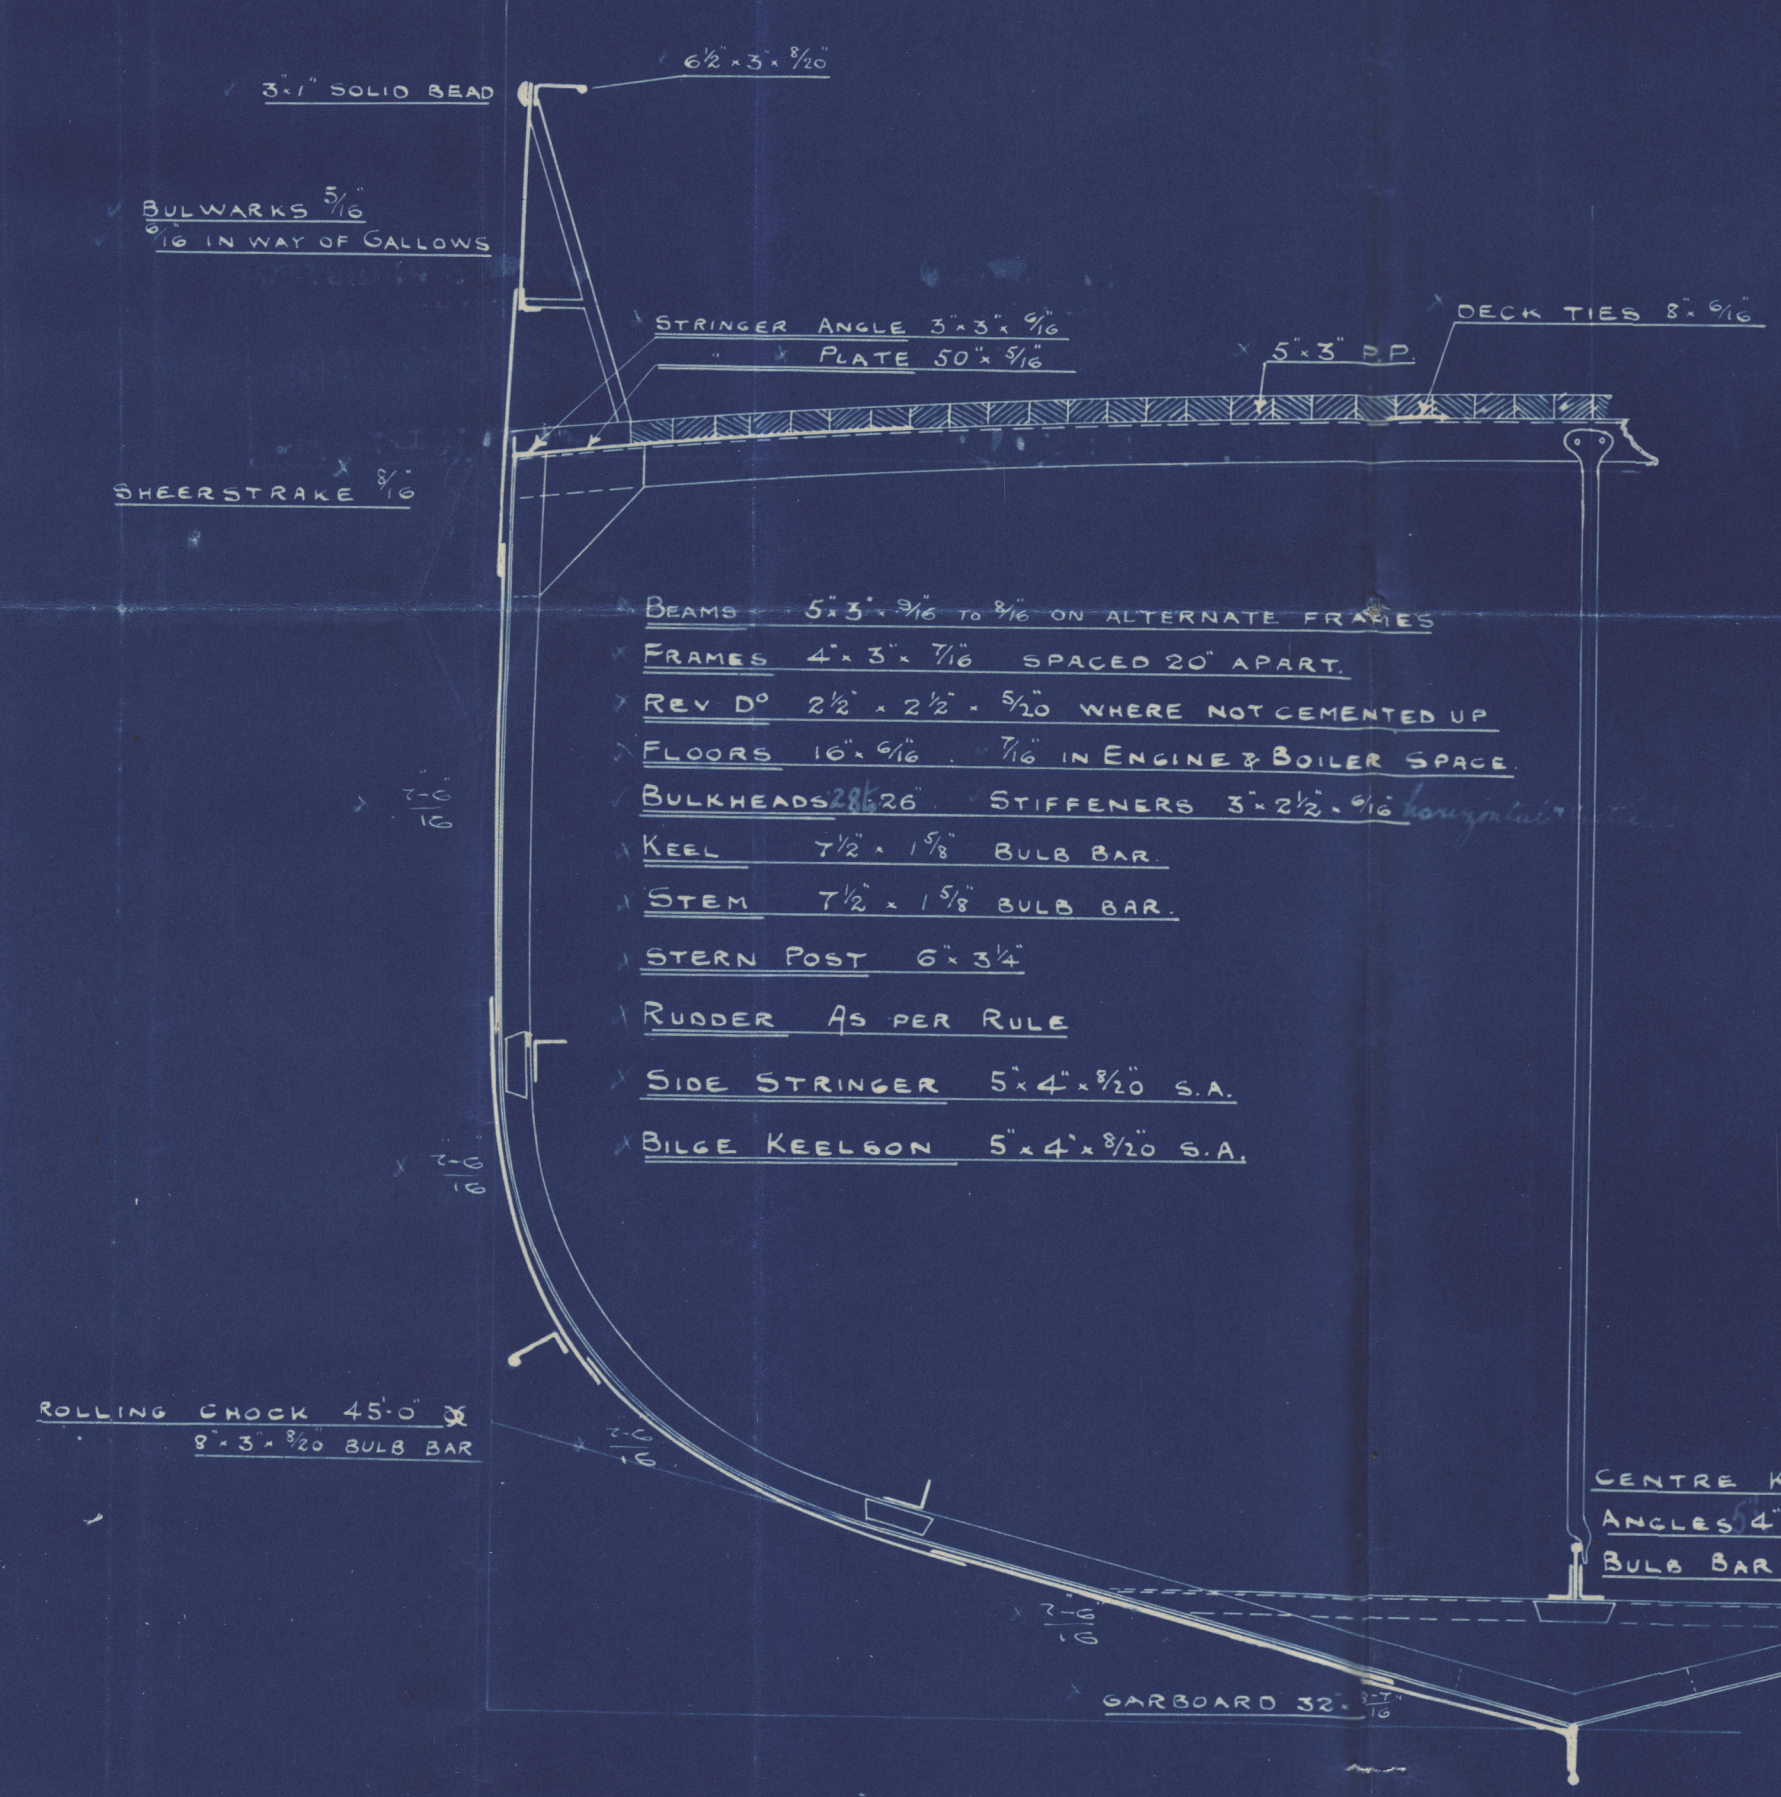

5" x 4" x 8/16" in 549-50.
 3" x 5" x 3" x 7/16" in 548+560.

C.B.
 27.9.12



© 2019
 Lloyd's Register
 Foundation