

Midship Section showing alterations
to Shell plating


Gle of airfield Ship Bui & Eng Co Ltd

G. S. S. No 528



T.S.S. "Empress of Canada"

Glasgow Fleet Ref No. 41140.

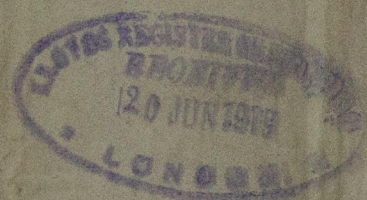

GLASGOW REPORT No. 41917



W166-0042



© 2020

Lloyd's Register
Foundation