

DIMENSIONS

CLASS 100 A1.
SCALE 1/2" = 1 FOOT.

DEPTH 28-00
LENGTH 372-41 ON LWL
1st LONGITUDINAL No = 10427-48

BREADTH 52-50
DEPTH 28-00
LENGTH 372-41
2nd LONGITUDINAL No = 29379-00

DEPTH TO LENGTH 13-30 UPPER DECK.
-DO- 10-13 BRIDGE DECK.

<u>ANCHORS & CABLES</u>		
2nd. LONGITUDINAL NO		29979.00
POOR BRIDGE & FOLE. 291.75 - 875 - 75		1914.60
DECK HOUSE	292.75	81.37
CASING	$\frac{60 \times 74F}{2}$	222.30
	EQUIPMENT NO =	32197-27

1ST BOWER STOCKLESS 56 1/4 CWTs.

240	--0--	56 1/4	--
350	--0--	47 1/2	--


STREAM EX-STOCK 15 --

270 FMS. STUD CHAIN CABLE 2 1/2

90 FMS. STREAM CHAIN 1 1/2 OR 4 1/2 STEEL W

HAWERS & WARDS

120 FMS. TOWLINE	13' HEMP	OR 4 1/2 STEEL
2-30 --- HAWSER	7' ---	2 1/2
2-30 --- WARD	7' ---	2 1/2

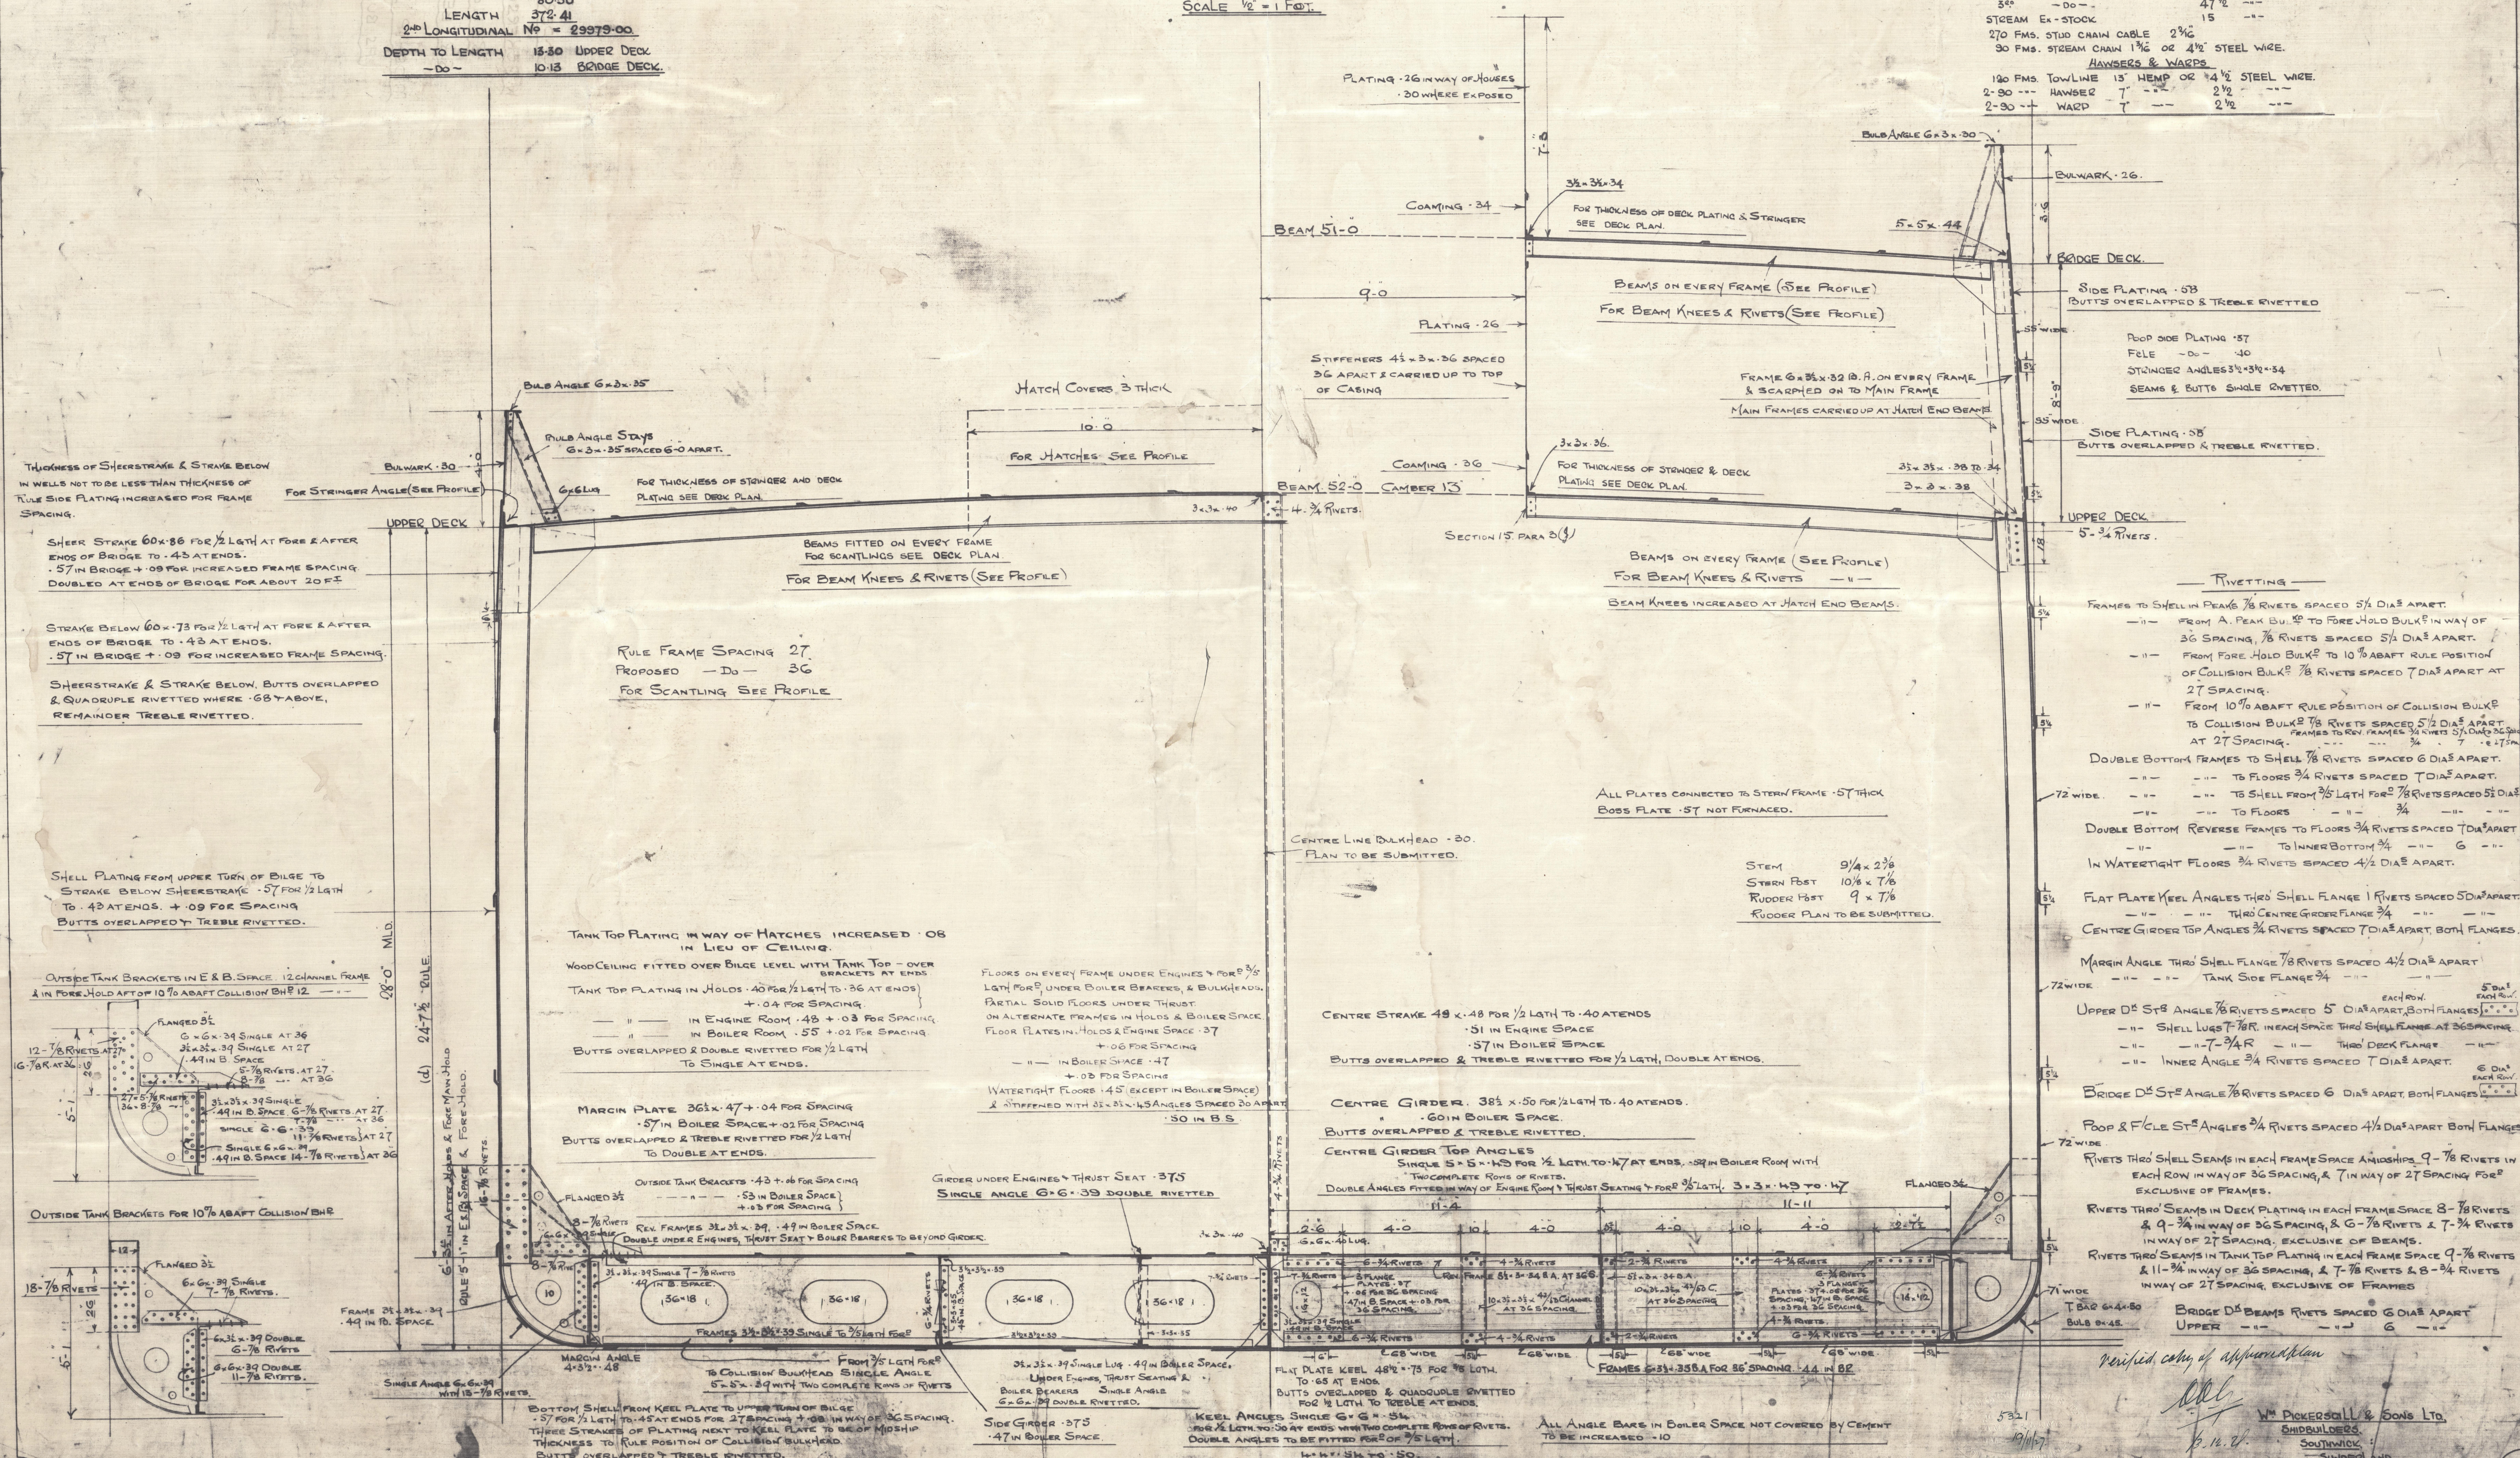

verified copy of approved plan

W^m PICKERSGILL & SONS LTD
SHIPBUILDERS,
SOUTHWICK,
SUNDERLAND

Contracted to Lloyd 31.1.27.

SUNDERLAND

W. PEKERSGILL & SONS

S.S. No. 219

S.S. "BENJON"

MIDSHIP SECTION
(AS BUILT)

SUNDERLAND RPT. NO. 29555.

"Epaminondas C. Embiricos"

W166-0070



© 2020

Lloyd's Register
Foundation