


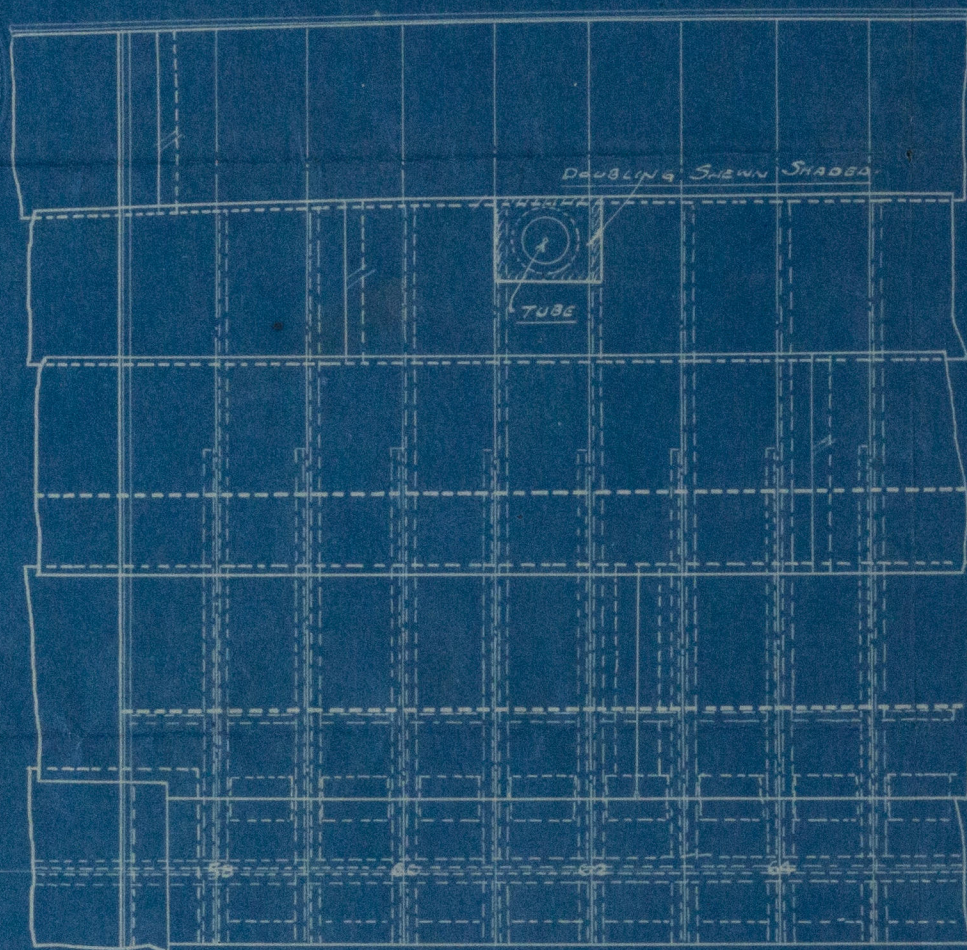


12.12.16

PLAN OF TANK TOP.



SECTIONAL ELEVATION

SCALE 1" = 1 FOOT

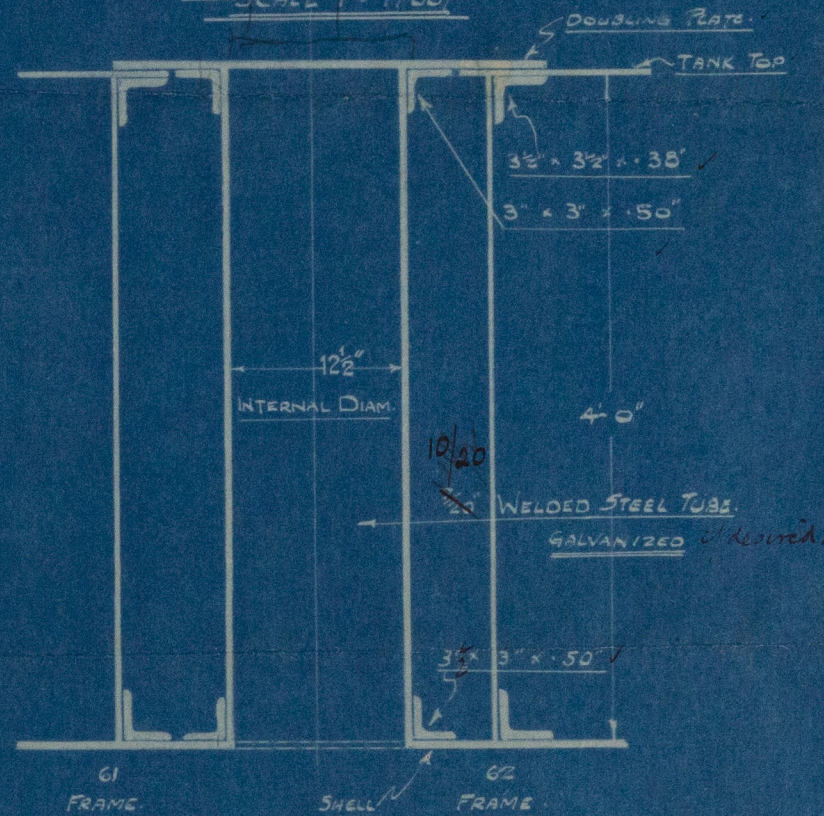

PLAN OF TUBE TO TAKE LOW MAIN

INJECTION VALVE


Nº 197 5/8

CJ
13.12.16.


96
13.12.16



W169-0116

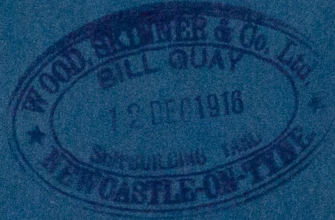

ELEVATION.

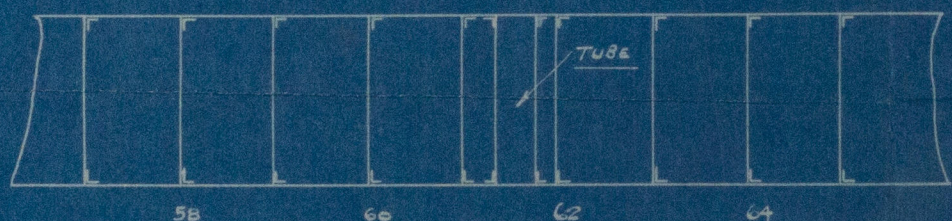

197

West Wood
Stann to
Lake Quarry
Double Bottom

SP 197

Gallies



88. TYNEMOUTH
NEWCASTLE ON TYNE.

Report No. 69569

Gallies

© 2020

Lloyd's Register
Foundation

W169-0116