


Mint
Horn China
No 197

S.P. Tyneworth
Indisput
Section
as
Built.

Gallies' esc

88. Tyneworth
NEWCASTLE ON TYNE.

Report No. 69559

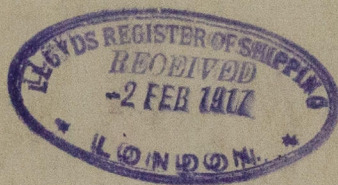

X1169-0117



© 2020

Lloyd's Register
Foundation