File with "Höegh Carrier"
Lir 111379

BYGNING Nº 631. TUNNEL

RECESSKOD PAA SPT: 20. SET FORFRA

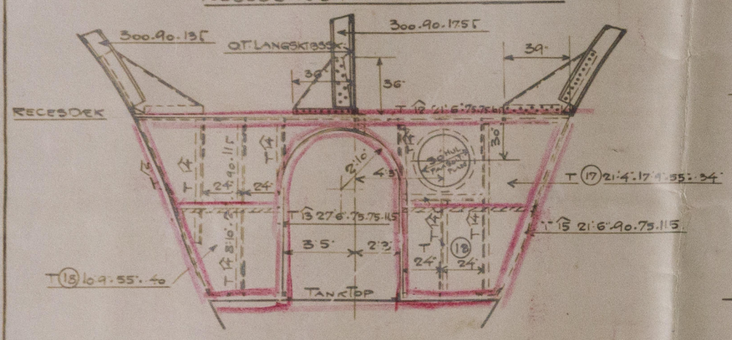

TUNNELLENS BB. SIDE SET FRA SB.

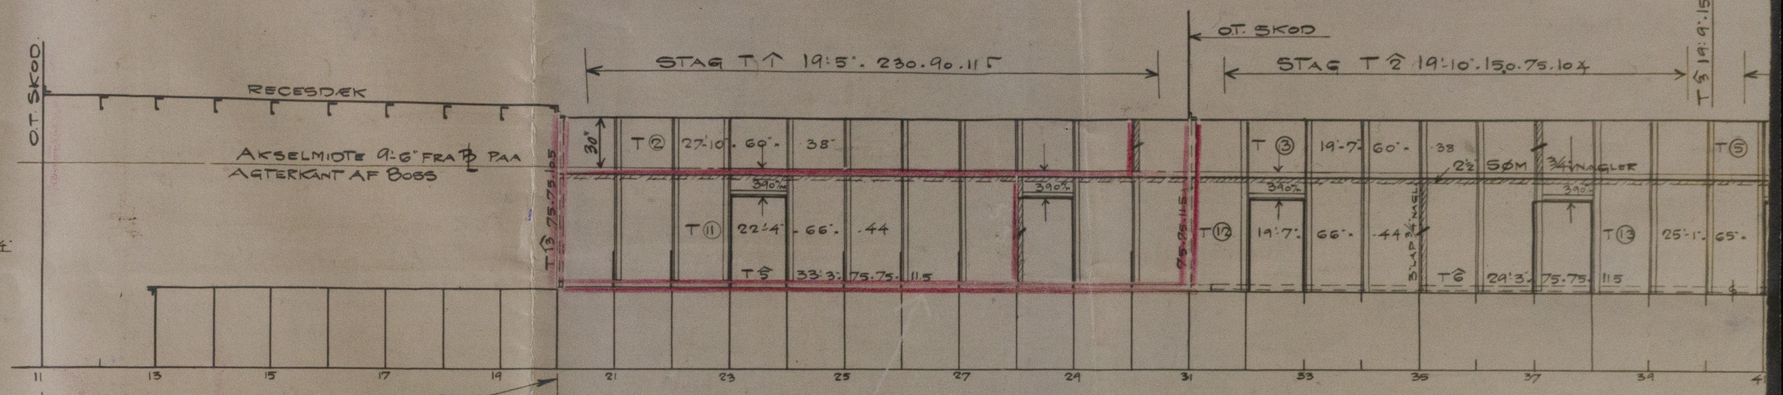

KNÆ PAA STAG TIL RECESSKOD

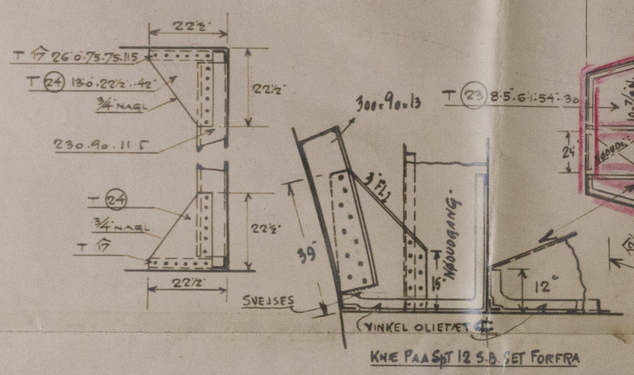

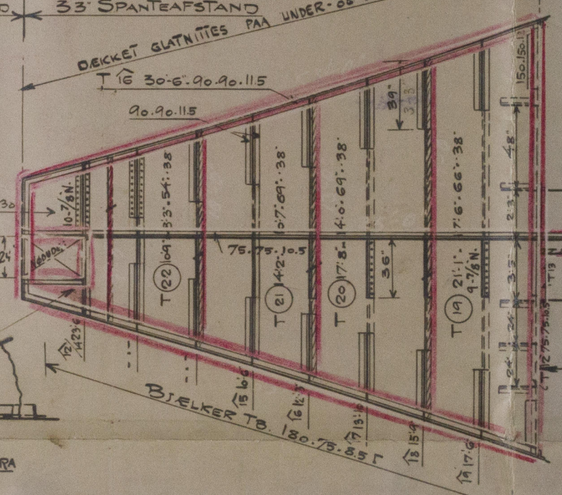

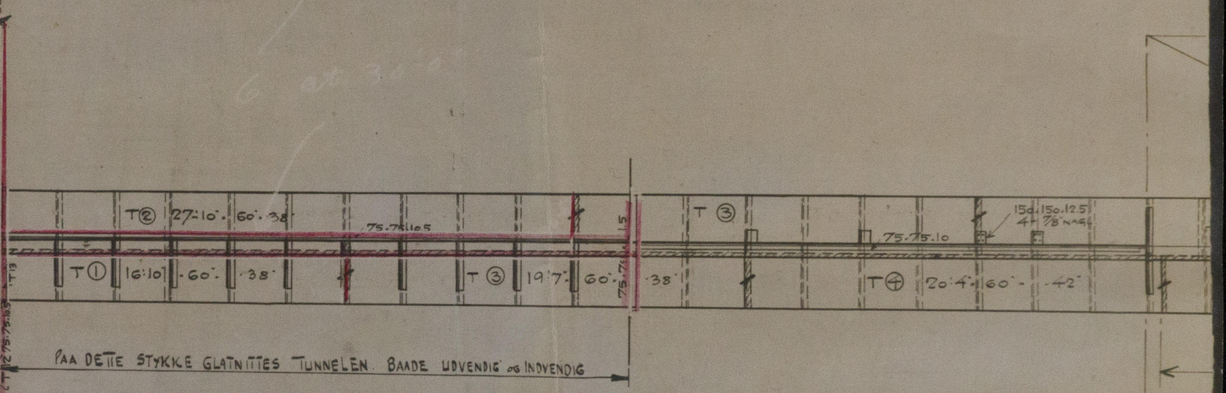

TUNNELLENS SB. SIDE SET FRA SB.

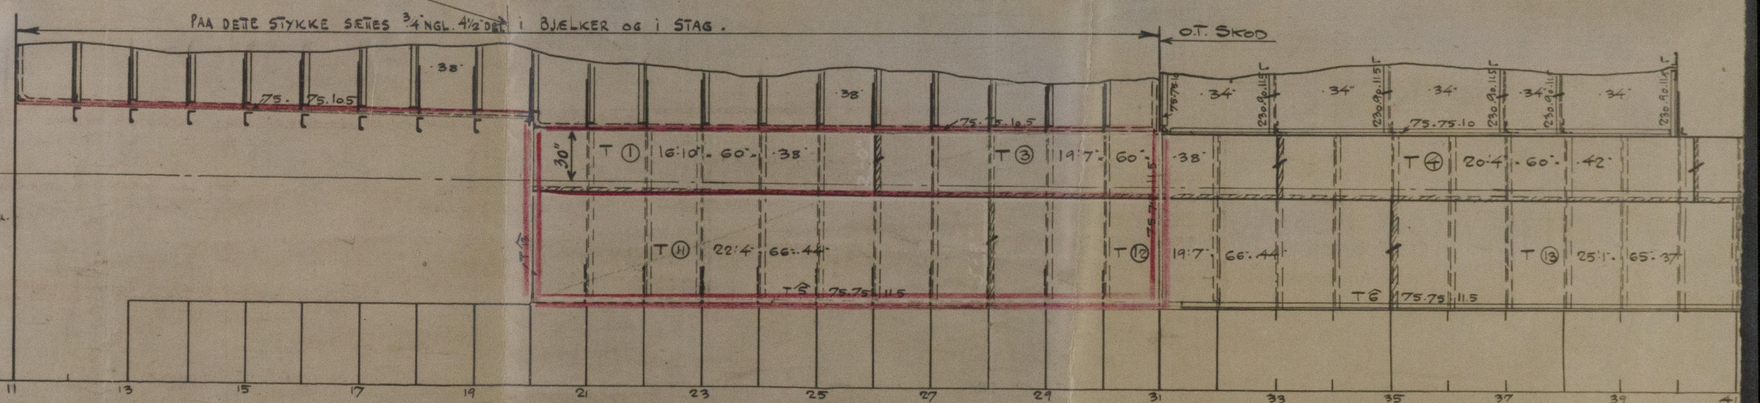

AKSELSTOL SPT. 14-15.

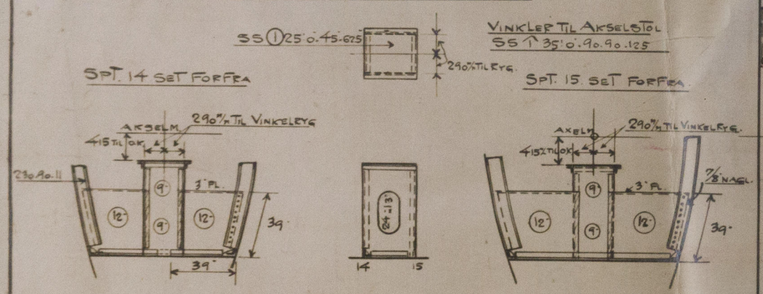

AKSELSTOL SPT. 19-20

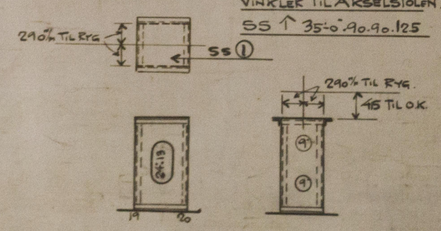

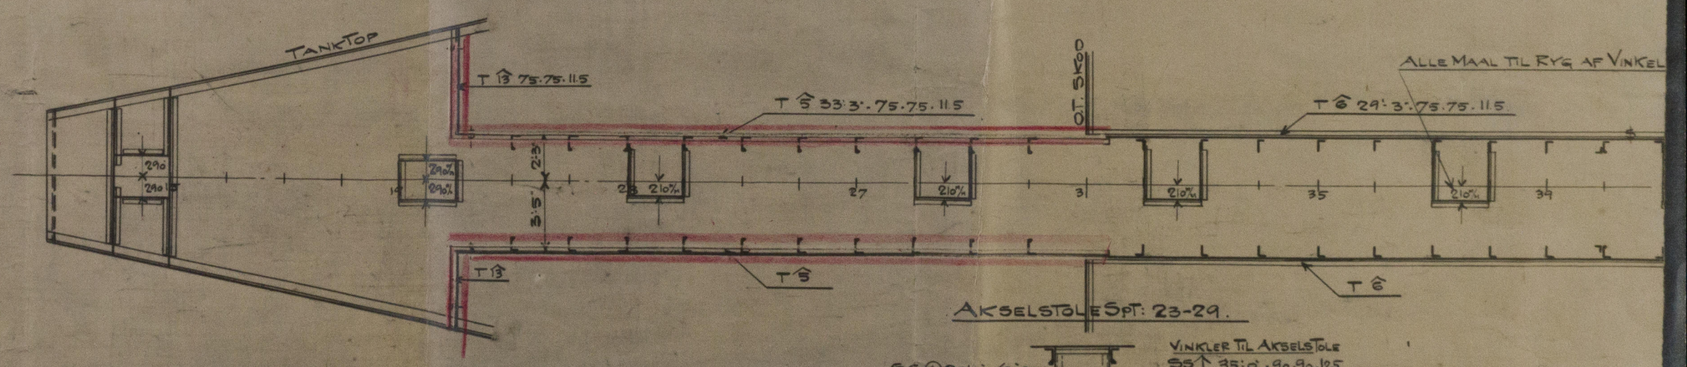

AKSELSTOLE SPT: 23-29.

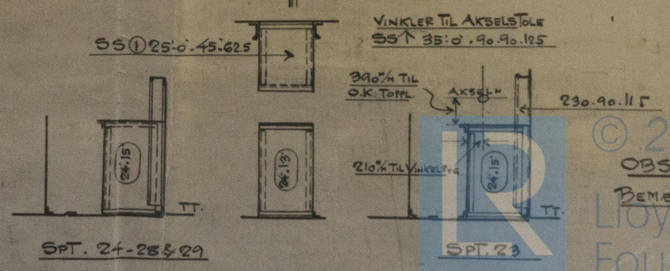

© 2020
OBS. HVOR INTET ANDET BEMÆRKET TAGES RADERAFS
Lloyd's Register Foundation

W172-0089