


PROFILE & DECKS.

YARD N^o 614.

MESSRS BURMEISTER & WAIN.

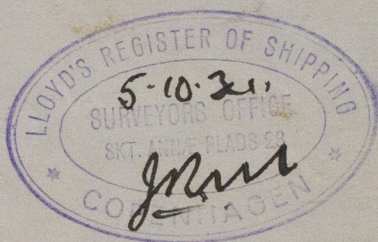

M/s. "Flagh Carrier".

Gen. Report No. 9699.

W172-0175



© 2020

Lloyd's Register
Foundation