



# ~ PROFILE & DECK PLAN. ~

DIMENSIONS: LENGTH B.P. (LWL) 420'-9" x BREADTH MLD. 57'-5 1/2" x DEPTH MLD. 29'-1" TO 2ND DECK.  
37'-7" TO UPPER DECK.

FOR A DRAFT NOT EXCEEDING THAT CORRESPONDING TO THE RULE  
FOR A COMPLETE SUPERSTRUCTURE VESSEL CLASS 100 A.1  
SCALE: 1/8" = ONE FOOT

Nº 649.

NOTE! ALL CHANNELS & BULD ANGLES  
TO NEW BRITISH STANDARD SECTIONS.

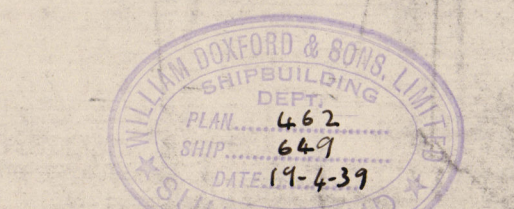 

Doxford  
649

Profile & Deeds  
(As Built)

121. Harrington Court  
SUNDERLAND, NPT. NO. 32612.



© 2019

Lloyd's Register  
Foundation

W173-0094