


206322




SECTION A-A

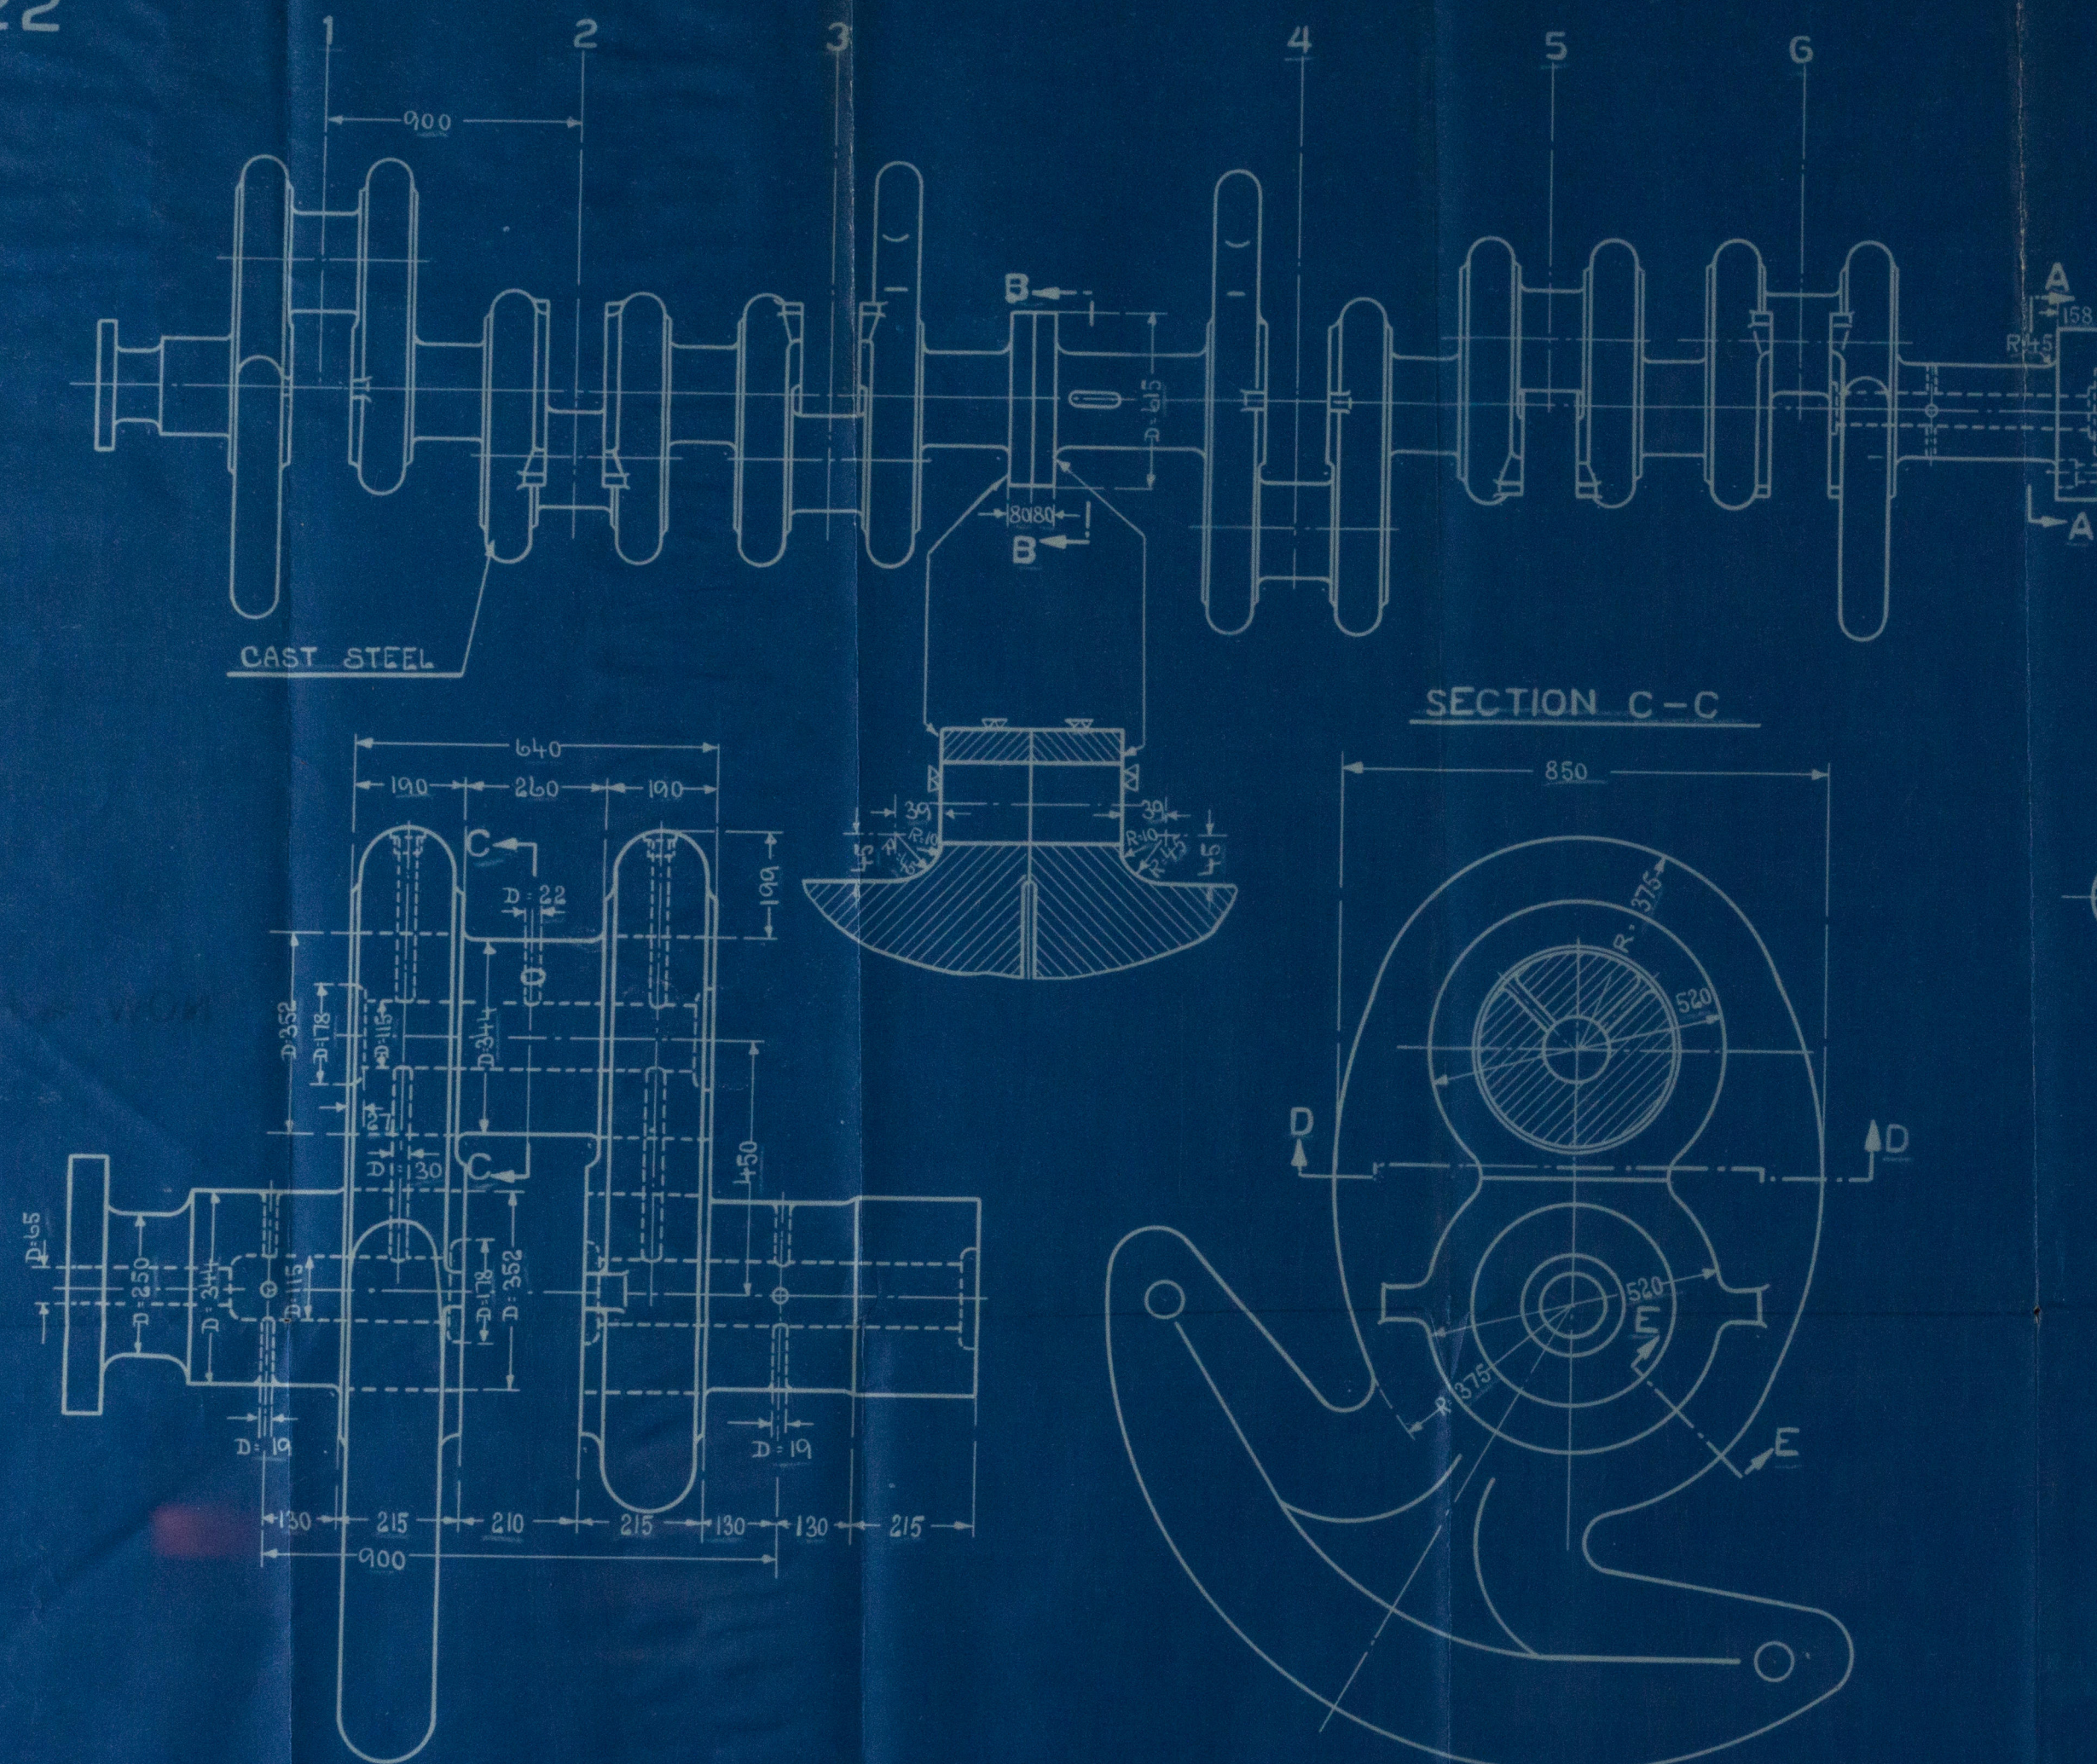


8 OFF 72 M/M BOLT HOLES  
P.C.D. = 492 M/M

SECTION D-D

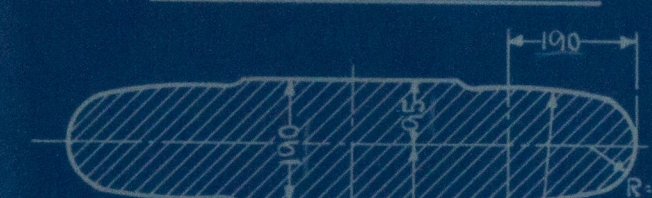

SECTION E-E

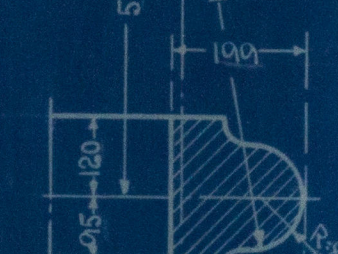

SECTION B-B



8 OFF 72 M/M BOLT HOLES  
P.C.D. = 492 M/M

THIS DRAWING AND THE DESIGN SHOWN THEREIN, IS THE PROPERTY OF BURMEISTER & WAIN LIMITED, AND IS ONLY ALLOWED TO BE USED BY EXHIBITING PERMISSION AND LICENSE FROM BURMEISTER & WAIN LIMITED COPENHAGEN

CRANK SHAFT FOR YARD No  
MAIN ENGINE

PROJEKT

6 CYLINDER 2 SCSEA DIESEL ENGINE  
CYL. DIAM 500 M/M STROKE 900 M/M  
WITH SOLID INJECTION

AKTIESELSKABET  
BURMEISTER & WAIN MASIN OG SKIBSBYGGERI  
© 2019

10715-0042





Præparat Crank shaft  
for 6-cyl. 2 s. r. s. a.  
Diesel oil engines  
To be constructed by

AKTIESELSKABET  
BURMEISTER & WAIN'S MASKIN- OG SKIBSBYGGERI



"Nora" Cpn. 11110.

NOW.  **HALMA** 



© 2019

Lloyd's Register  
Foundation

X1175-0298