
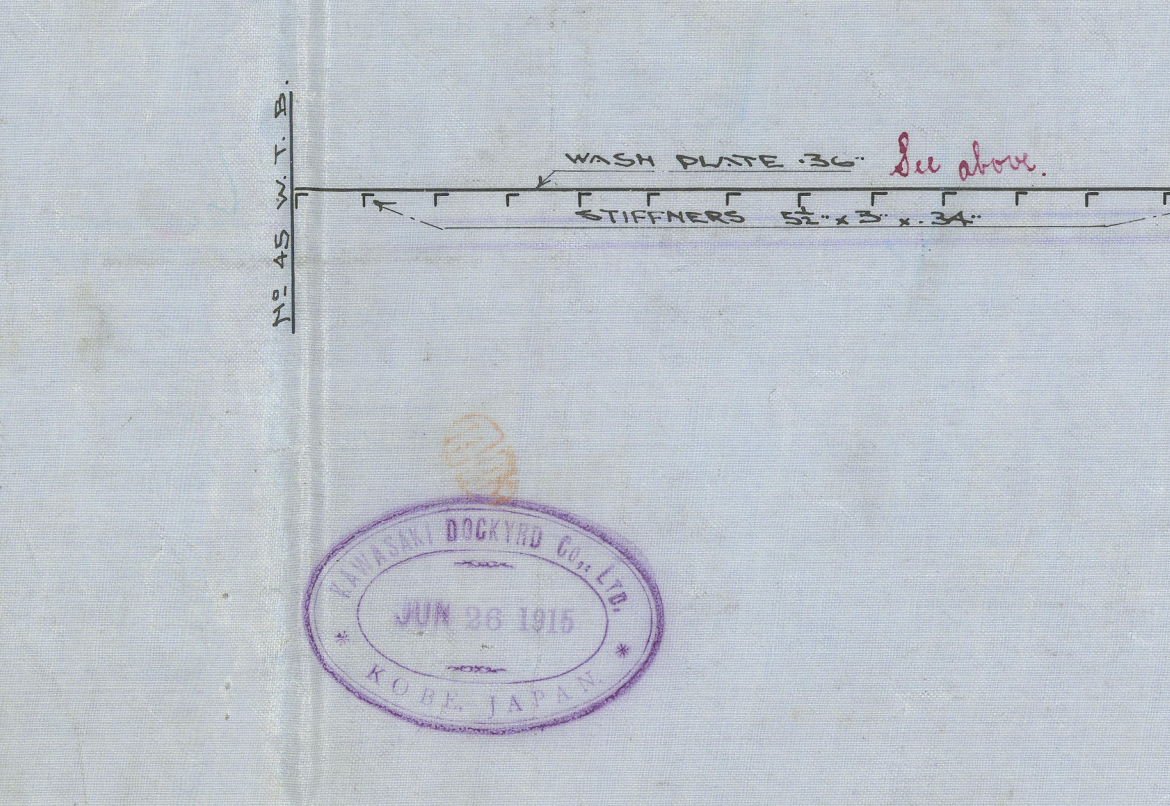
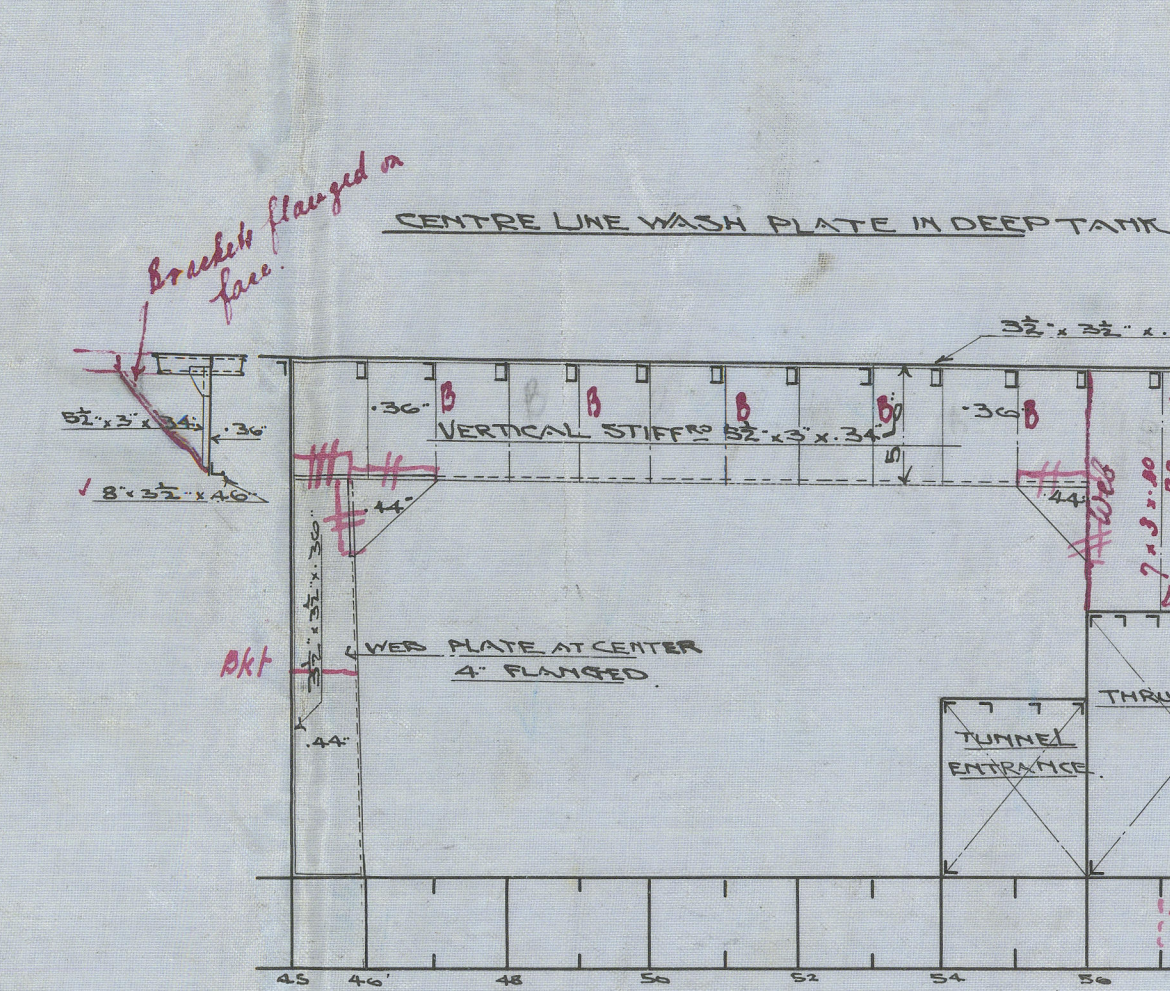


12.8.15


N° 380-2 CONSTRUCTION PROFILE & DECK PLANS.

SCALE 1/8" TO A FOOT.


PARTIAL DULK 8 AT PS NO 20

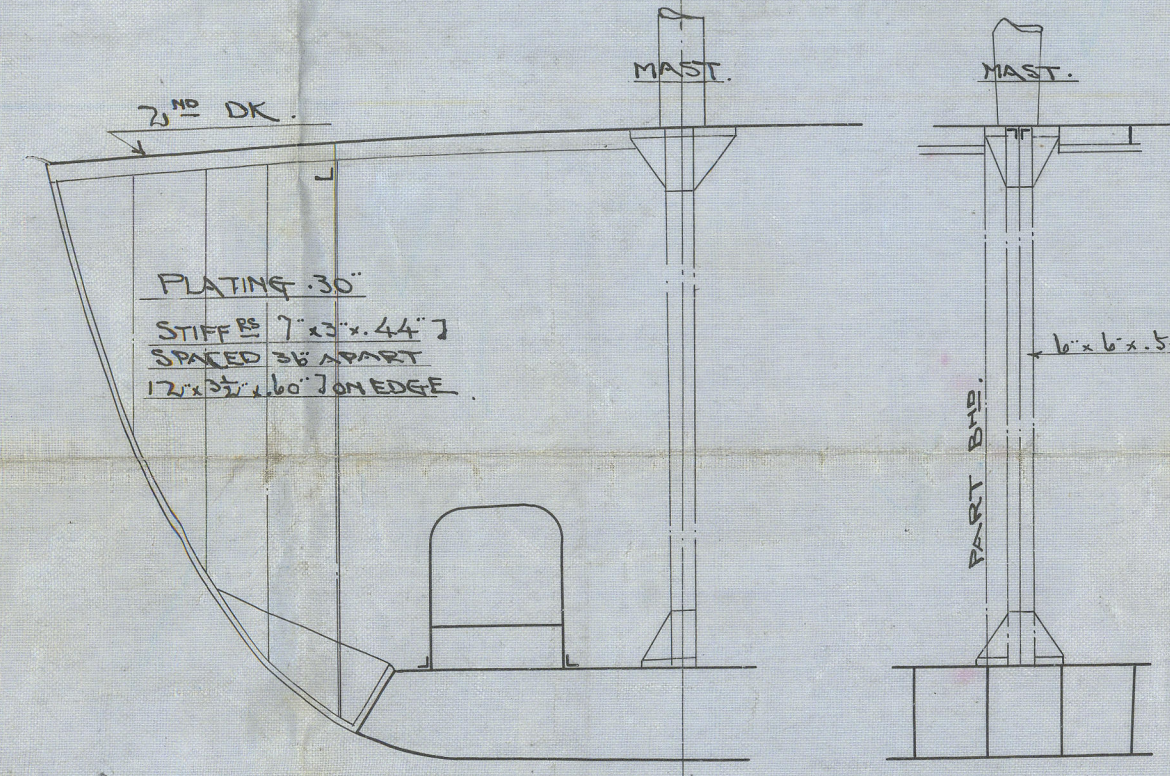



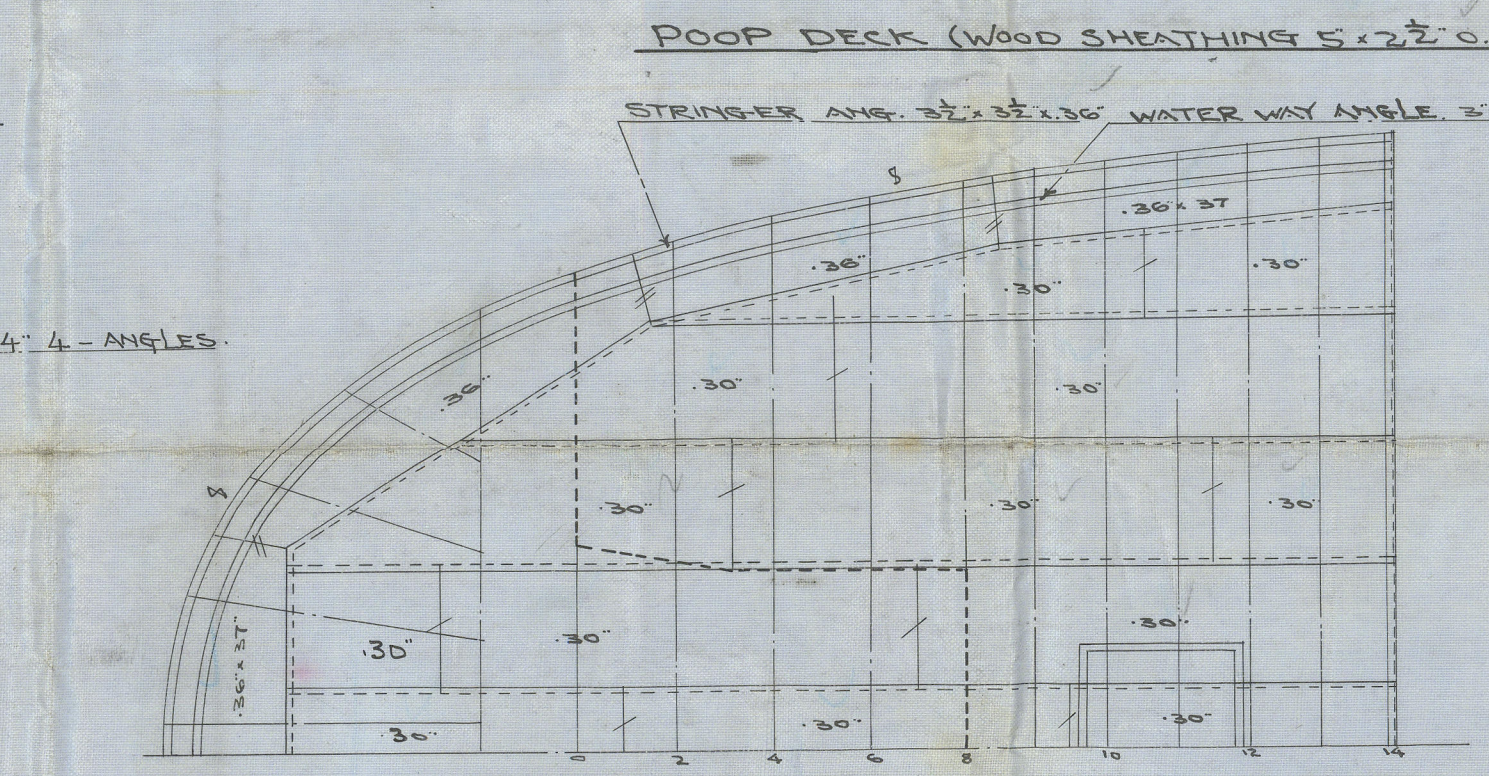



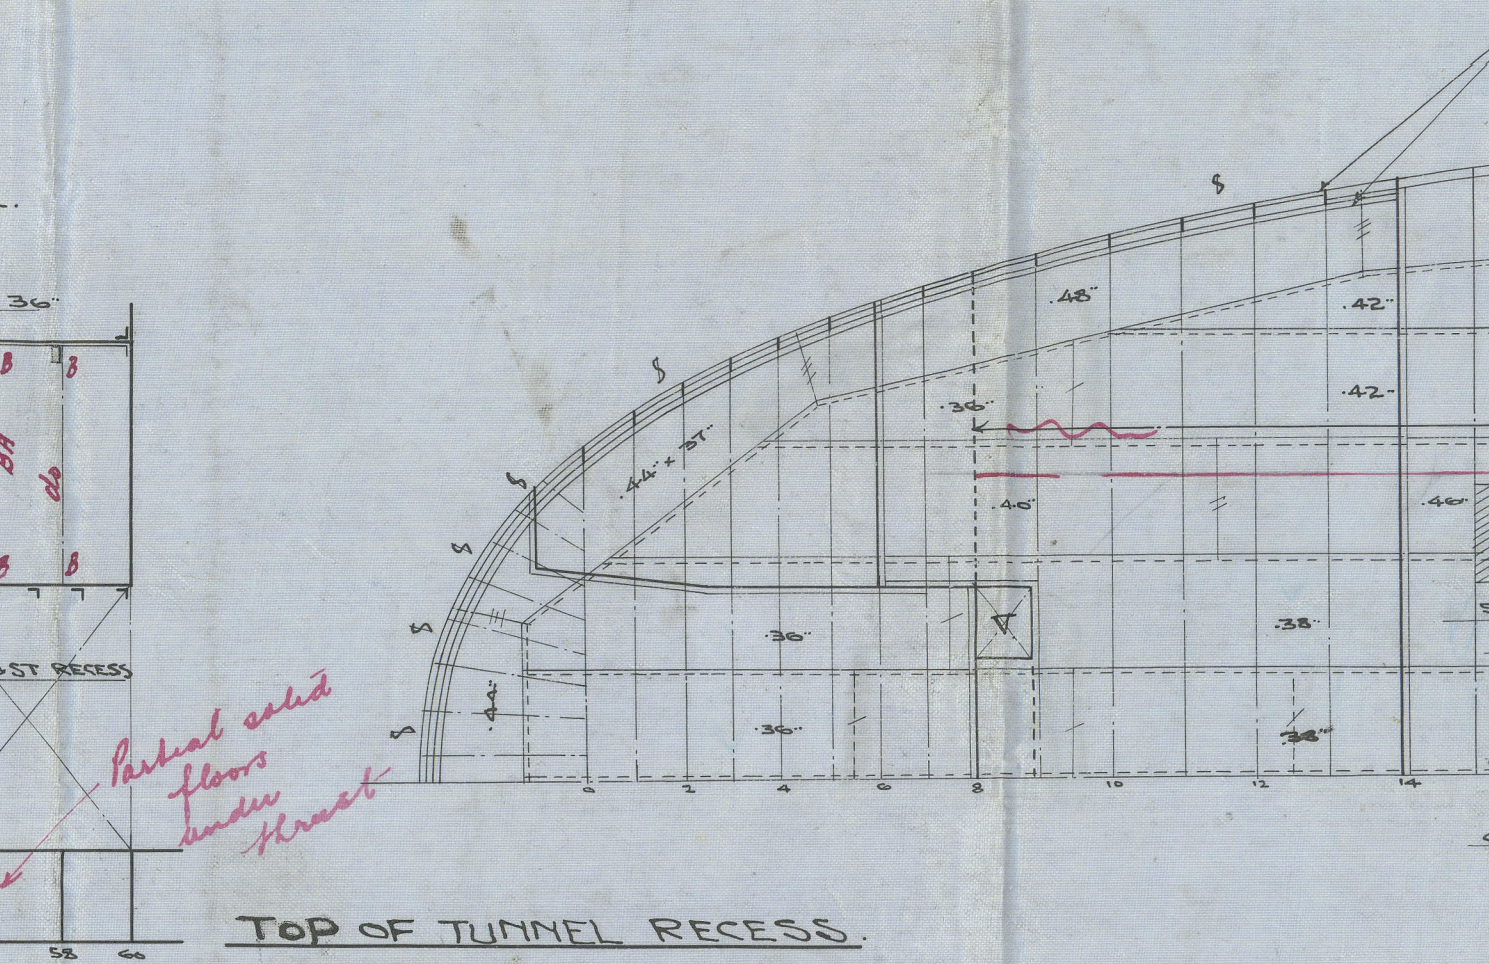



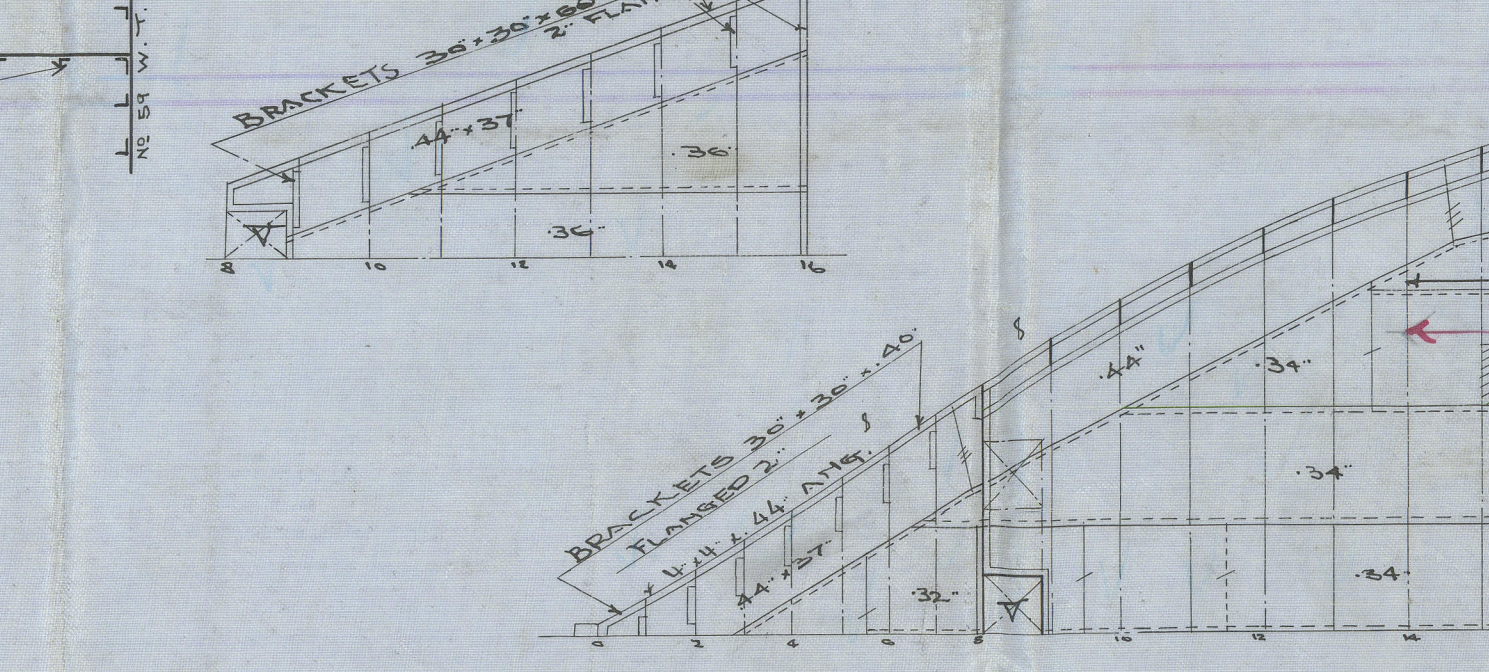


BOAT DECK (WOOD SHEATHING 5/16" x 6")

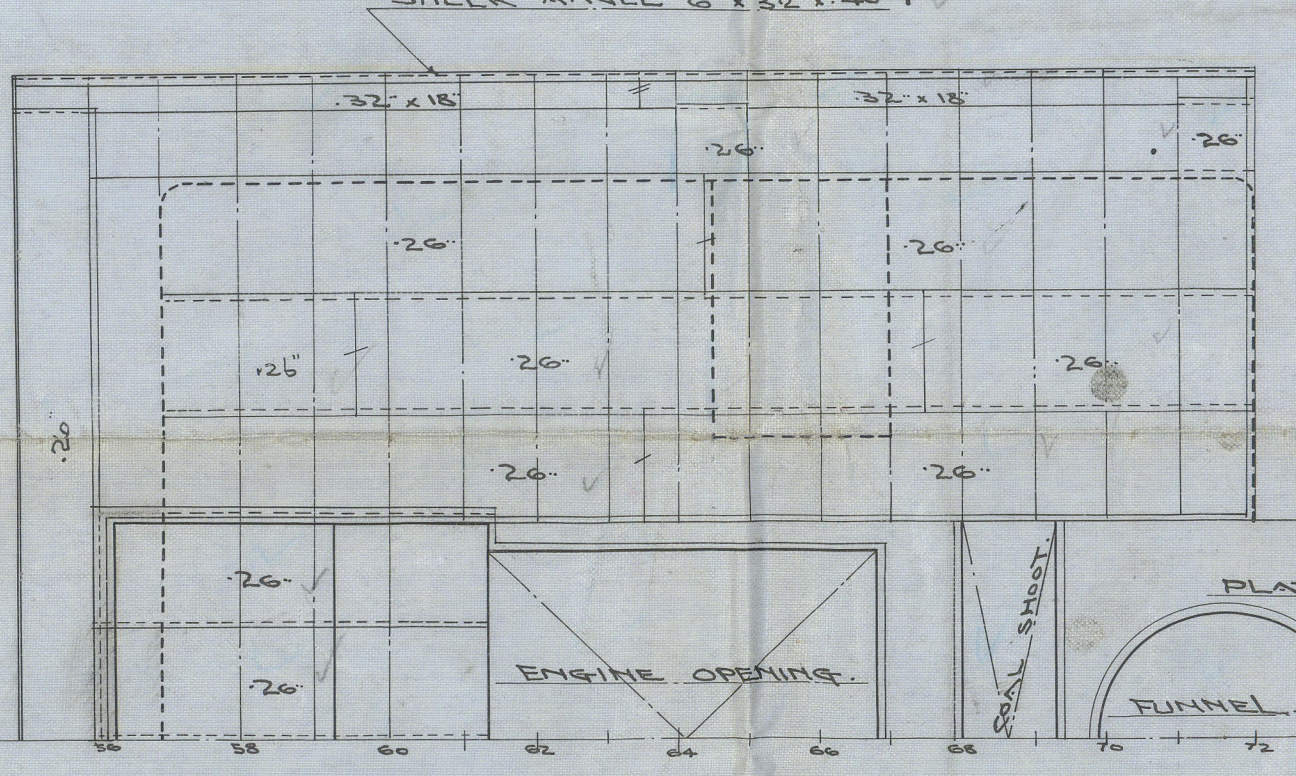


BOAT DECK (WOOD SHEATHING 5/16" x 6")

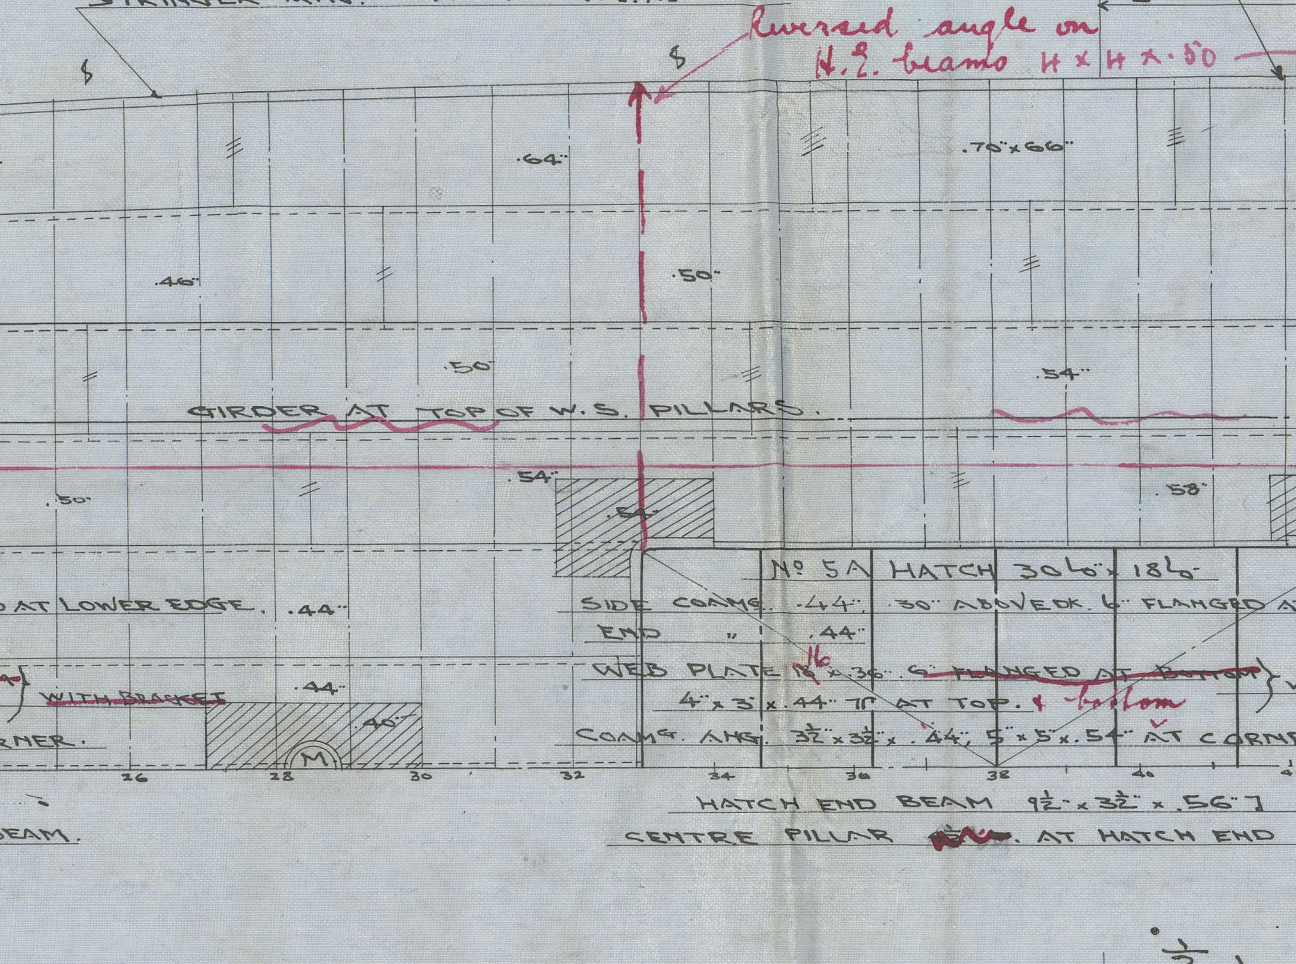


BOAT DECK (WOOD SHEATHING 5/16" x 6")

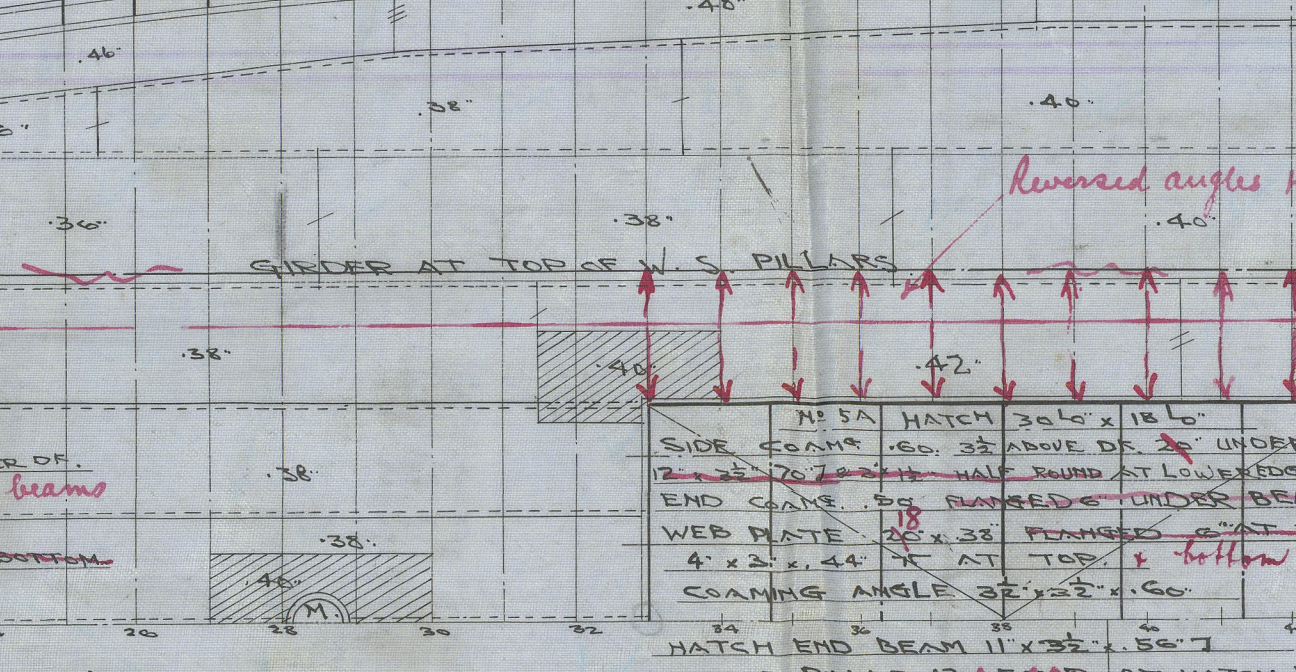


WEB FRAME

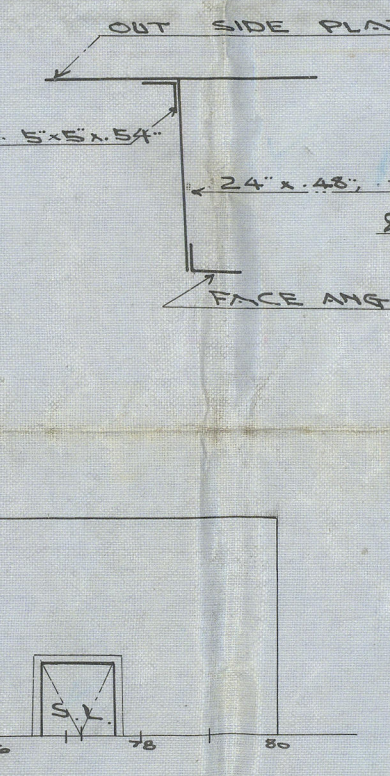


WEB FRAME

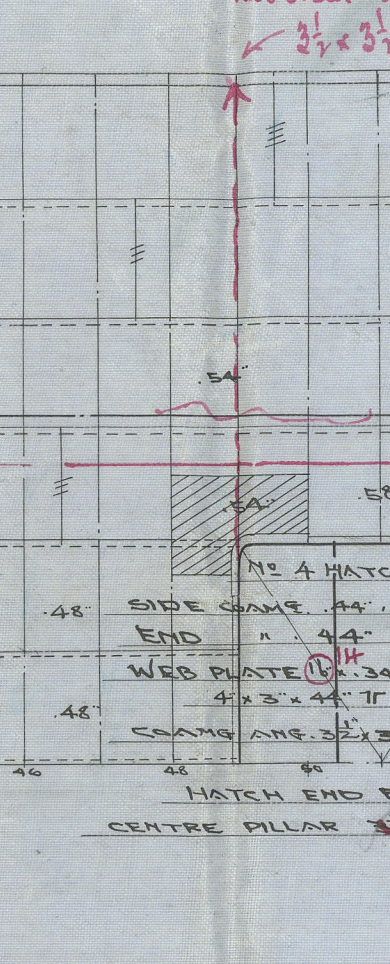


WEB FRAME

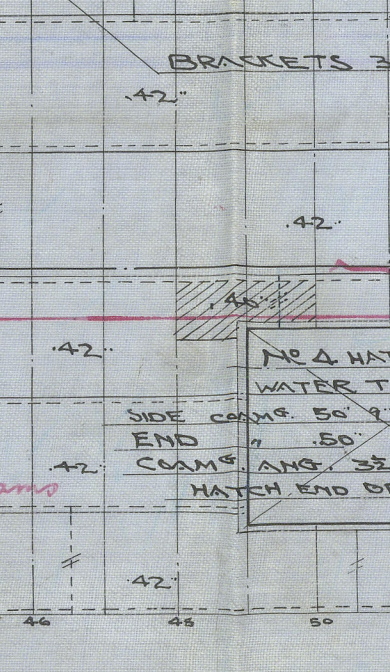


BRIDGE DECK (WOOD SHEATHING 5/16" x 6")

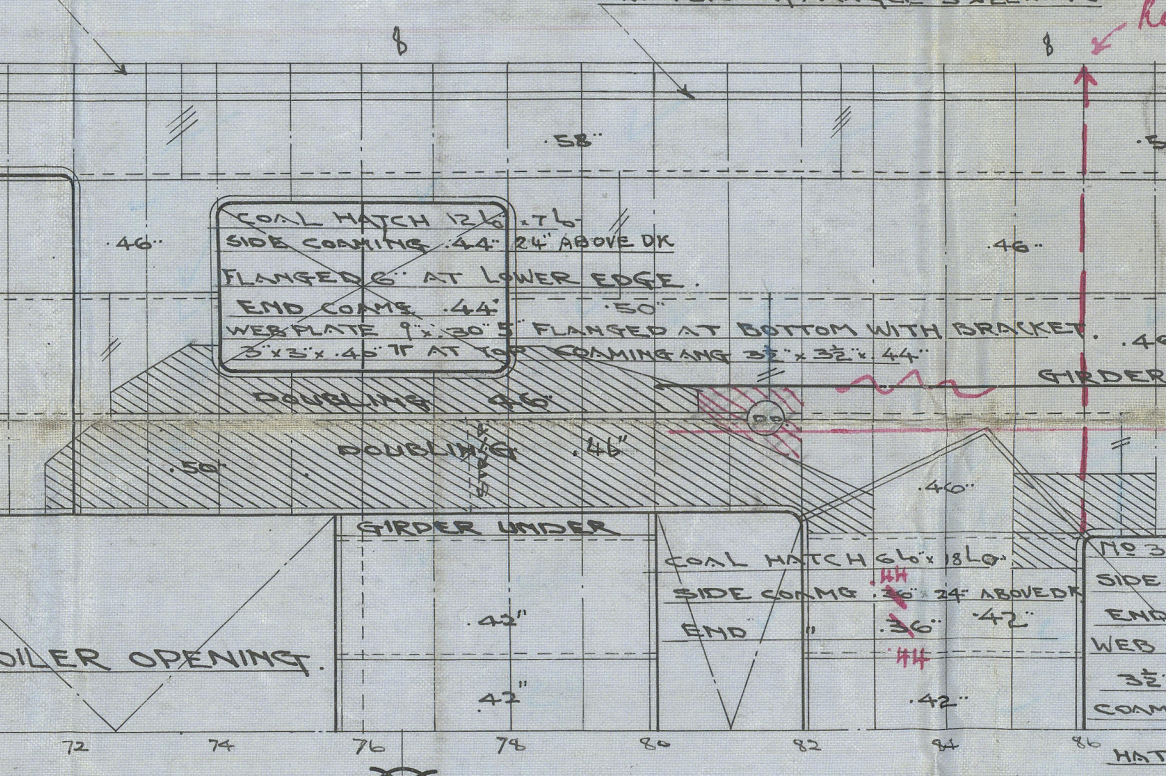



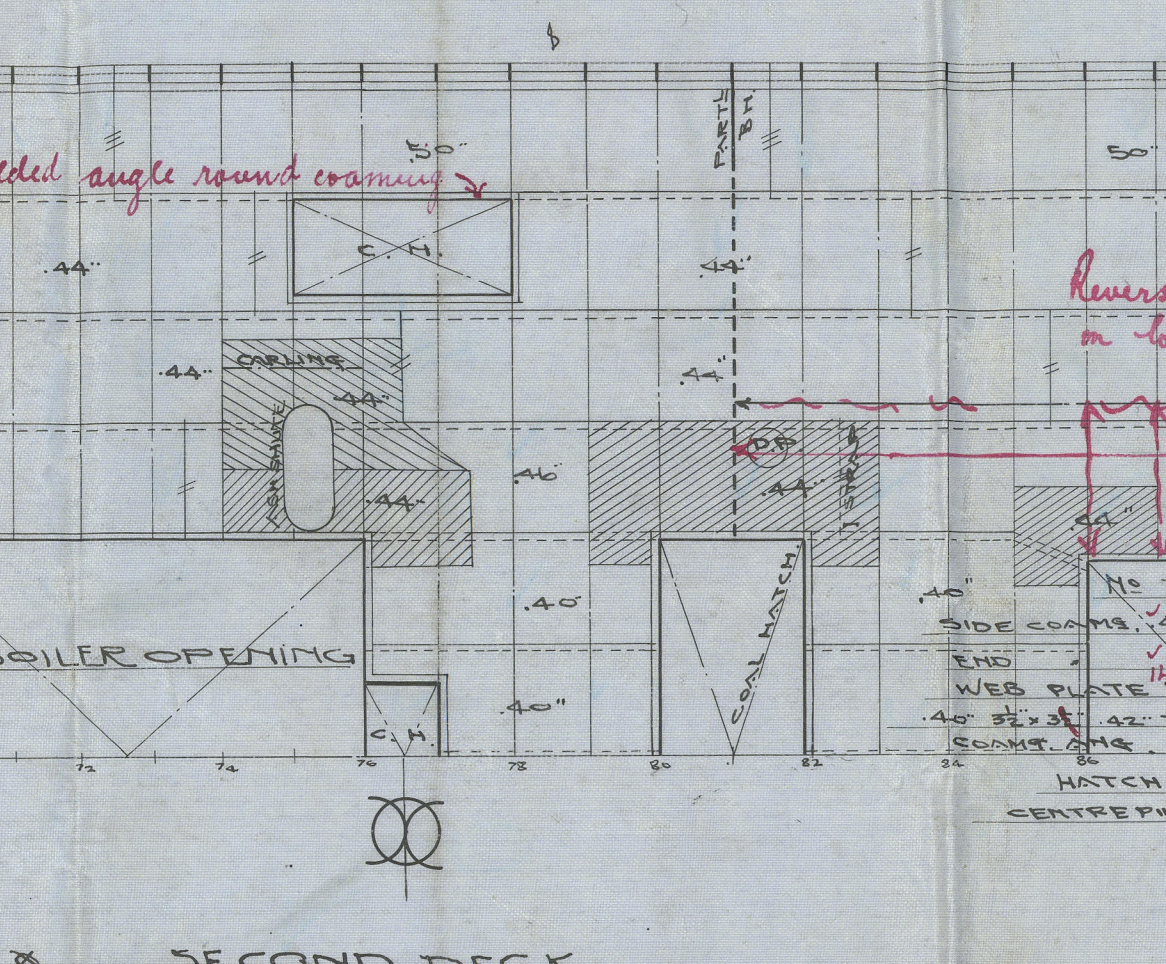



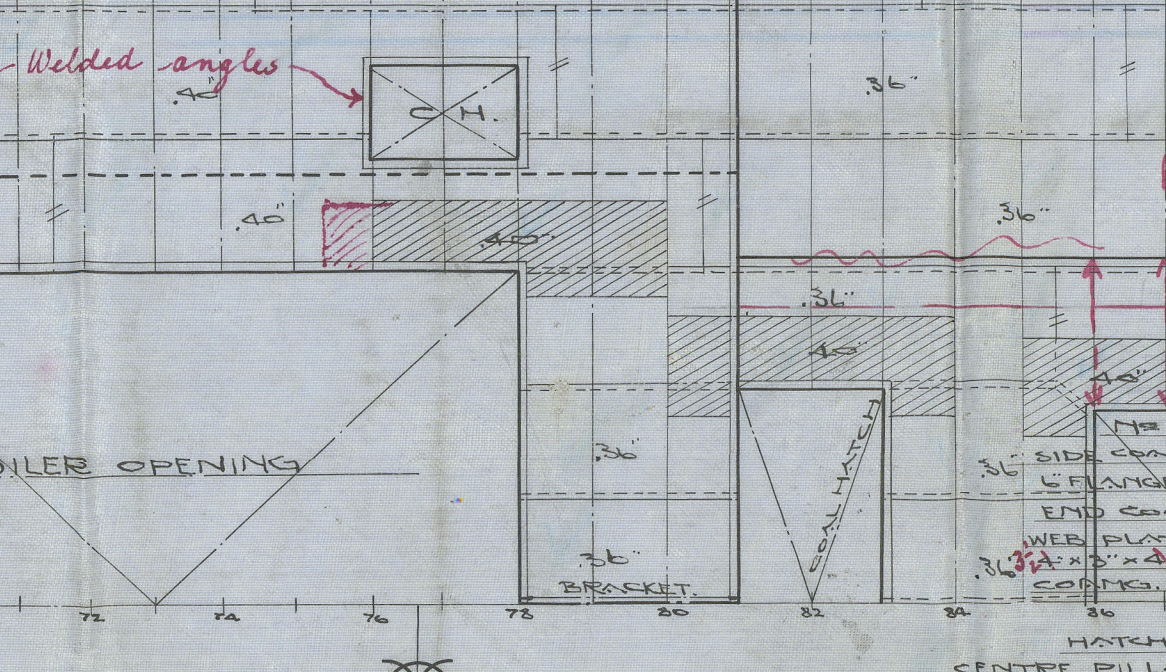



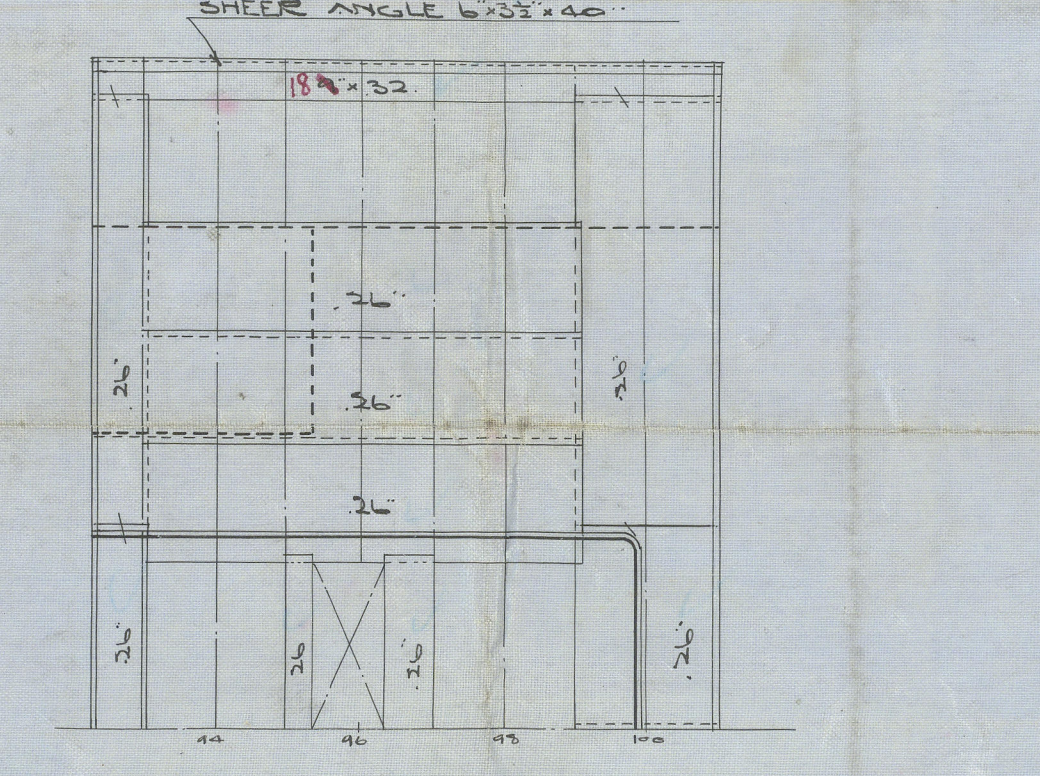



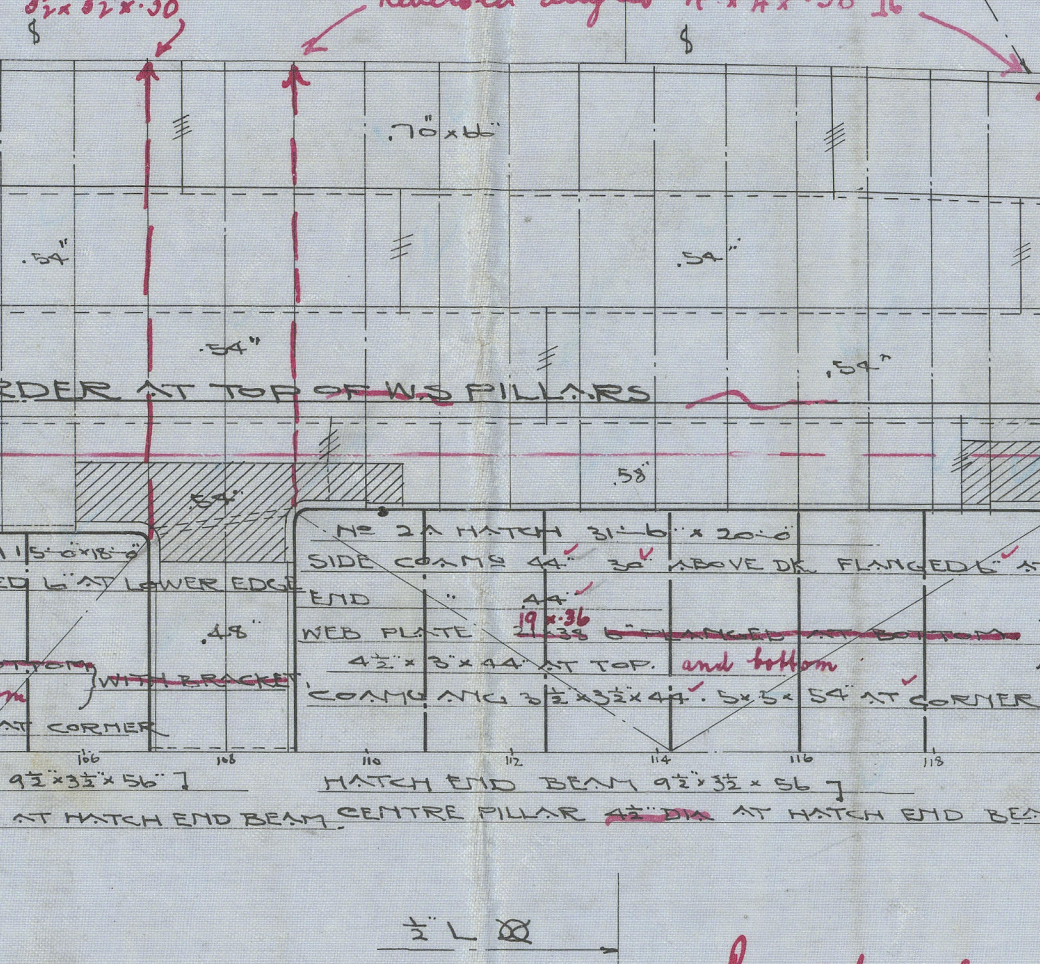



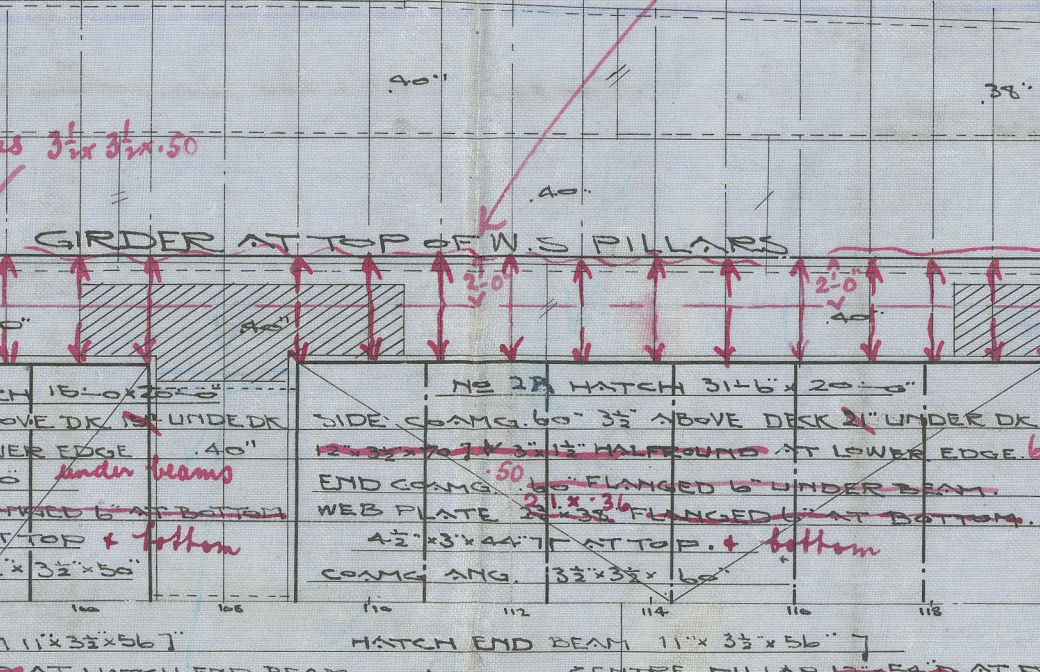



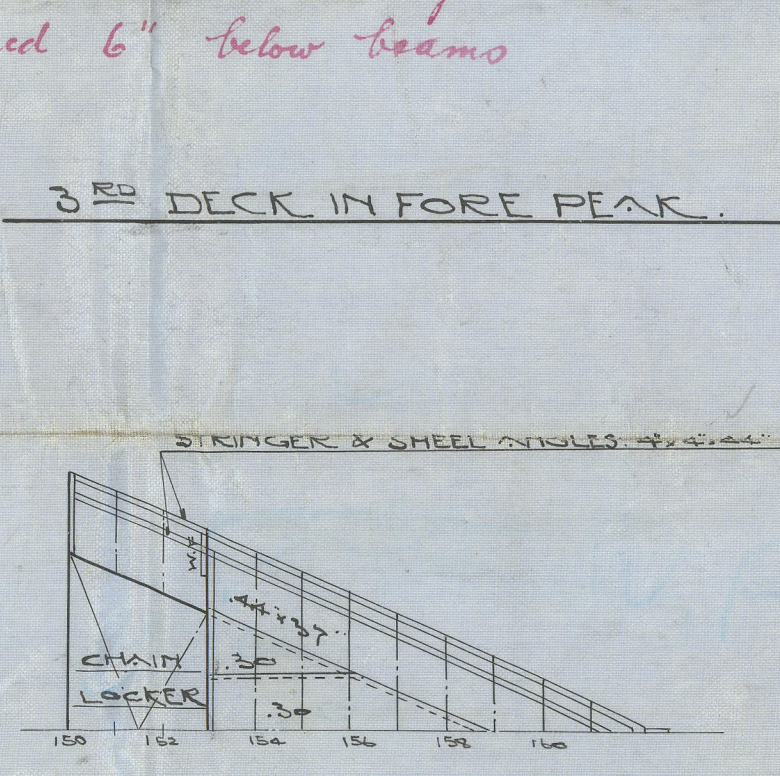



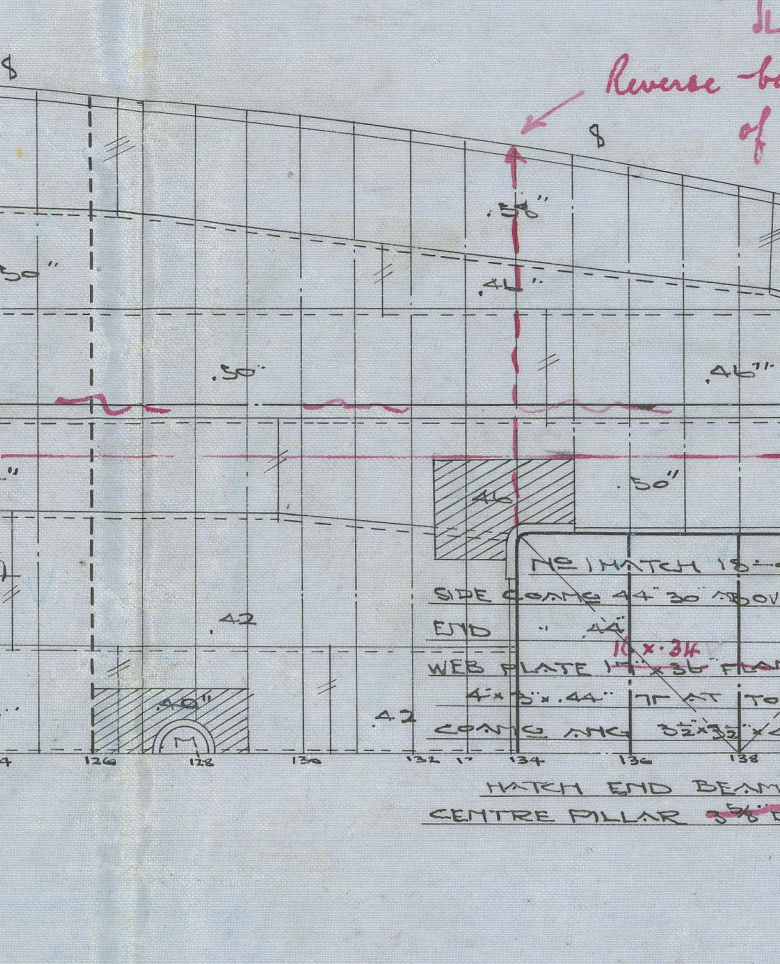



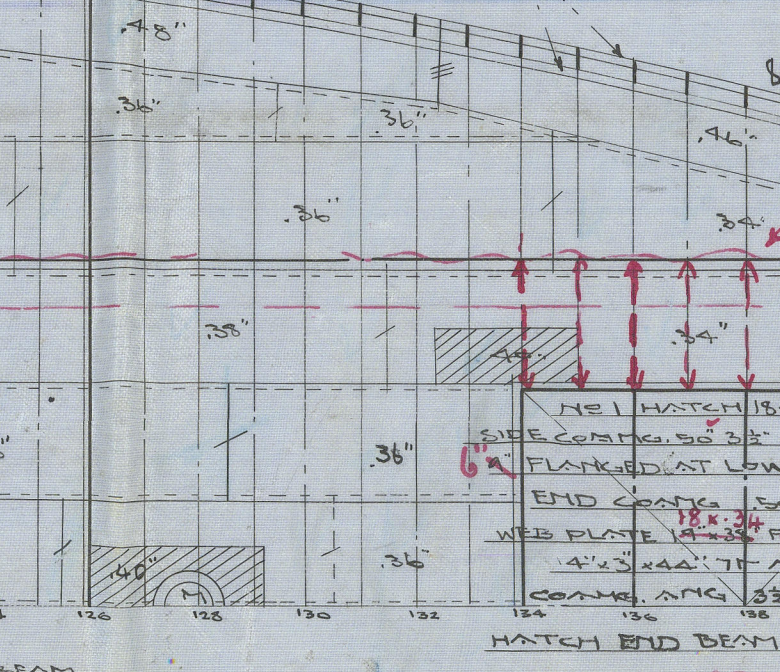



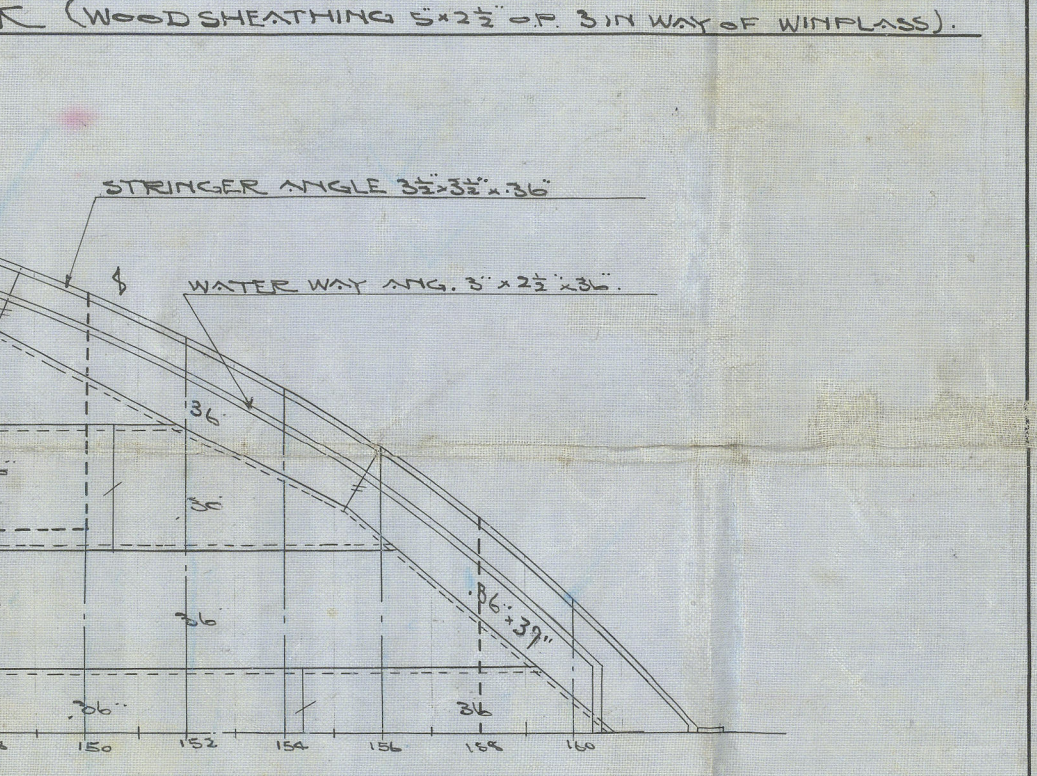


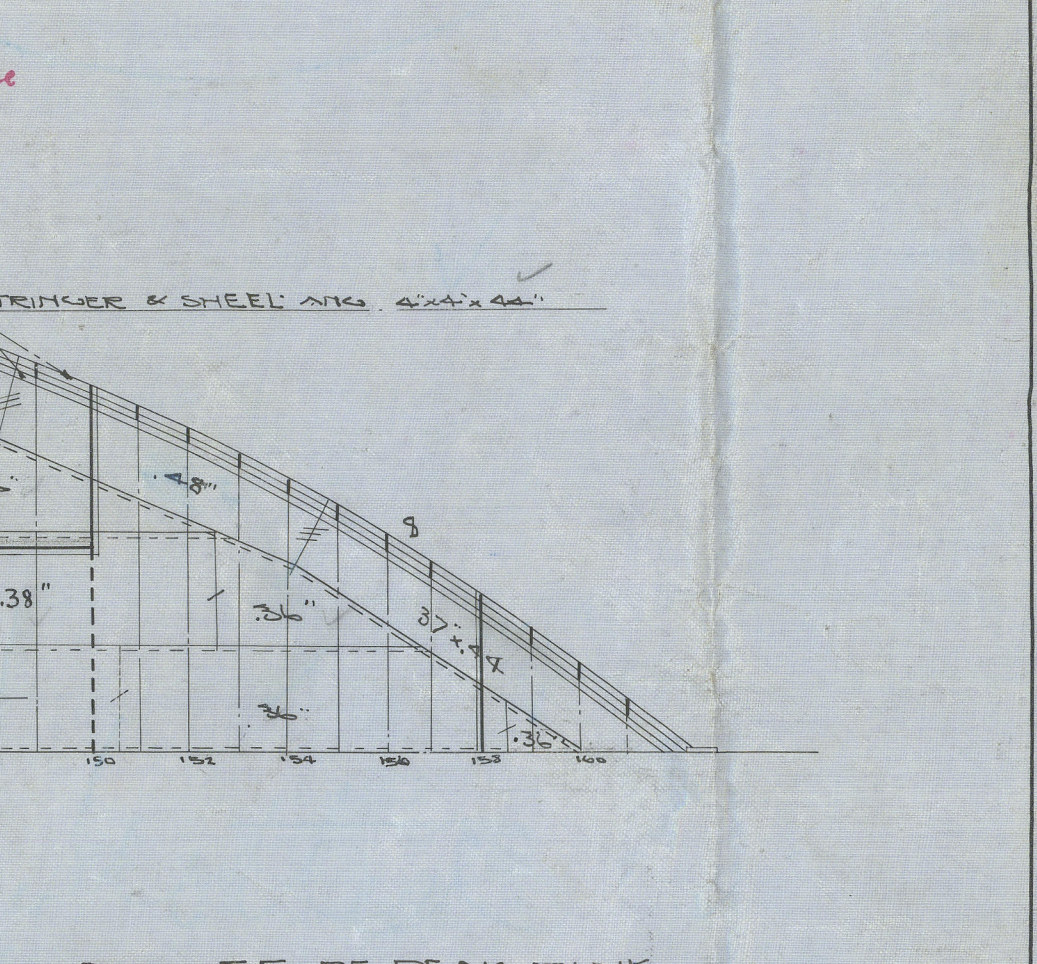


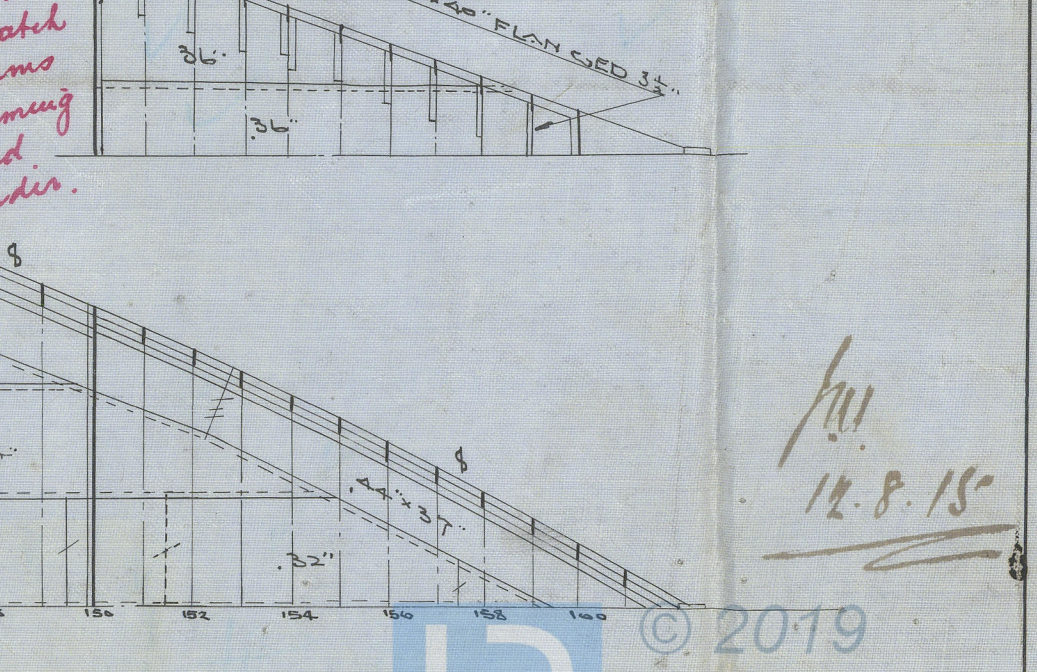

Kawasaki No 380-2

Construction Profile
and Deck Plans.

+ Nos. 389 - 390

Signigo Exam-
n 380

Rudder

T. S. S. War Sailor

Hawasaki No 390

Make Rpt No 2049

HATARANA