


Plan of underside of Liner

Noted
R.M.
11-2-38

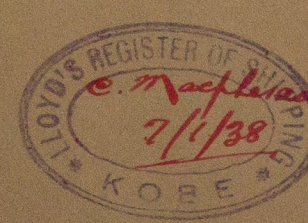

Number for 1 cylinder

Pos	Description	Pcs	Stock No	Material	Pattern No	Weight p pce
4.	Copper Joint	1		Copper		
3.	Copper Joint	1		Copper		
2.	Rubber Packing	2		Rubber ring		
1.	Cylinder Liner	1		P.C.I.K.		

Order No		Delivery	
Date	Name	Designer	Kiousin Dock
Drawn 5-3-37			Type F. 14
Checked		Engineer in chief	Shanghai
Traced 10-3-37			Dr No 2019
Scale 1:1	Cylinder Liner		1006-a.
Series	Add Sheet		Repl. for: Lloyd's Register Foundation

W177-0169

Ruston & Hornsby Ltd

Eng. Nos. 184215/6

for "Fu Kwang" & "Hai Kwang"

Gms. Rpt. No. 20791

Aux. Eng. Cyl. liner

W177-0169



© 2019

Lloyd's Register
Foundation