


SCALE $\frac{3}{4}$ = 1 FOOT

Note: Stiffeners across 8'-0" span to be spaced 24" apart.

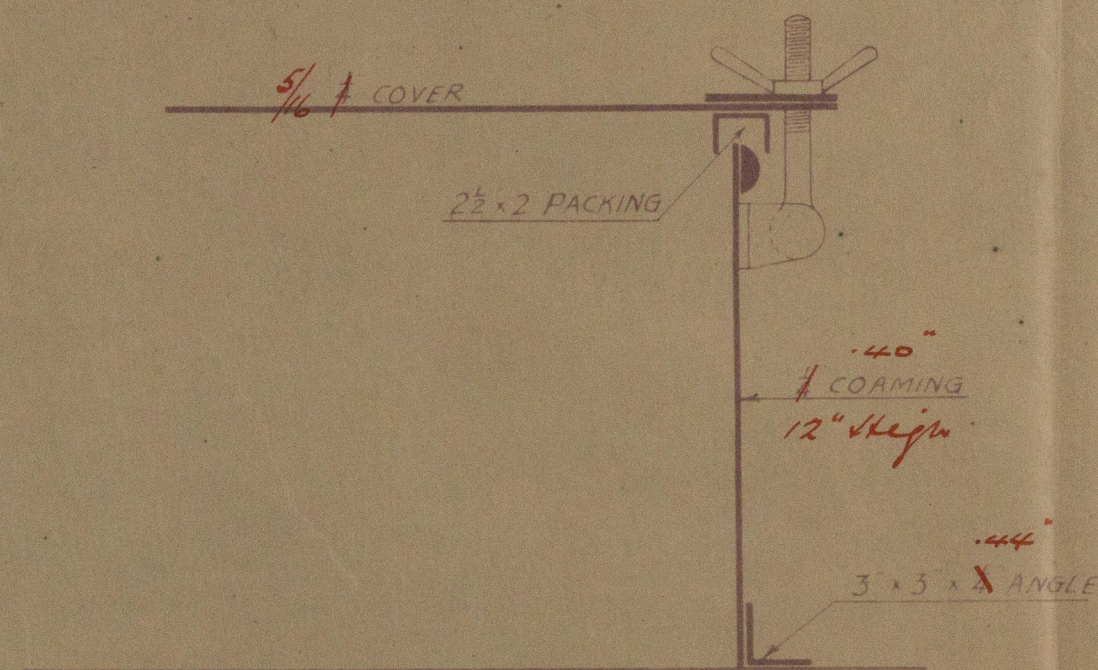


SCALE $\frac{1}{2}$ = 1 FOOT


Kai Kwang
S V SHU KWANG

GASTIGHT HATCH & DETAIL OF DOGS

SCALE AS MARKED

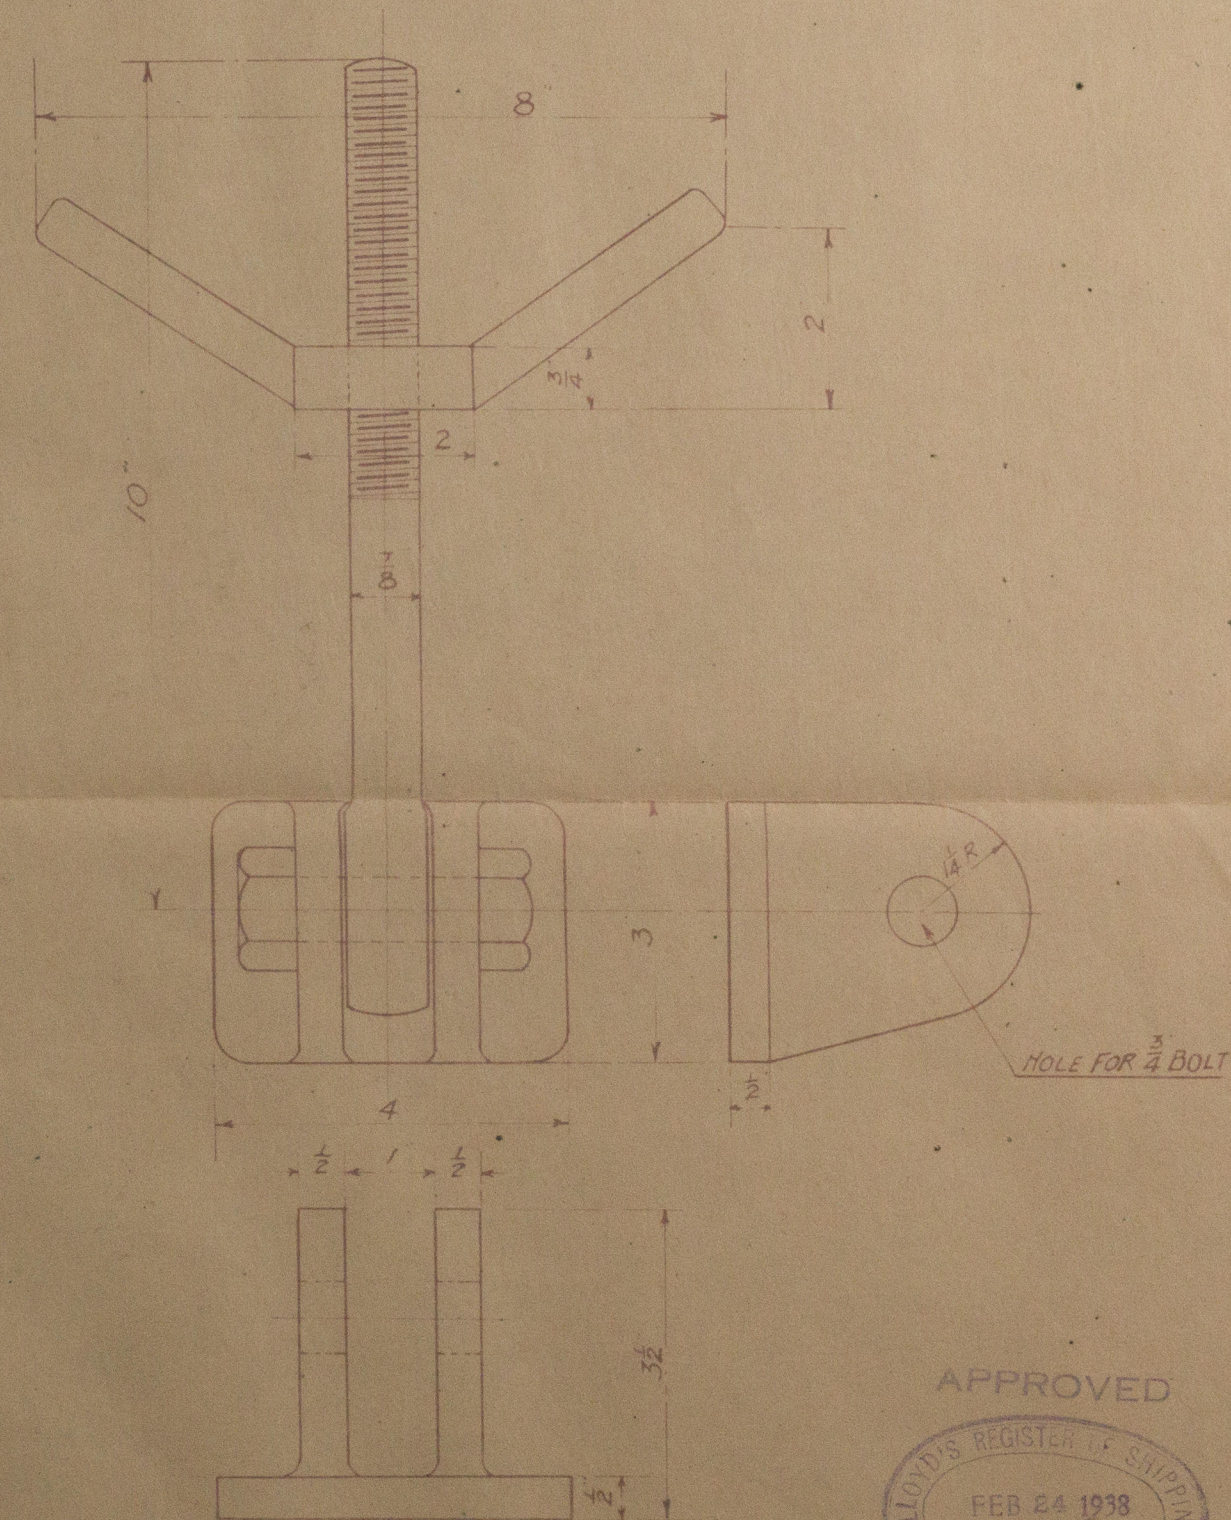

DETAIL OF DOGS
HALF SIZE

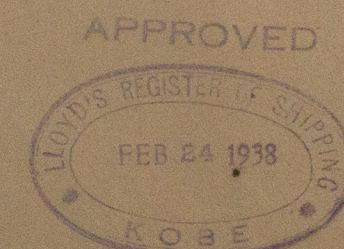

N 42

W177-0176

Rpt. No. 4563, 7-9-39

SHW KWANG

G.T. Hatch

W177 - 0176



© 2019

Lloyd's Register
Foundation