


RE-ARRANGEMENT OF ACCOMMODATION M.V. HAI KWANG

SCALE 1/4" = 1 FOOT.


BHD.  
SPECIFIED  
IN ITEM (4)

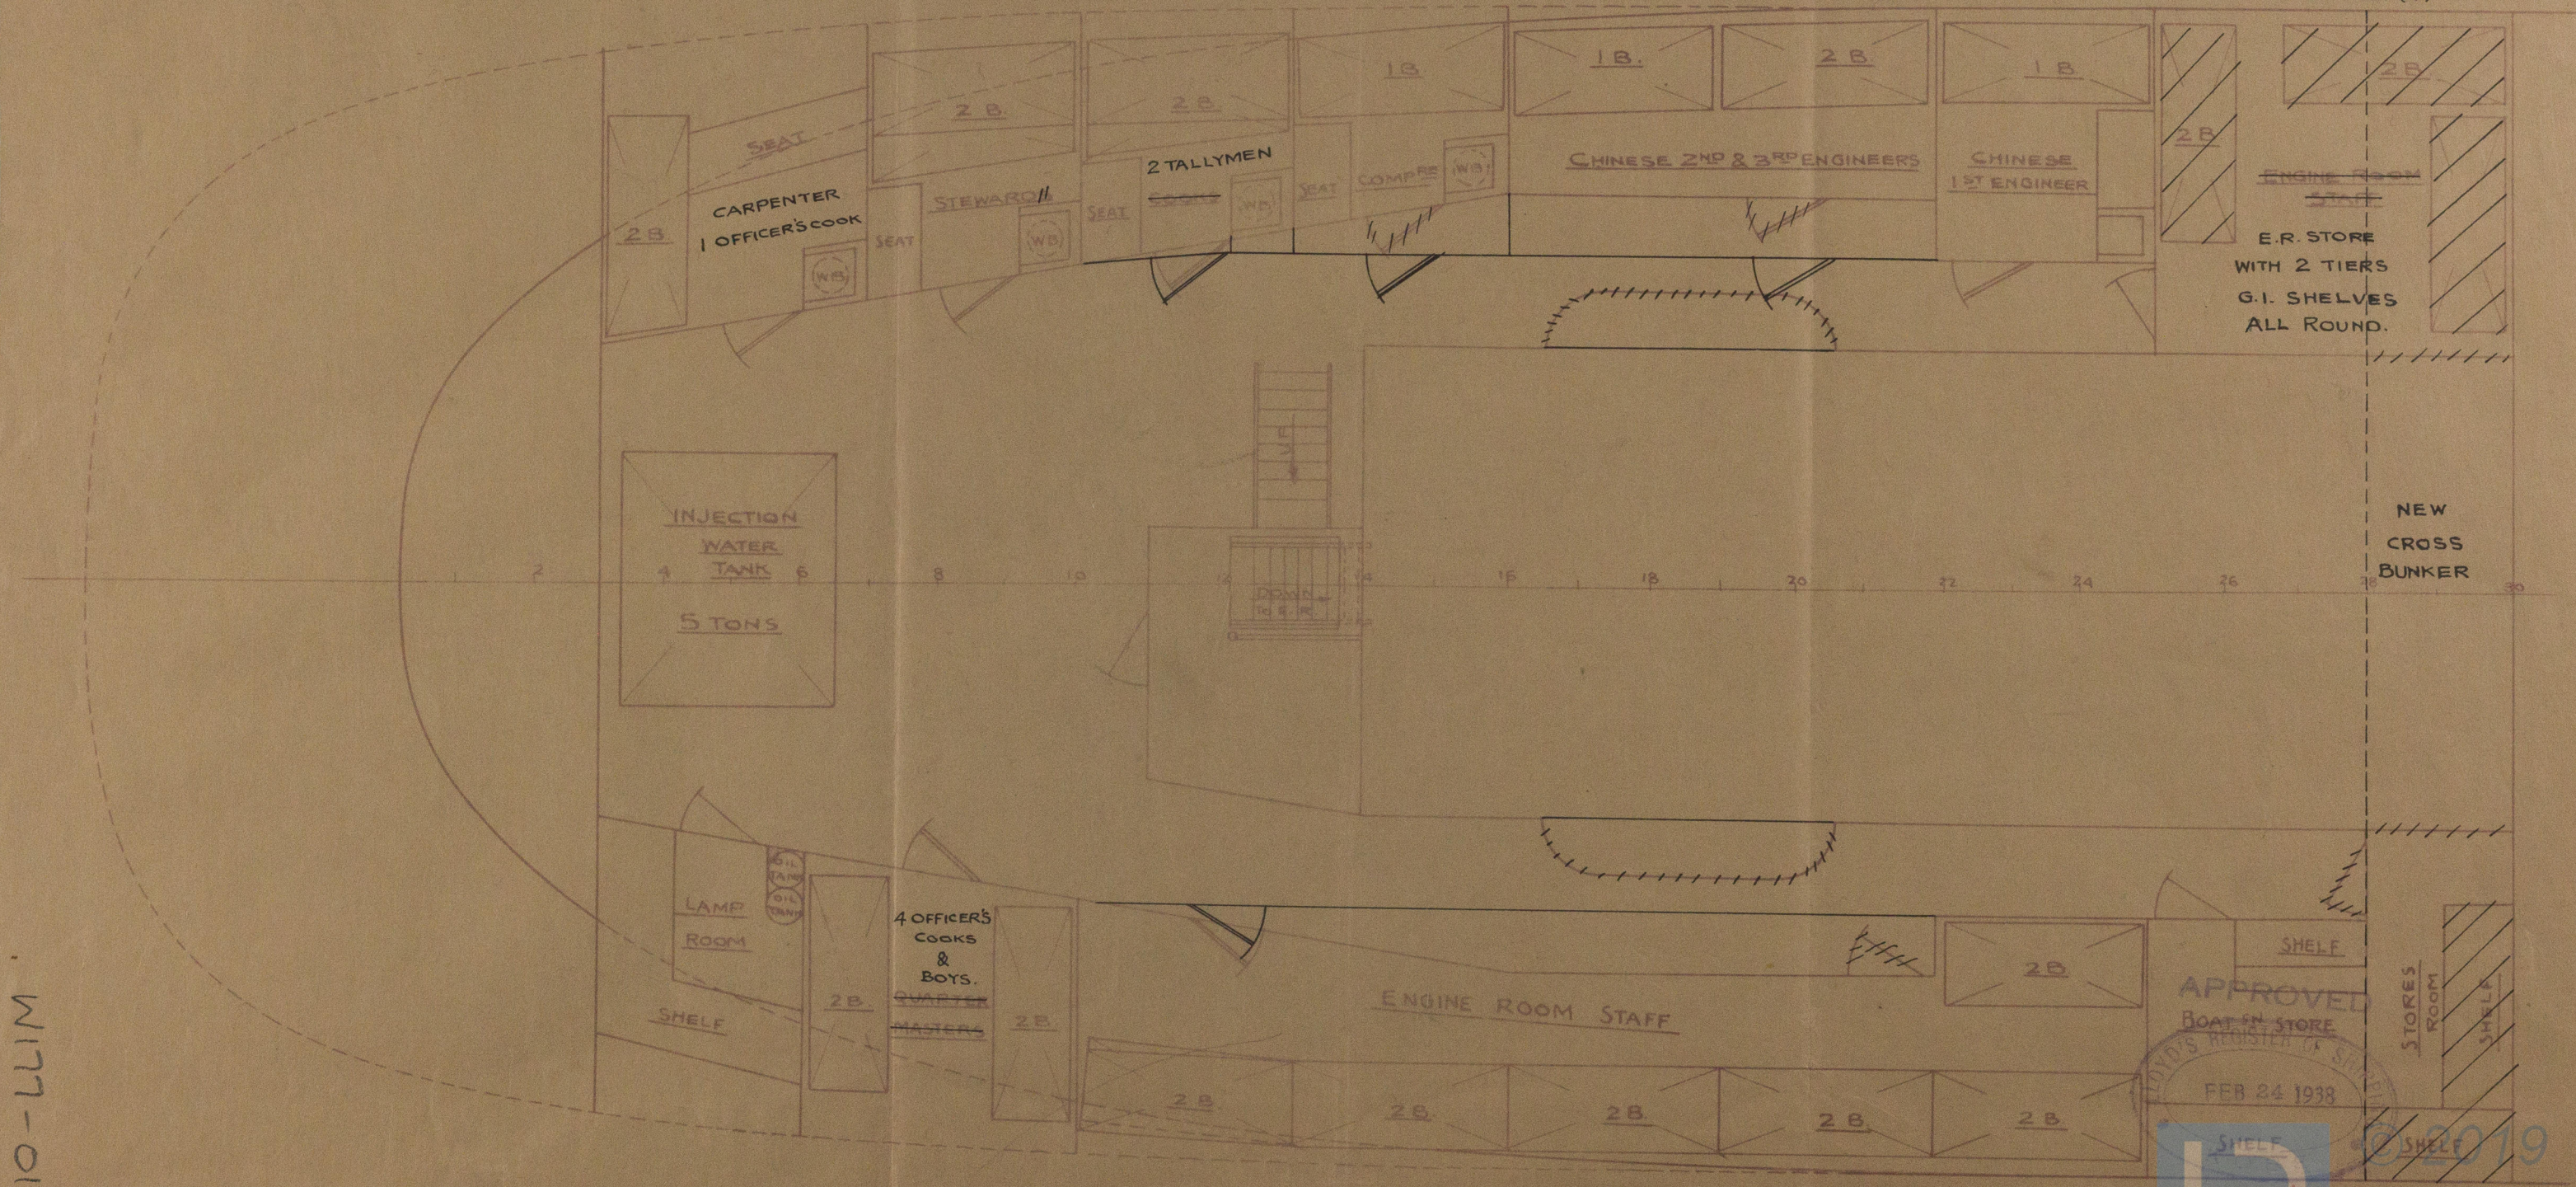

W177-0178

W109

APPROVED  
BOAT IN STORE  
FEB 24 1938

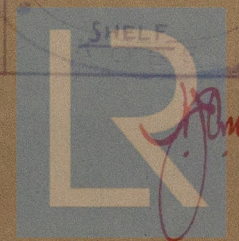

Lloyd's Register  
Foundation



Rpt 4563, 7-9-39

HAI KWANG

Main Deck Accommodation

W177-0178



© 2019

Lloyd's Register  
Foundation