


M. V. HAI KWANG
TWIN SCREW MOTOR DRIVEN
BULK OIL VESSEL

| DIMENSIONS | |
|---------------------------|------------|
| LENGTH OVERALL | 198'-0" |
| LENGTH B. P. | 190'-0" |
| BREADTH MOULDED | 32'-0" |
| DEPTH MLD. TO MAIN DECK | 10'-7 1/2" |
| DEPTH MLD. TO AWNING DECK | 17'-7 1/2" |

SCALE 1/4 INCH TO ONE FOOT.

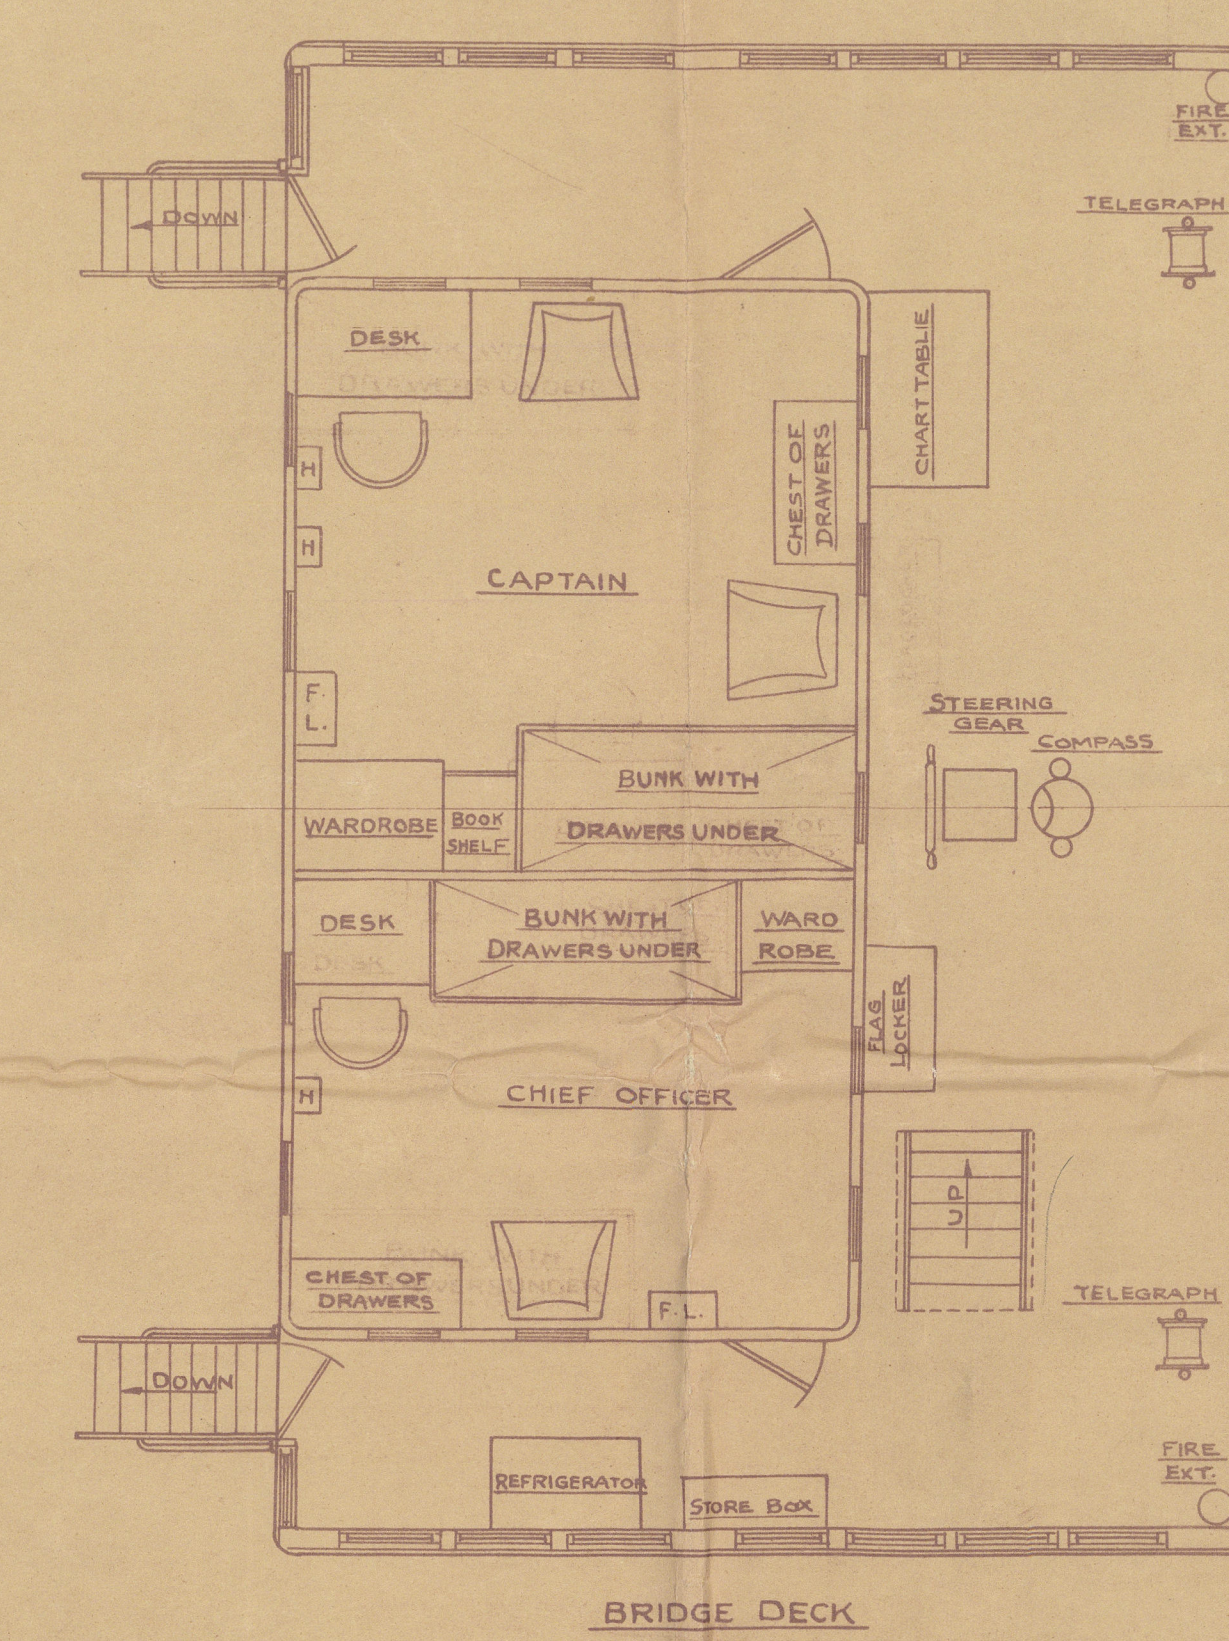

Hai Kwan

General Arrangement.

corrected 7.39.

(Report No. 4563
dated 4-9-39)

W177-0182



© 2019

Lloyd's Register
Foundation