


M. V. HAI KWANG  
SHIP N° 568  
ARRANGEMENT OF  
CARGO OIL PUMP  
SUCTIONS & DISCHARGES  
SCALE 1/2"=1 FOOT  
SHEET N° 1

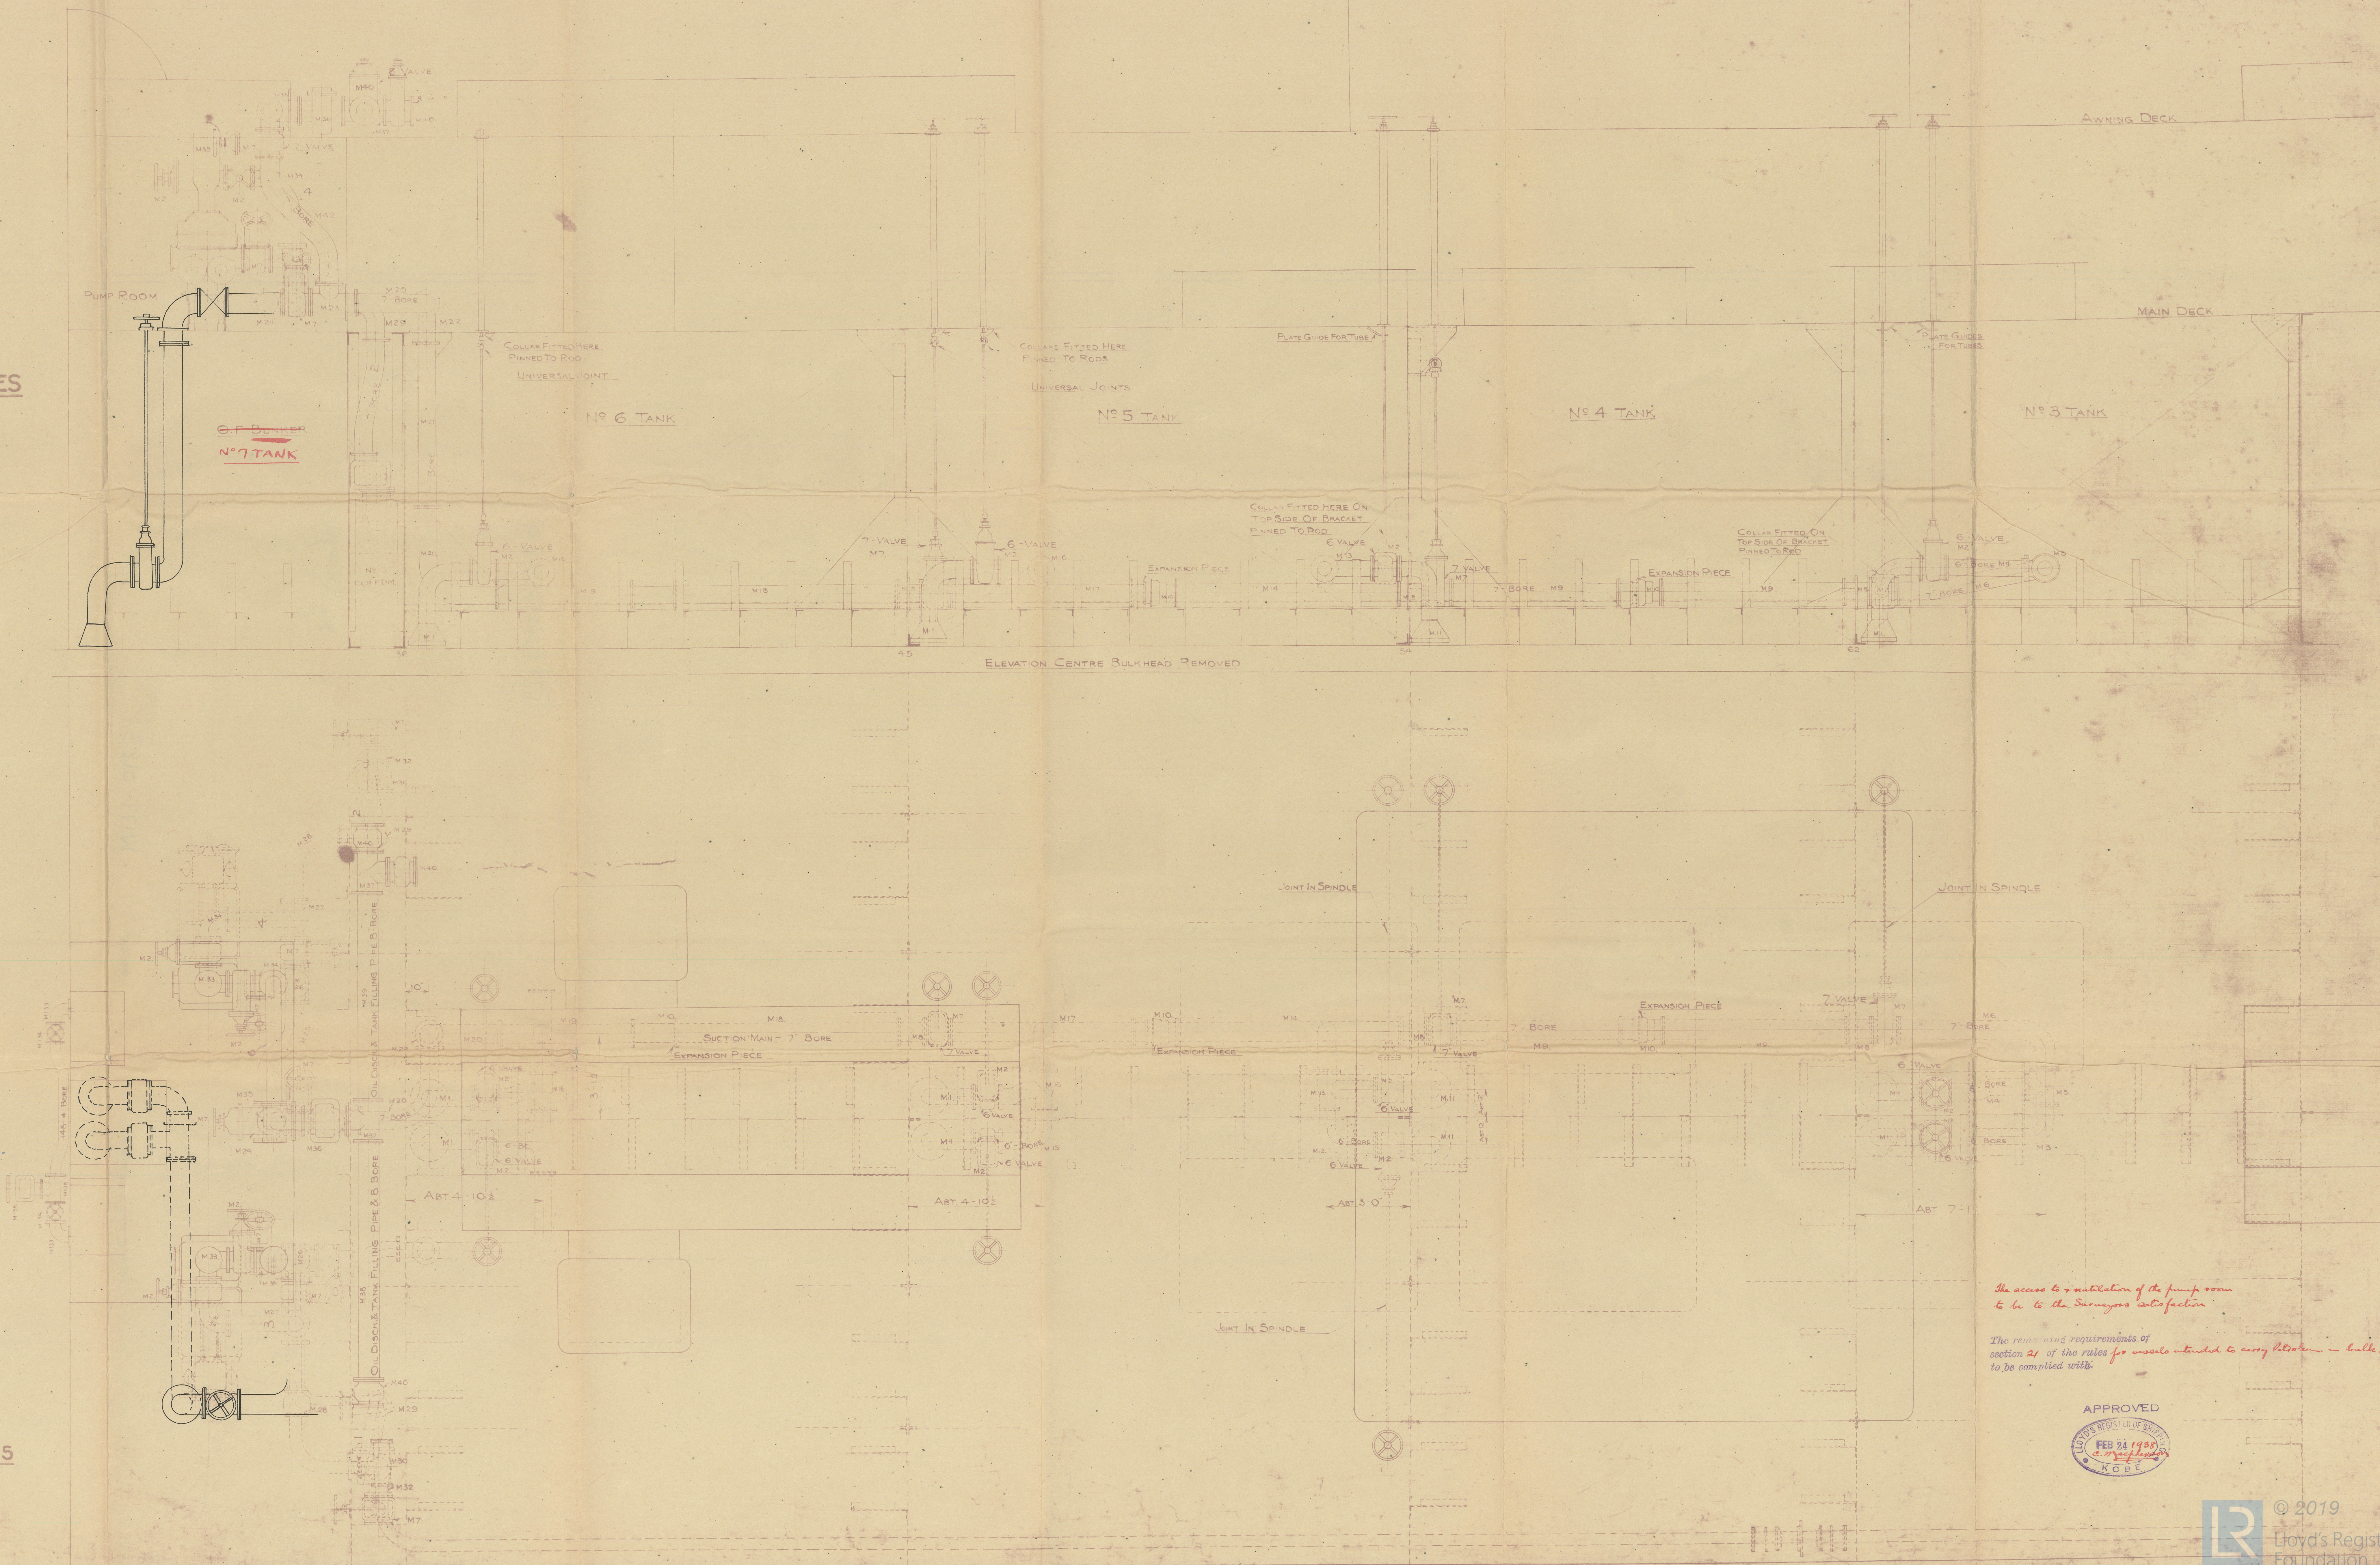

DRAWING N° 524/25

W 3





Rpt No. 4563, 7-9-39

HAI KWANG

Cargo Oil Pumping Arrangements

W177-0183



© 2019

Lloyd's Register  
Foundation