



$$\begin{array}{r} 6.25 \\ 4.14 \\ \hline 2.13 \end{array}$$


LOWER NAVIGATING BRIDGE

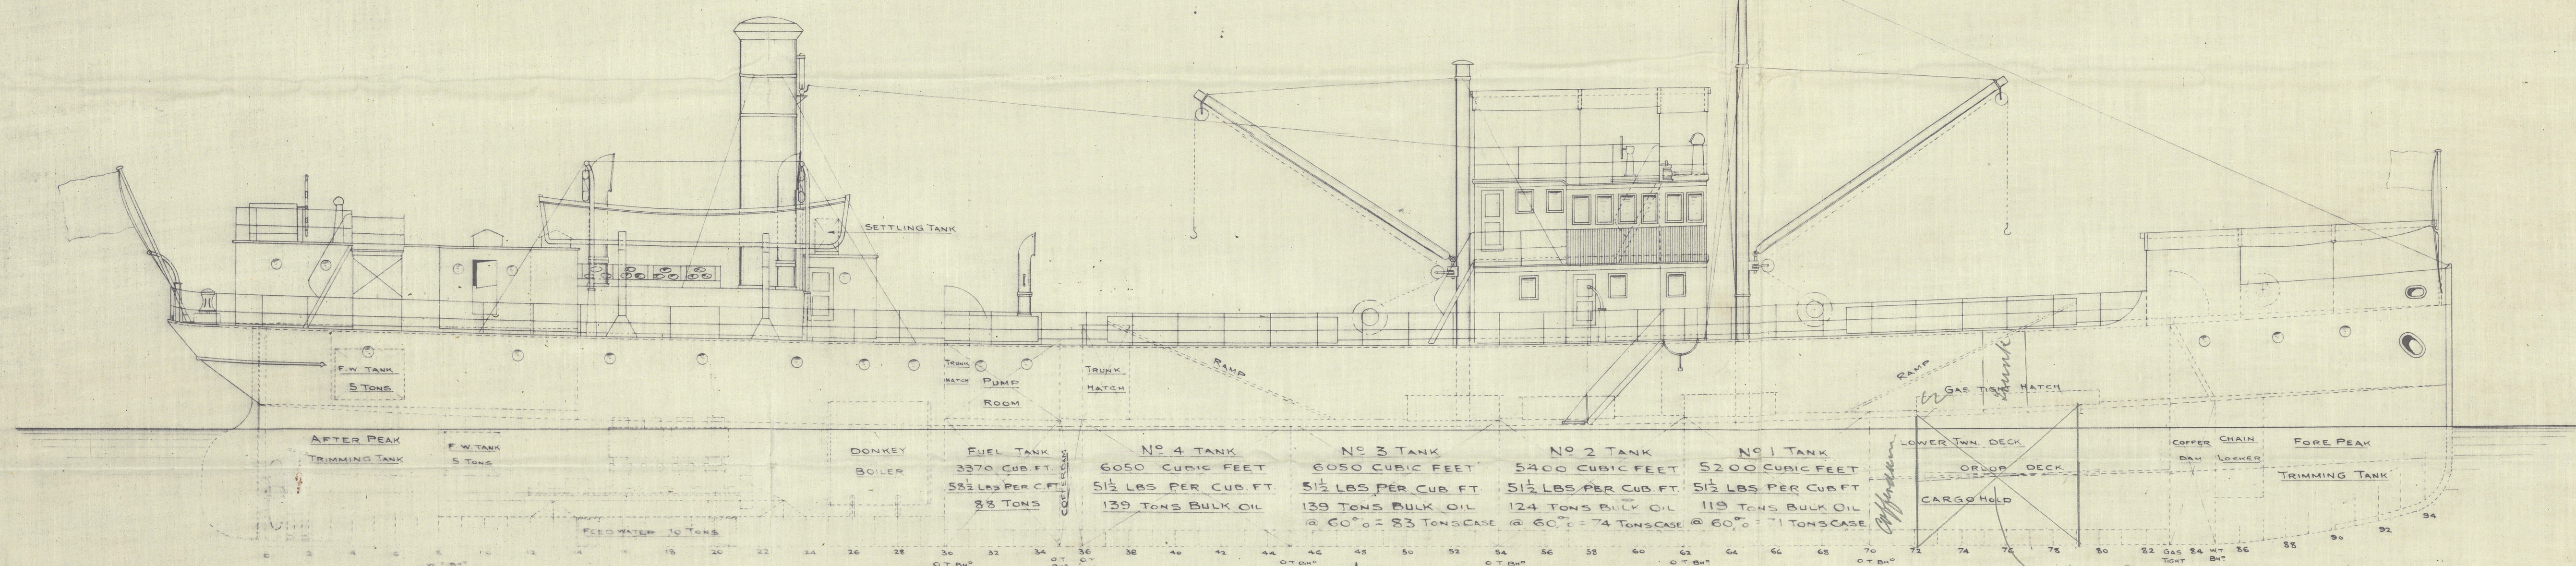

Tank for carrying solar oil
constructed Oct-1929

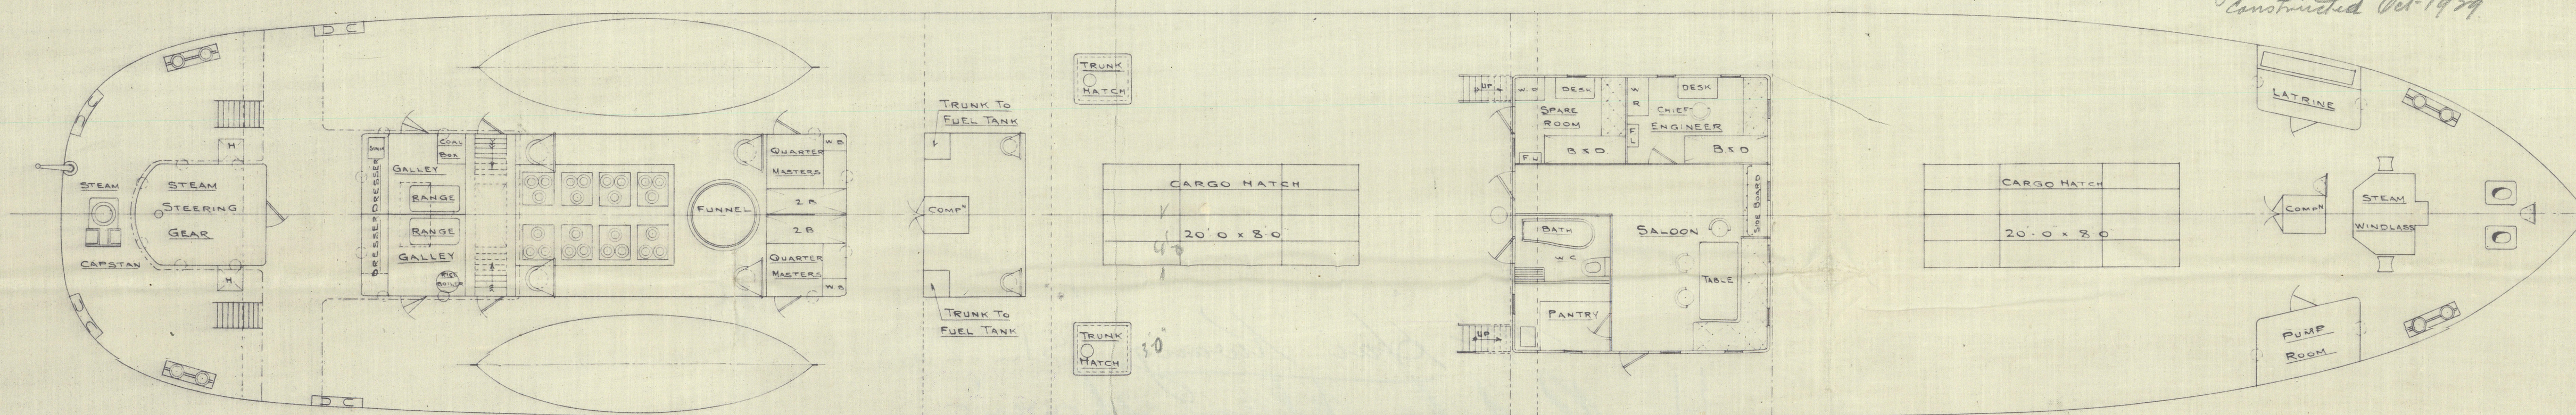


AWNING DECK

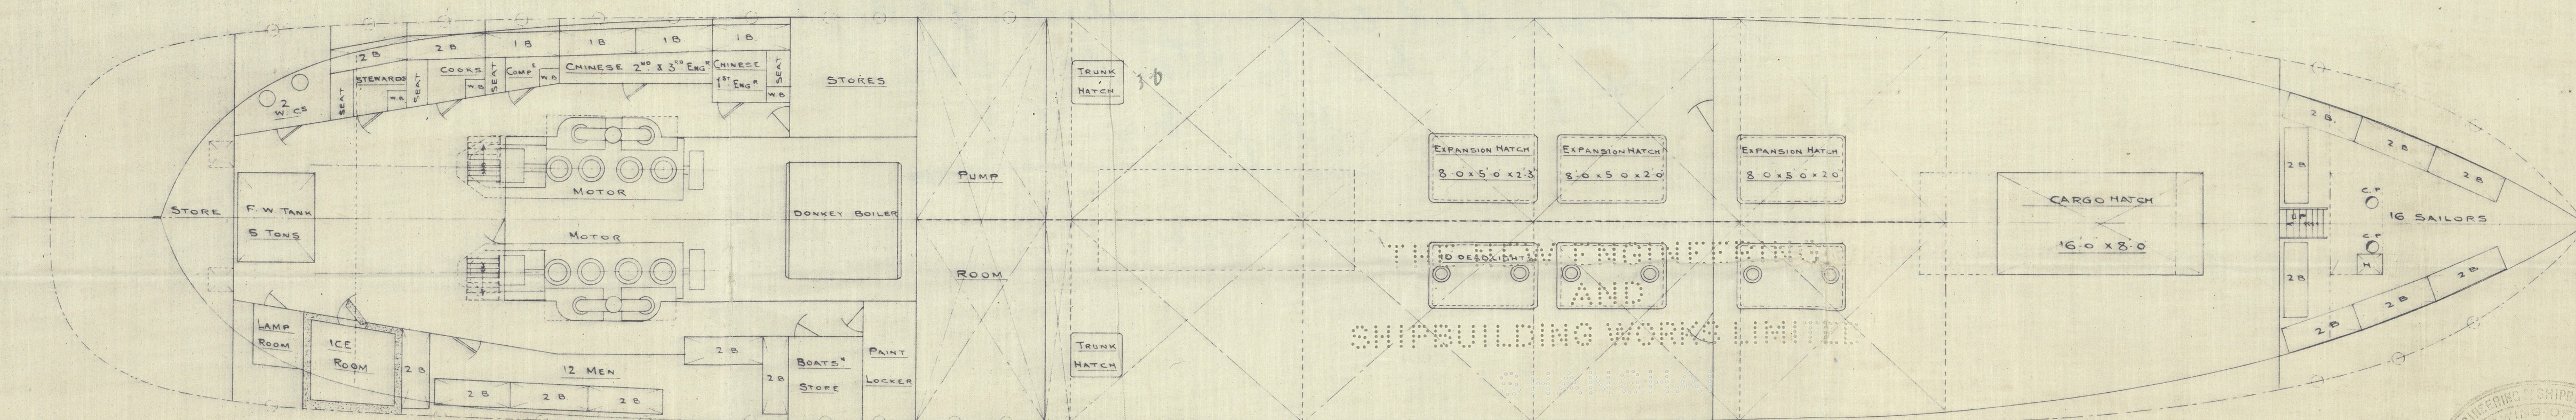

MAIN DECK

DRAWING N^o $\frac{51}{25}$

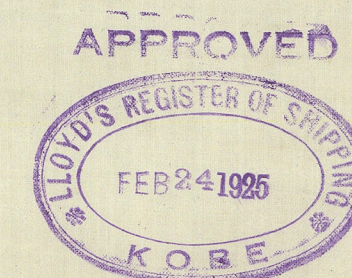

See letter 24/2/28
H. Cox.



Surveyor

Shanghai

Mr. Hai Kwang

Shi. 2363.

Profile plan showing
amended arrangement of cargo
& fuel bunker tanks etc.

Ship No. 68

© 2019

W177-0195



Lloyd's Register
Foundation