
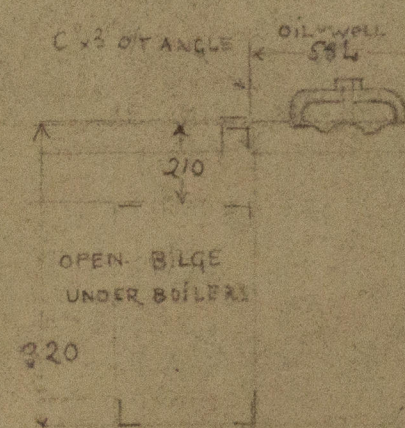


S.S. "HANNE" EX "CITY OF BRADFORD"

PROPOSED CONVERSION OF CROSS-BUNKER TO OILTIGHT OF BUNKER FOR BOILER FUEL, FLASH-POINT ABOVE 150°F.

Owners informed 3/2/37.

Additional beams may be omitted provided plating be stiffened between existing beams to Surveyors satisfaction.

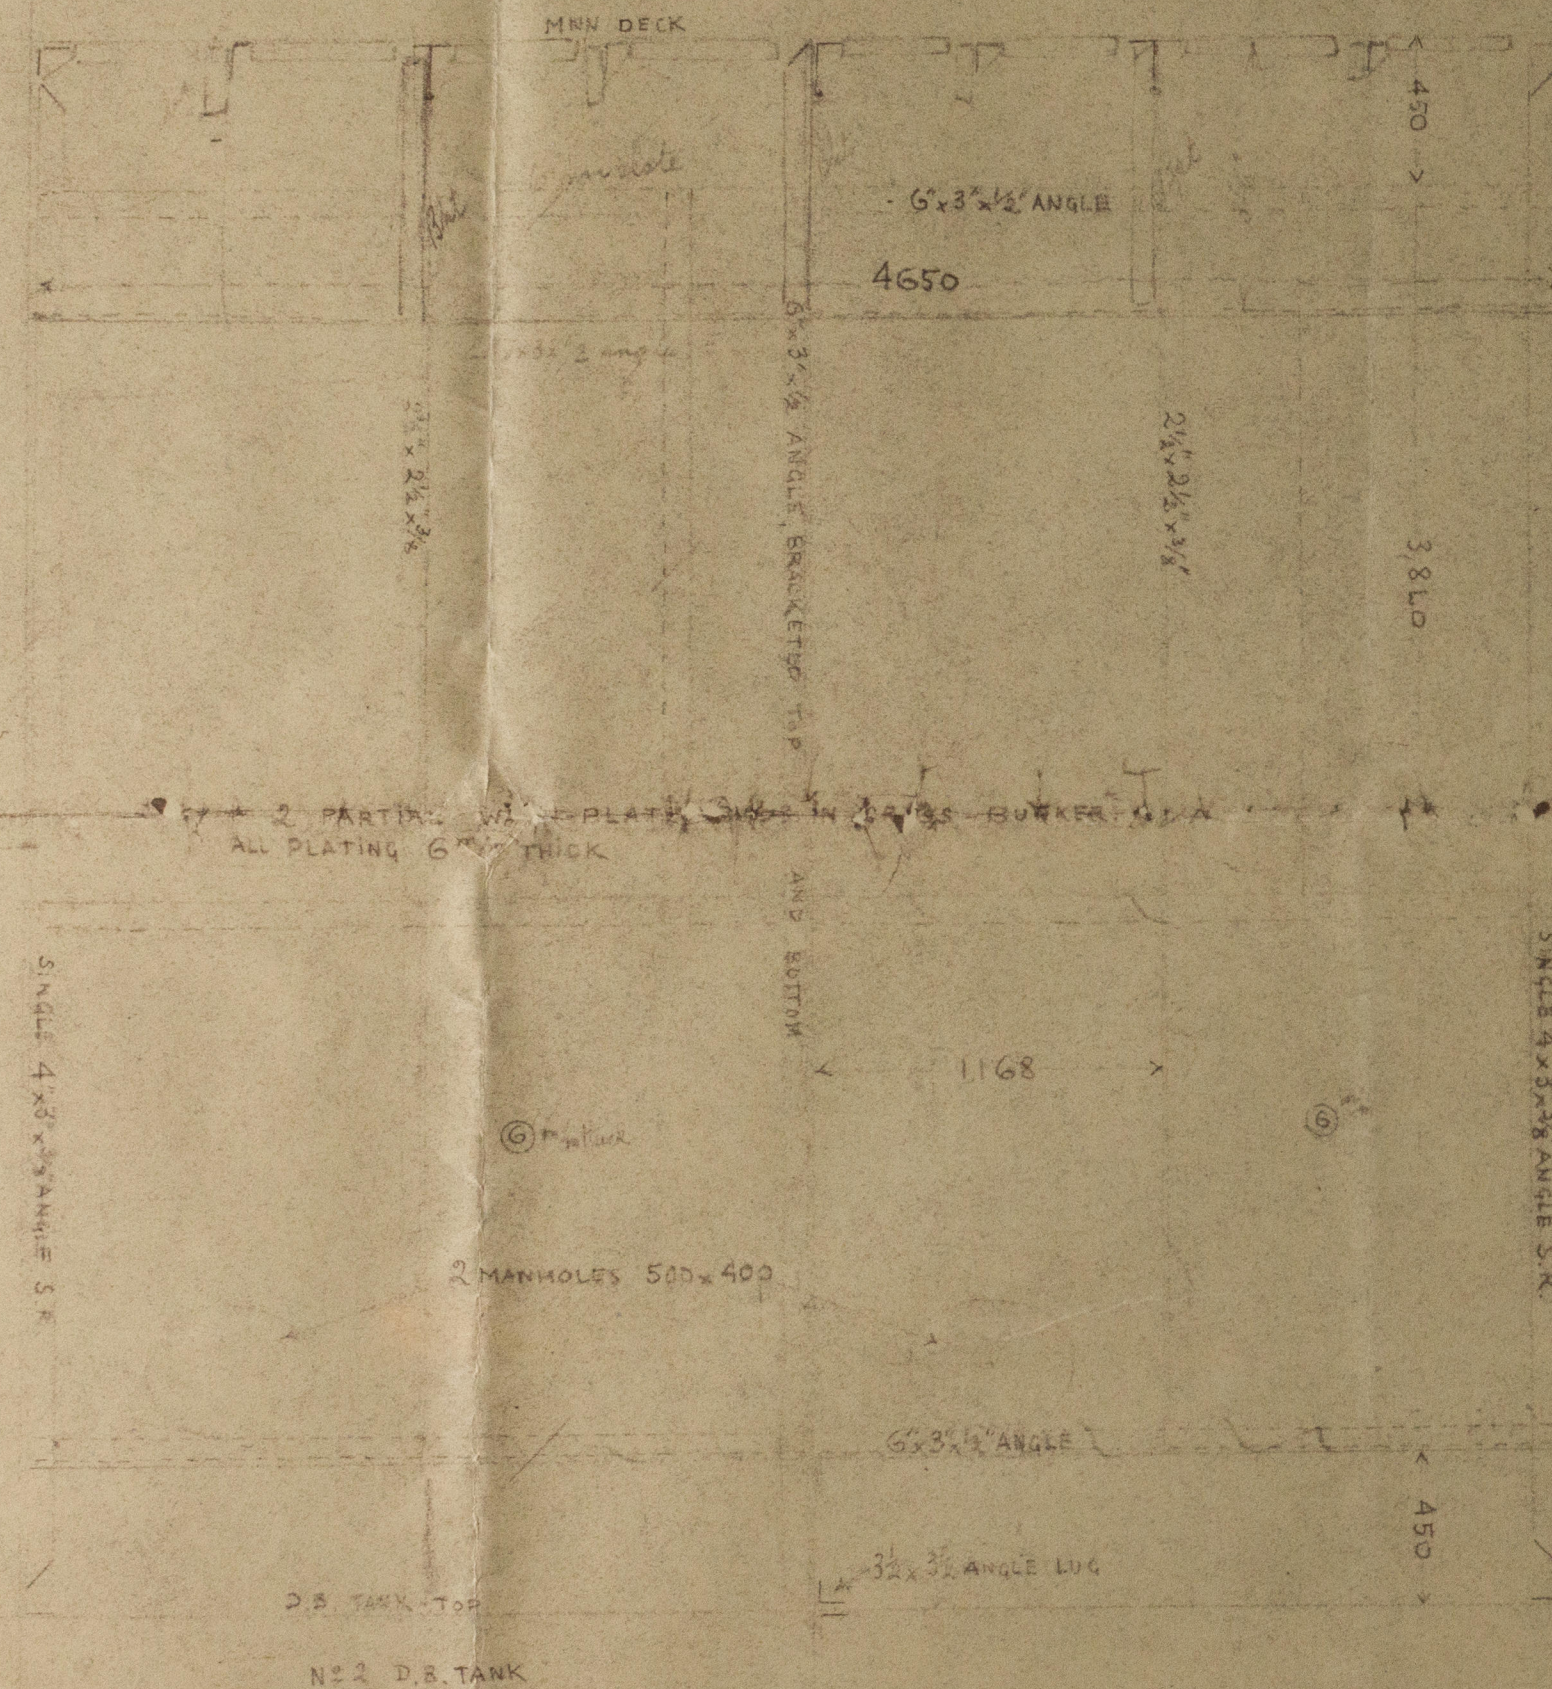

NO. 2 WATER BALLAST TANK 135 TONS
W/T & DIVISION



Sp. "Hanne" Ala. Sept. No. 1474.

HANNE



© 2019

Lloyd's Register
Foundation

W178-0031