


Duplicate of plan approved by
Secretary's letter of 26/3/29
T.B.D.D.

BOILERS №2581.2403.4.

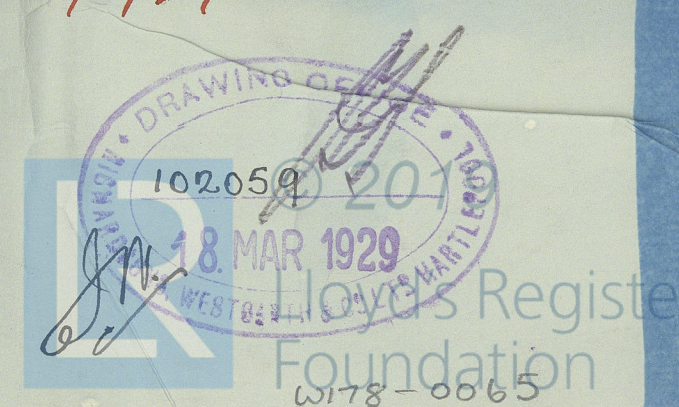

Boilers

2581

RICHARDSONS,

WESTGARTH. SL

No. 2581.

Main Boilers


Hadleigh

P.S. Mdb. 13936.

No. 6735
LLOYD'S TEST.
350 lbs.
WP 200lbs.
18.9.29 P.T.B.

C.

No. 6738
LLOYD'S TEST.
350 lbs.
WP 200lbs.
27.9.29 P.T.B.

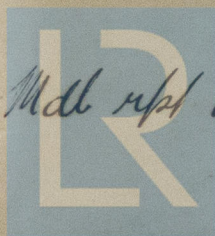

© 2019

Mdb. npt No. 13835

Lloyd's Register
Foundation

W178 - 0065