
 


STEEL SCREW STEAMER No 432.  
-CLASSED \* 100. A. I. LLOYDS REGISTER.  
-PROFILE PLAN.  
SCALE 1/8" = 1 FOOT.

A. VUYK & ZONEN.  
SHIPBUILDERS.  
CAPELLE % YSSEL. HOLLAND.

9.2.14  
21.11.14  
28.4.14  
30.7.14

 




RIVETING -  
MAINDECK PLATING BUTTS LAPPED & TREBLE RIVETED  
BOW & STERN 48 IN RIVERS  
SIDE PLATING BUTTS LAPPED & DOUBLE RIVETED 48 IN RIVERS  

9.2.14

forecastle bulk 18

forecastle bulk 18



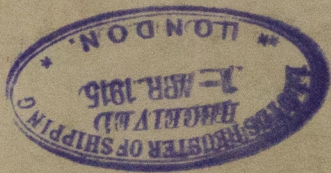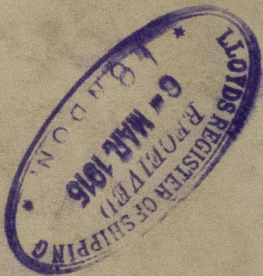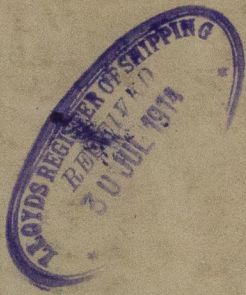


432

Profile & Dh  
A. Vuyk.



"Helena Margareta"  
S. S. Lauenburg  
Rotterdam report no. 9626  
Plan of profile and Dh

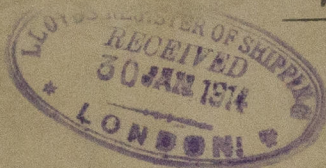

© 2019

Lloyd's Register  
Foundation

W178-0097