


# S.S. HULL TRADER

## PATCHES FITTED TO SHELLS OF PORT. STARB<sup>B</sup> MAIN BOILERS

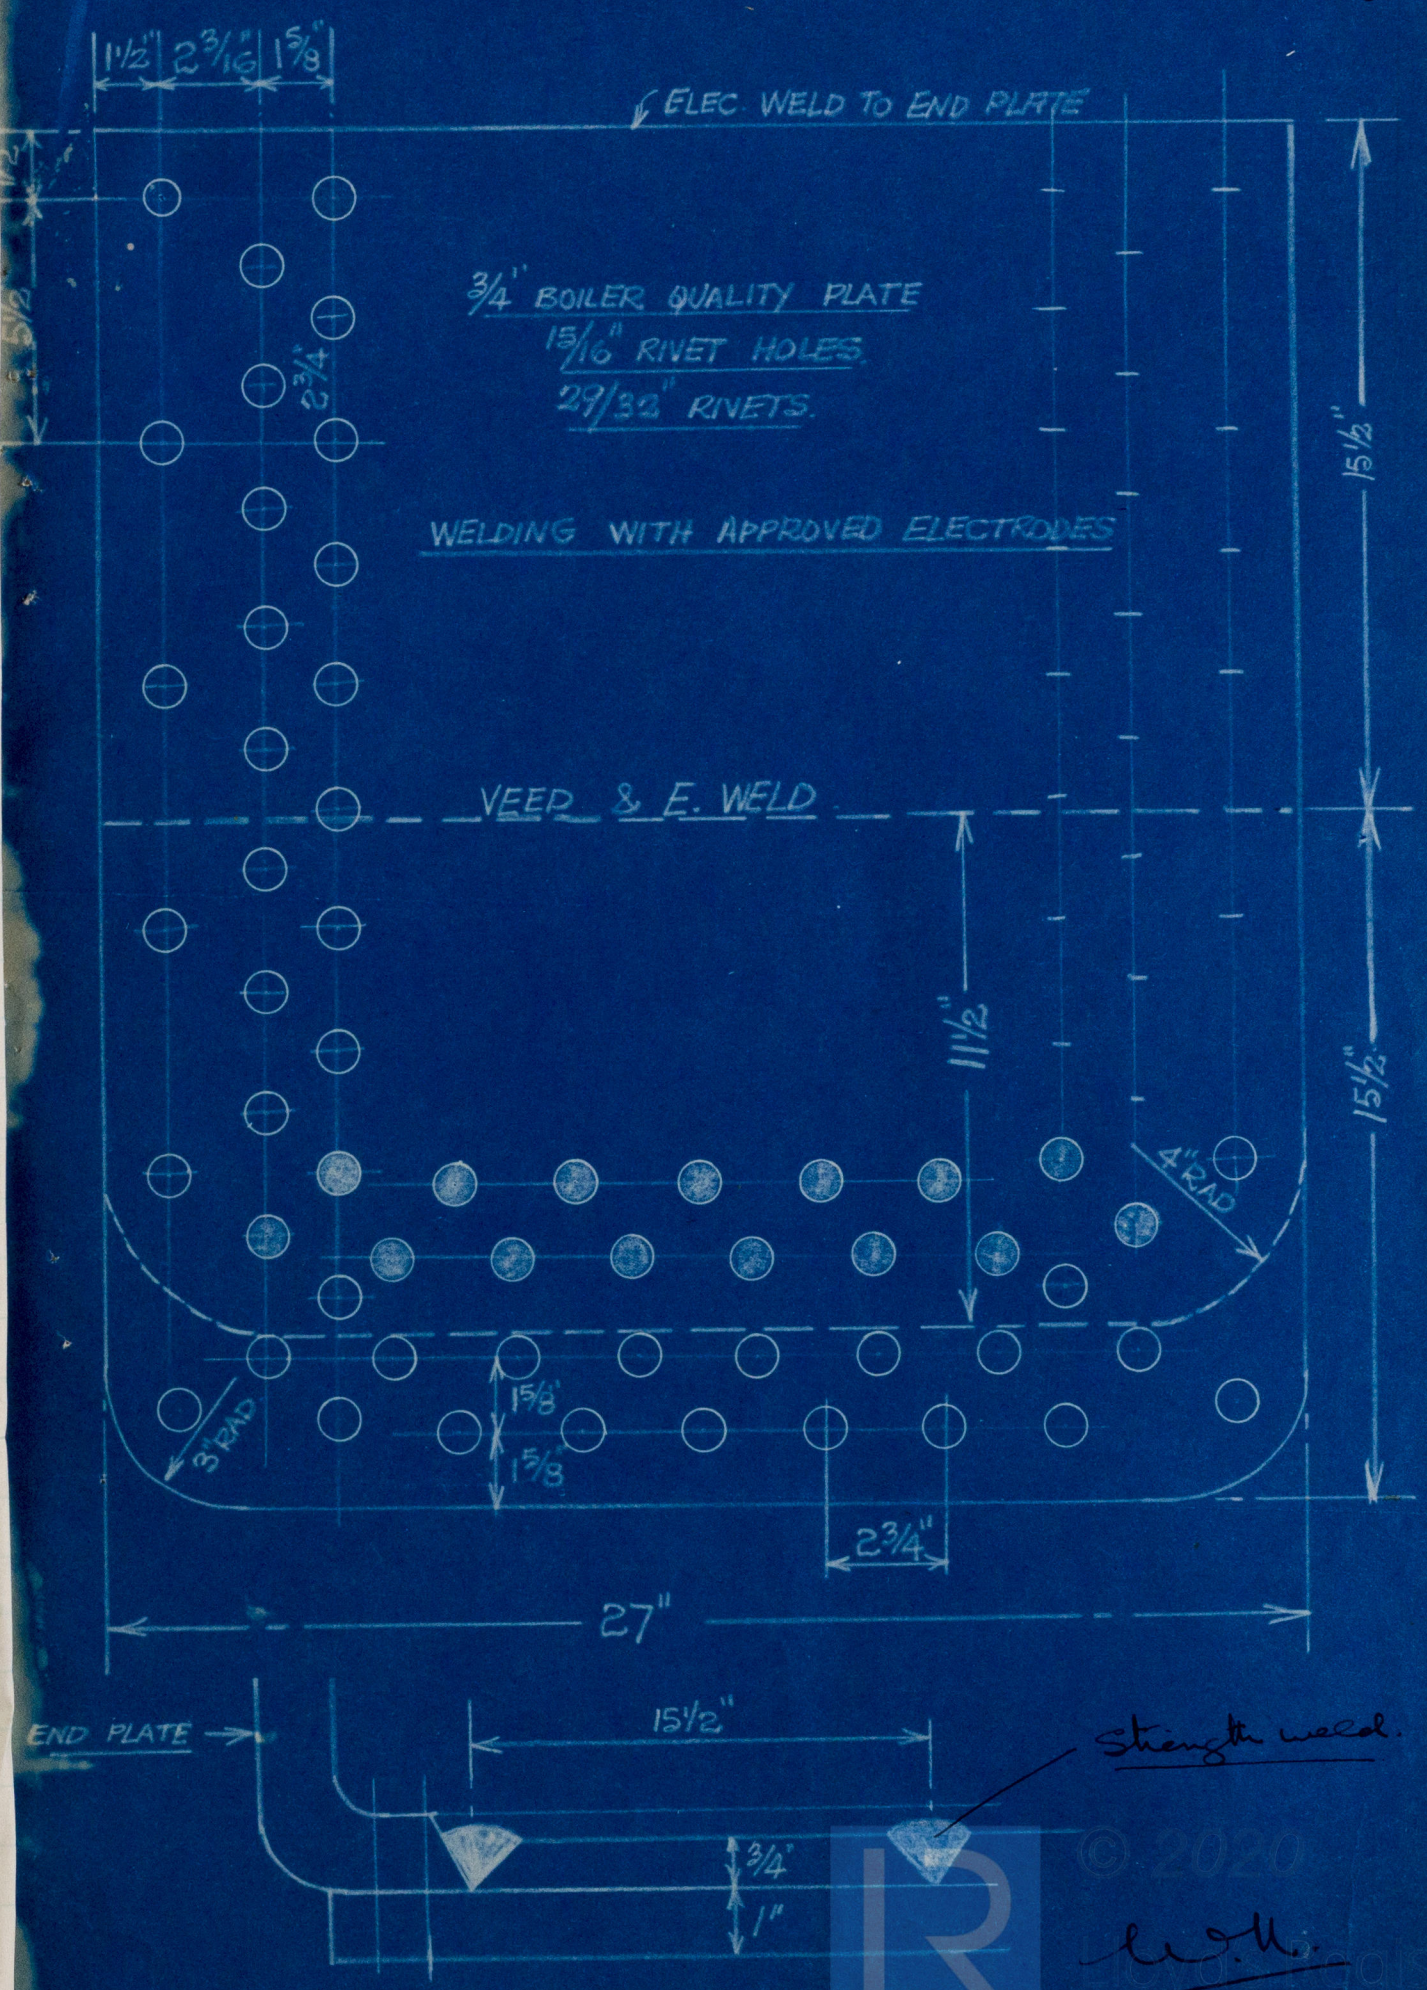

W179-0084

Strength weld.

14/2/41

