

17/7/33



FRAMES 7" x 3 1/2" x 43" SD OR 7" x 3 1/2" x 36" BA	FRAMES TO MAIN DECK 11" x 3 1/2" x 43" B.A.	FRAMES 11" x 3 1/2" x 43" B.A. TO LOWER AND MAIN DECKS WHERE SHOWN	FRAMES TO MAIN DECK 10" x 3 1/2" x 46" B.A.	FRAMES 11" x 3 1/2" x 43" B.A. TO MAIN AND LOWER DECKS WHERE SHOWN	FRAMES 10" x 3 1/2" x 46" B.A. TO UPPER AND LOWER DECKS WHERE SHOWN	FRAMES 11" x 3 1/2" x 43" B.A. TO UPPER & LOWER DECKS WHERE SHOWN	FRAMES 7 1/2" x 3 1/2" x 40" B.A. TO FORE DECK
TWEEN DECK FRAMES 6" x 3 1/2" x 37 1/2" B.A. TO SCARPH 14" BELOW MAIN DECK		FRAMES IN UPPER AND MAIN TWEEN DECKS 7" x 3 1/2" x 33" B.A. TO SCARPH 14" BELOW MAIN AND LOWER DECKS AS REQUIRED	FRAMES IN UPPER TWEEN DECKS 6" x 3 1/2" x 37 1/2" B.A. TO SCARPH 14" BELOW MAIN DECK	FRAMES IN UPPER AND MAIN TWEEN DECKS 7" x 3 1/2" x 33" B.A. TO SCARPH BELOW MAIN AND LOWER DECKS AS REQUIRED	TWEEN DECK FRAMES 6" x 3 1/2" x 37 1/2" B.A. TO FORE & UPPER DECKS AS REQUIRED		

ALTERNATIVE FRAMING NOS 14 TO 26  
 MAIN FR 7" x 3 1/2" x 40" ANGLE TO UPPER DECK  
 REV FR 7" x 3 1/2" x 35" 11 ON ALTERNATE FR. NO. 14  
 TUNNEL TOP AND 2ND DECK FORMING 11" GIRDER  
 SEE SKETCH FOR 2ND ALT.


also below tunnel top at frames 12-15  
 elsewhere between tunnel top 8 x 3 1/2" x 32 BA  
 or 7 x 3 1/2" x 44 BA  
 with rev. 3 1/2" x 28 on every frame

Approved for Framings of frames only.

No 532  
 FRAMING PROFILE  
 SCALE - 1/8" = ONE FOOT  
 DIMENSIONS - 415' x 57' x 37'

W177-0172

17.7.33

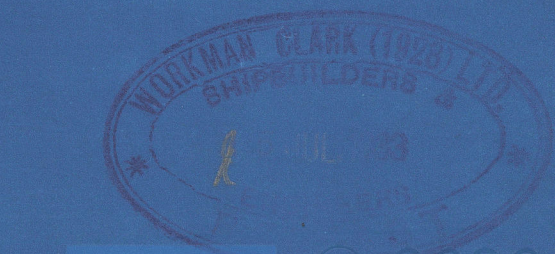



Workman Belarks.

No 532.

Framing Profile

(3)

INCOMATI

Bel. 11296

W179-0172

© 2020



Lloyd's Register  
Foundation