748/50. SINGLE-SCREW MOTOR TANKER.

MIDSHIP-SECTION

SCALE 1:25

LENGTH 470' 0" = 143,25 m
BREADTH 63' 6" = 19,36 m
DEPTH 35' 4" = 10,77 m

CLASS: LLOYDS REGISTER ✠ 100A1 CARRYING PETROLEUM IN BULK (PARTLY WELDED)
L·D = 16605 L·(B+D) = 46450 L/D = 13,3
EQUIPMENT GRADE d +

TRANSVERSE FRAMING

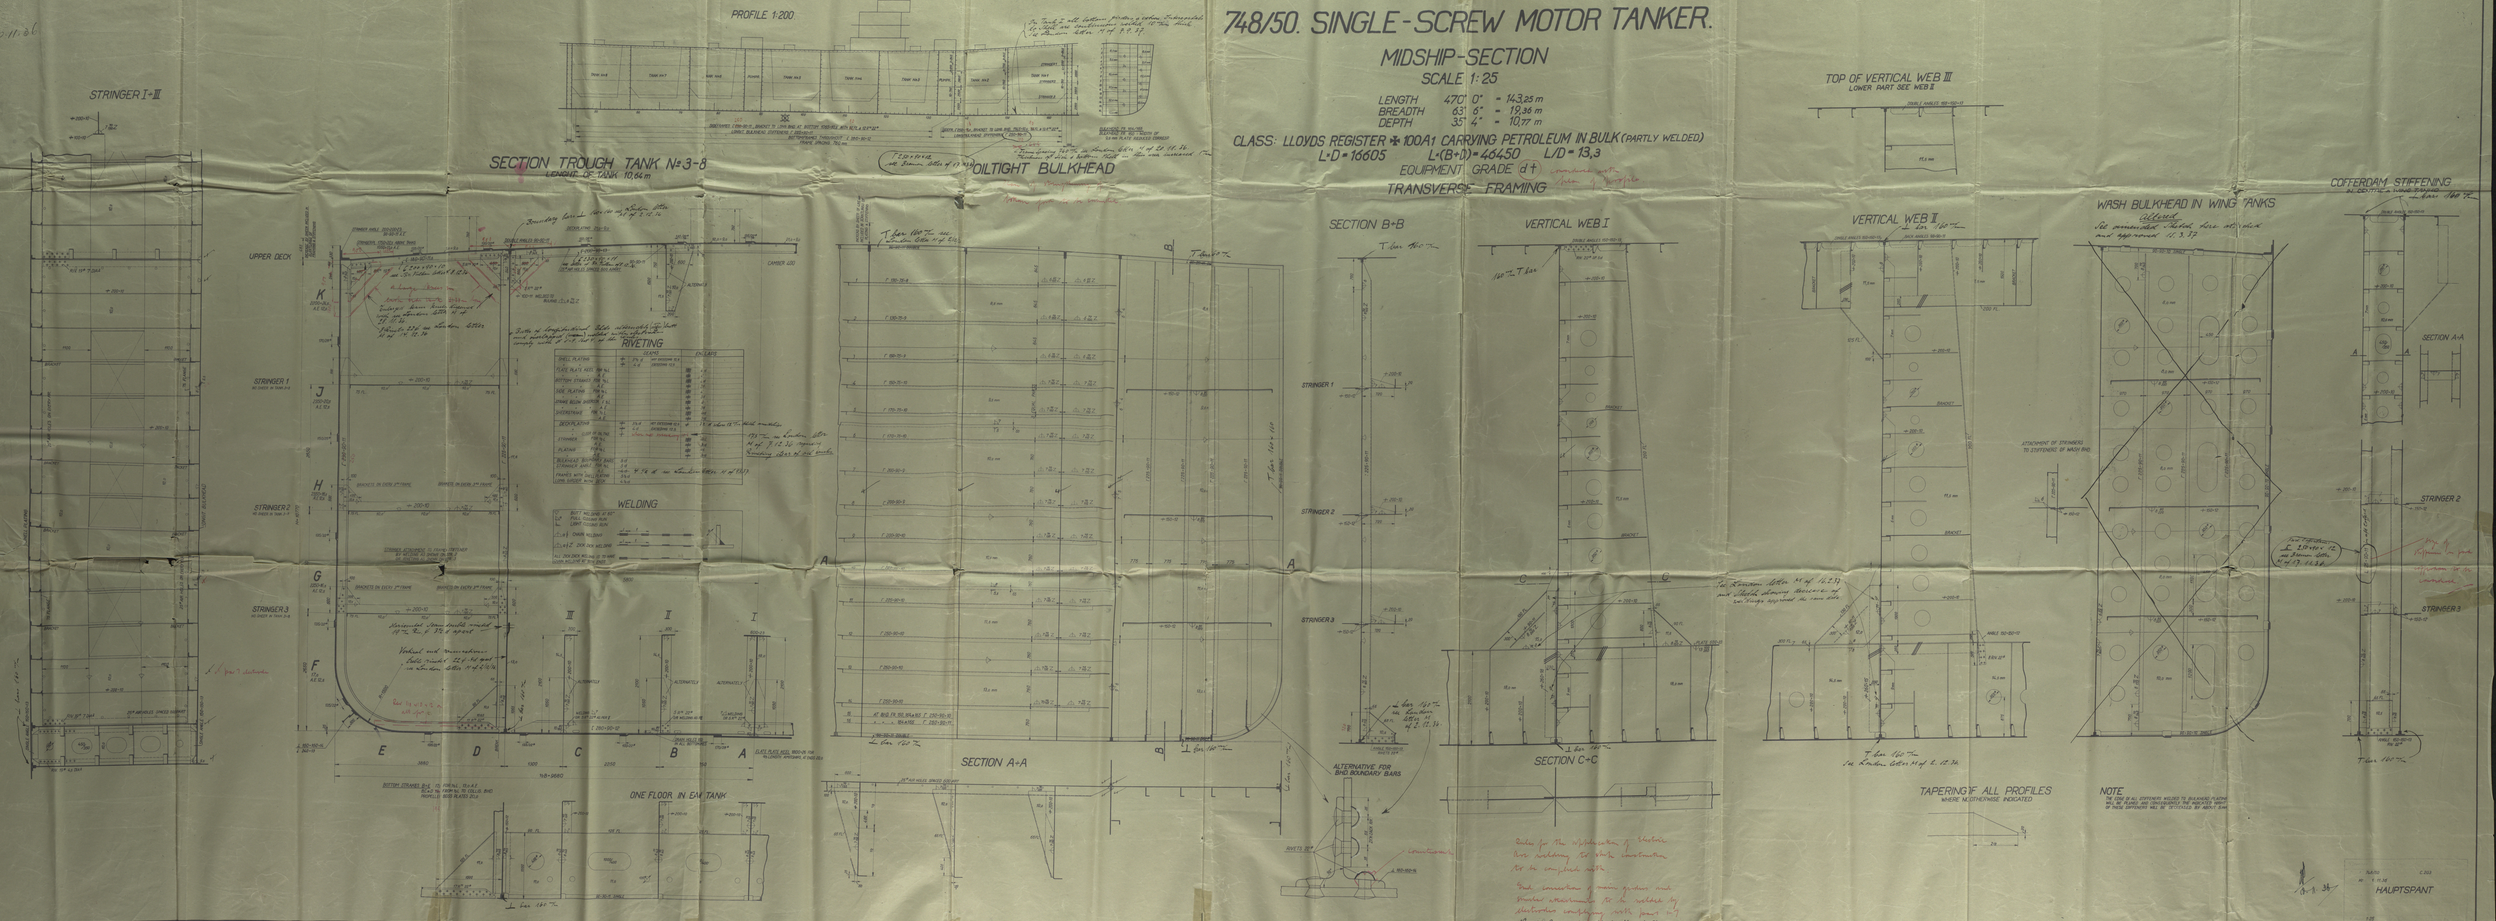

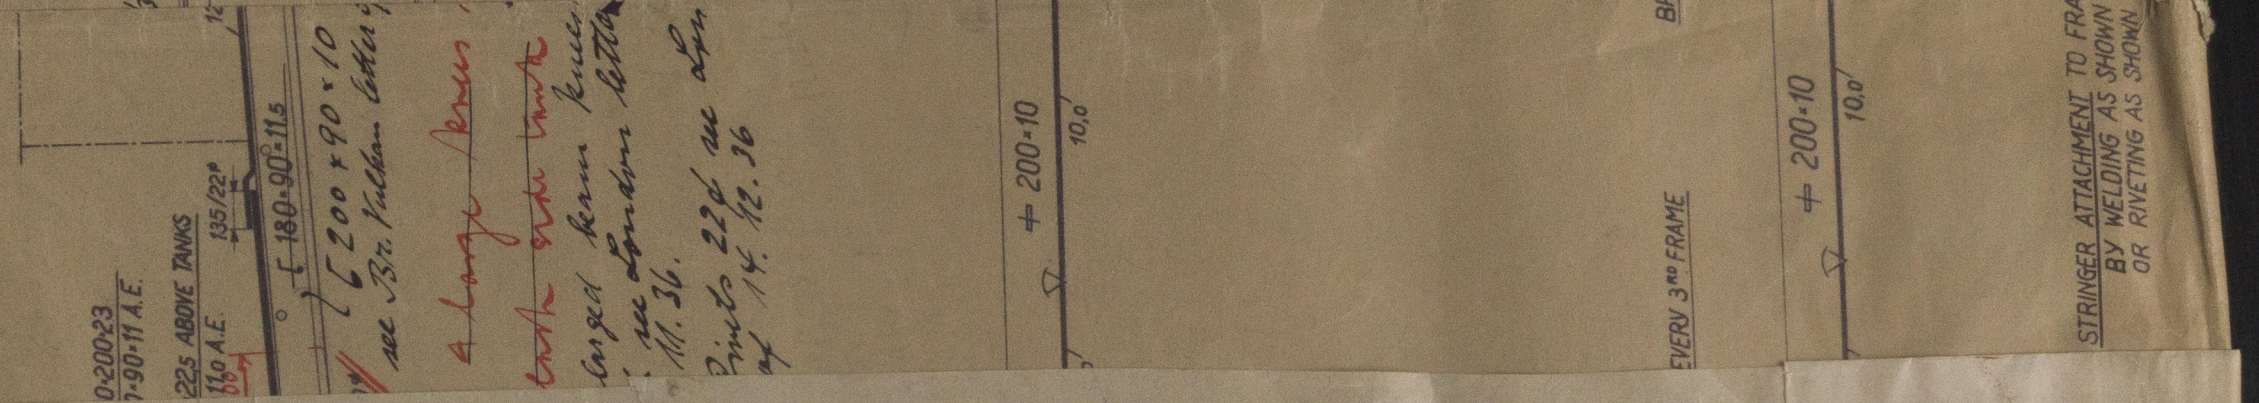

Messrs. Bremer Vulkan, Vegesack

Yard No. 748/9/50.

Plan of Midship Section.

Bremen letter M.3.11.36.

Inverta Bmn. 2003.

Inverstannen

Inverlane

W180- 0145

© 2019
Lloyd's Register
Foundation