
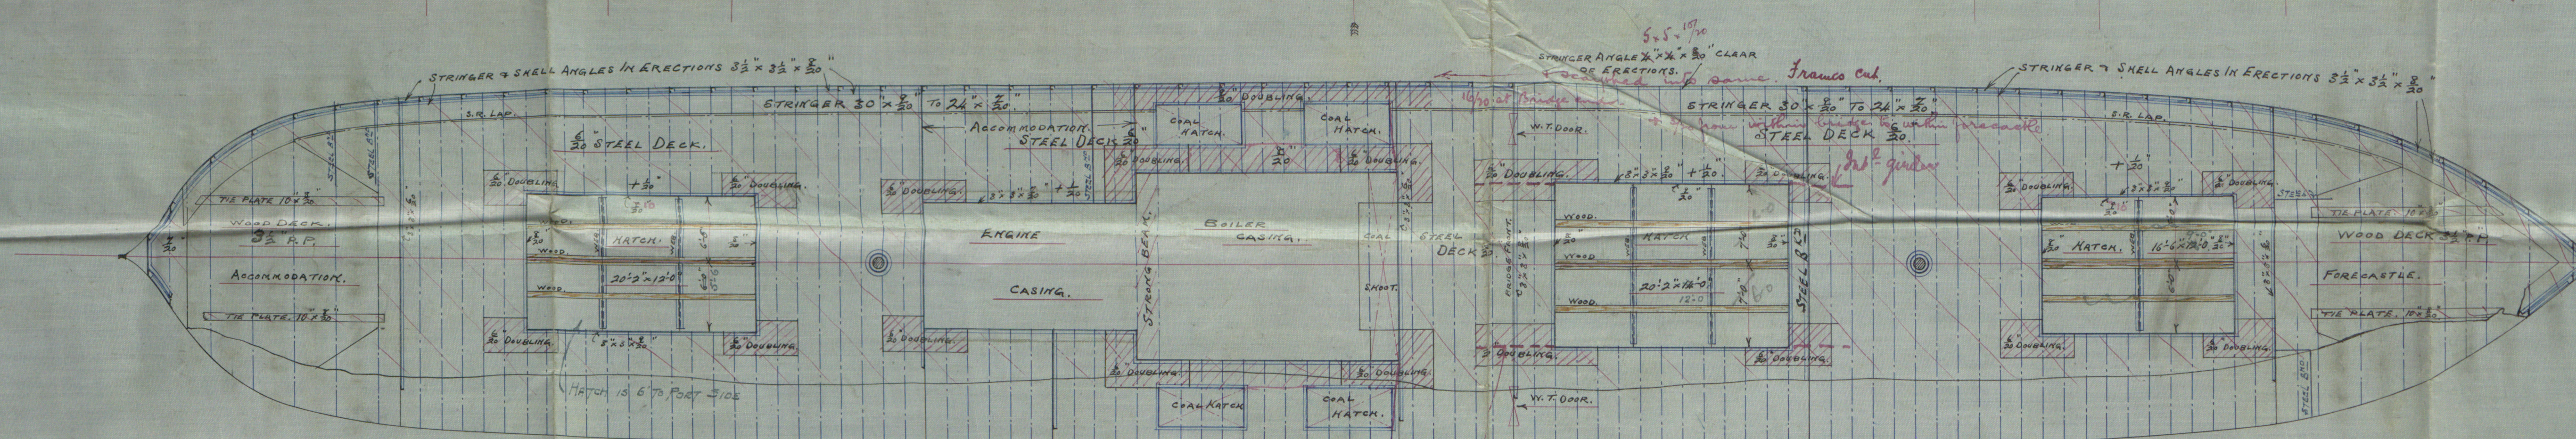






SECTION TWO KATCHES.

DEEP BRACKET IN LIEU OF FILLARS AT SIDES
OF 12" x 12" KATCHES.

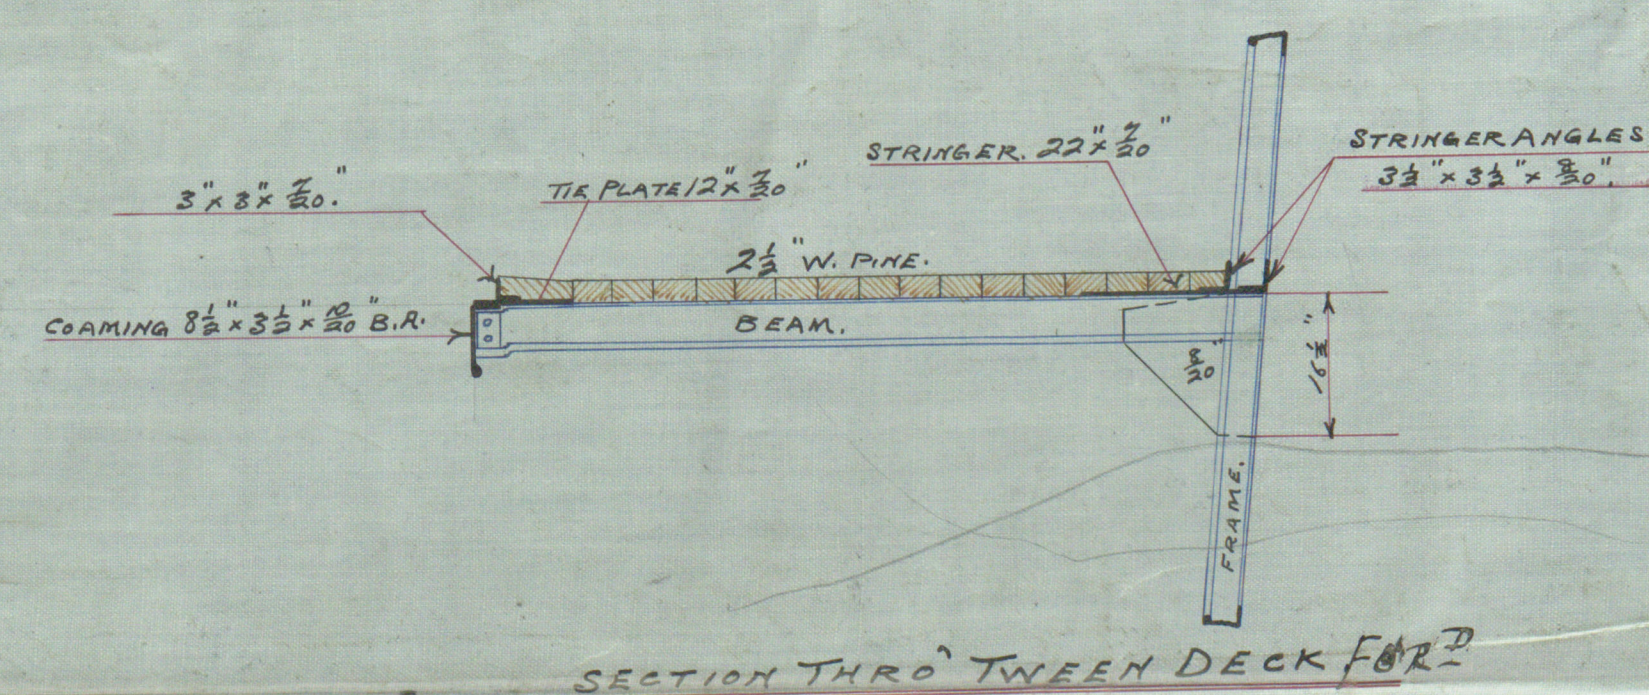

LLOYDS PROFILE.
S.S. NOS 216 & 217.
SCALE $\frac{1}{8}$ " = 1 FOOT.

LLOYDS DIM. 213.83' x 31.33' x 15.32
TO CLASS 100 A.1.

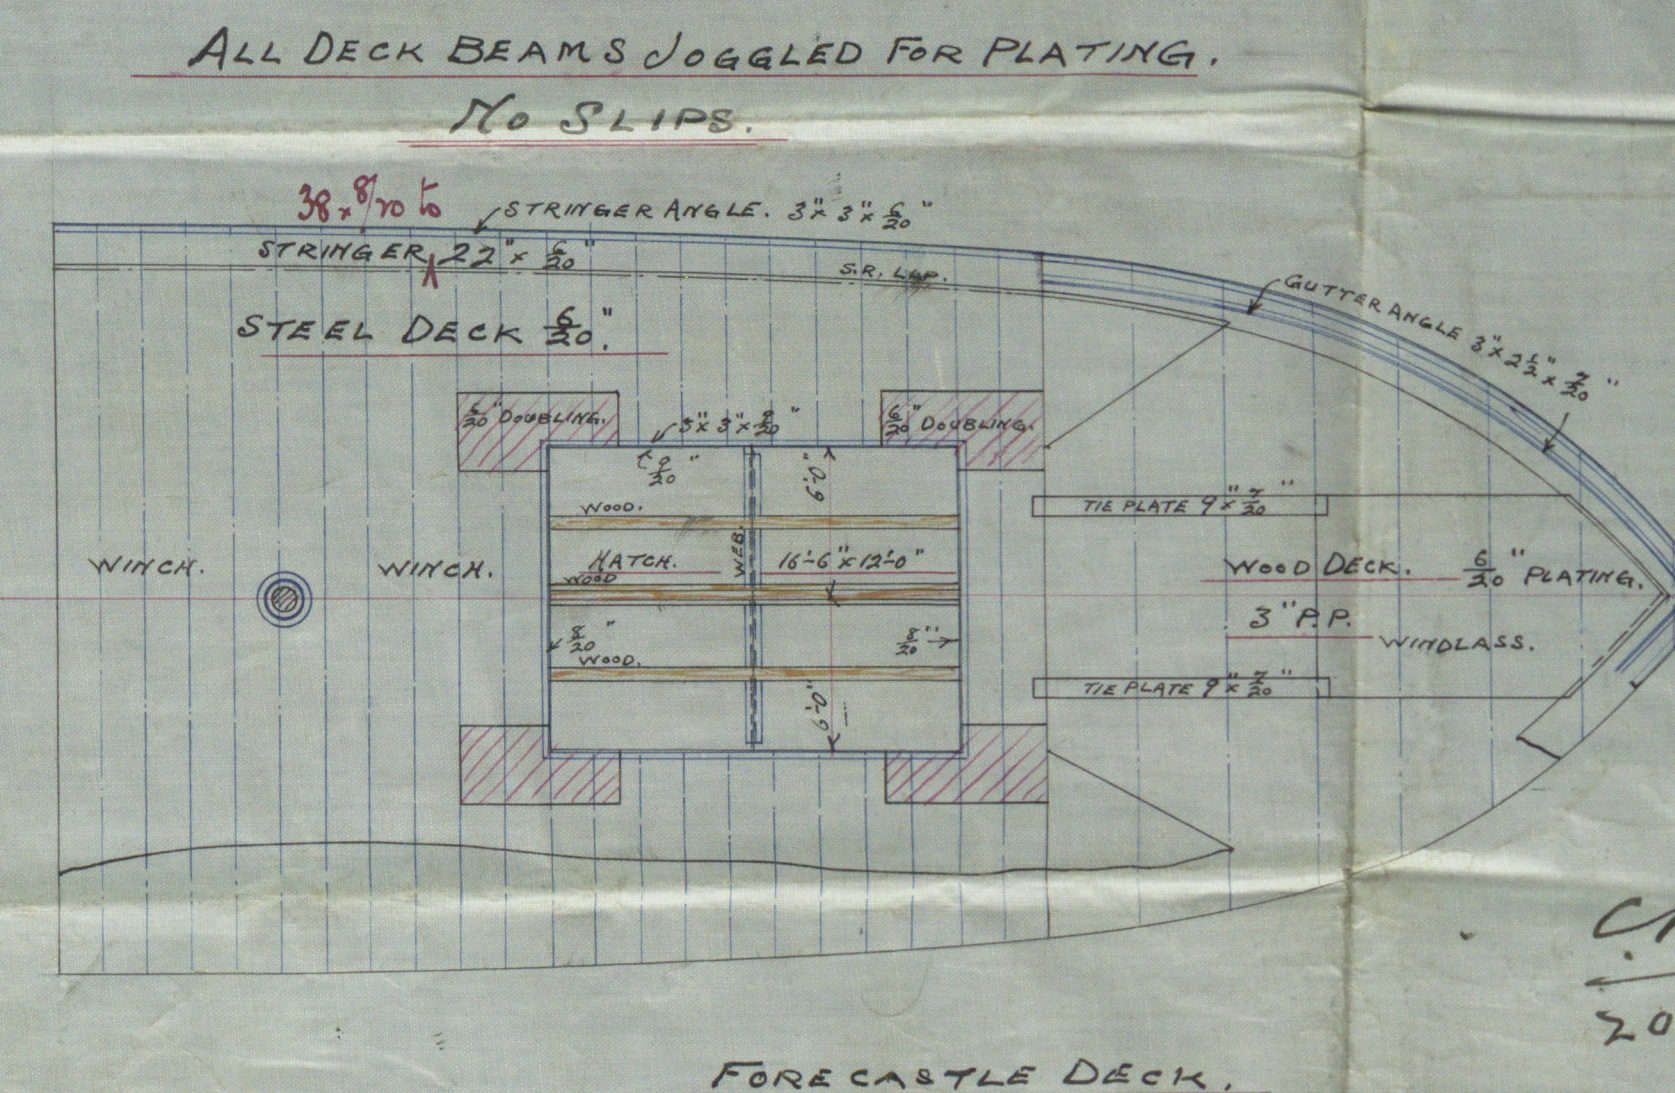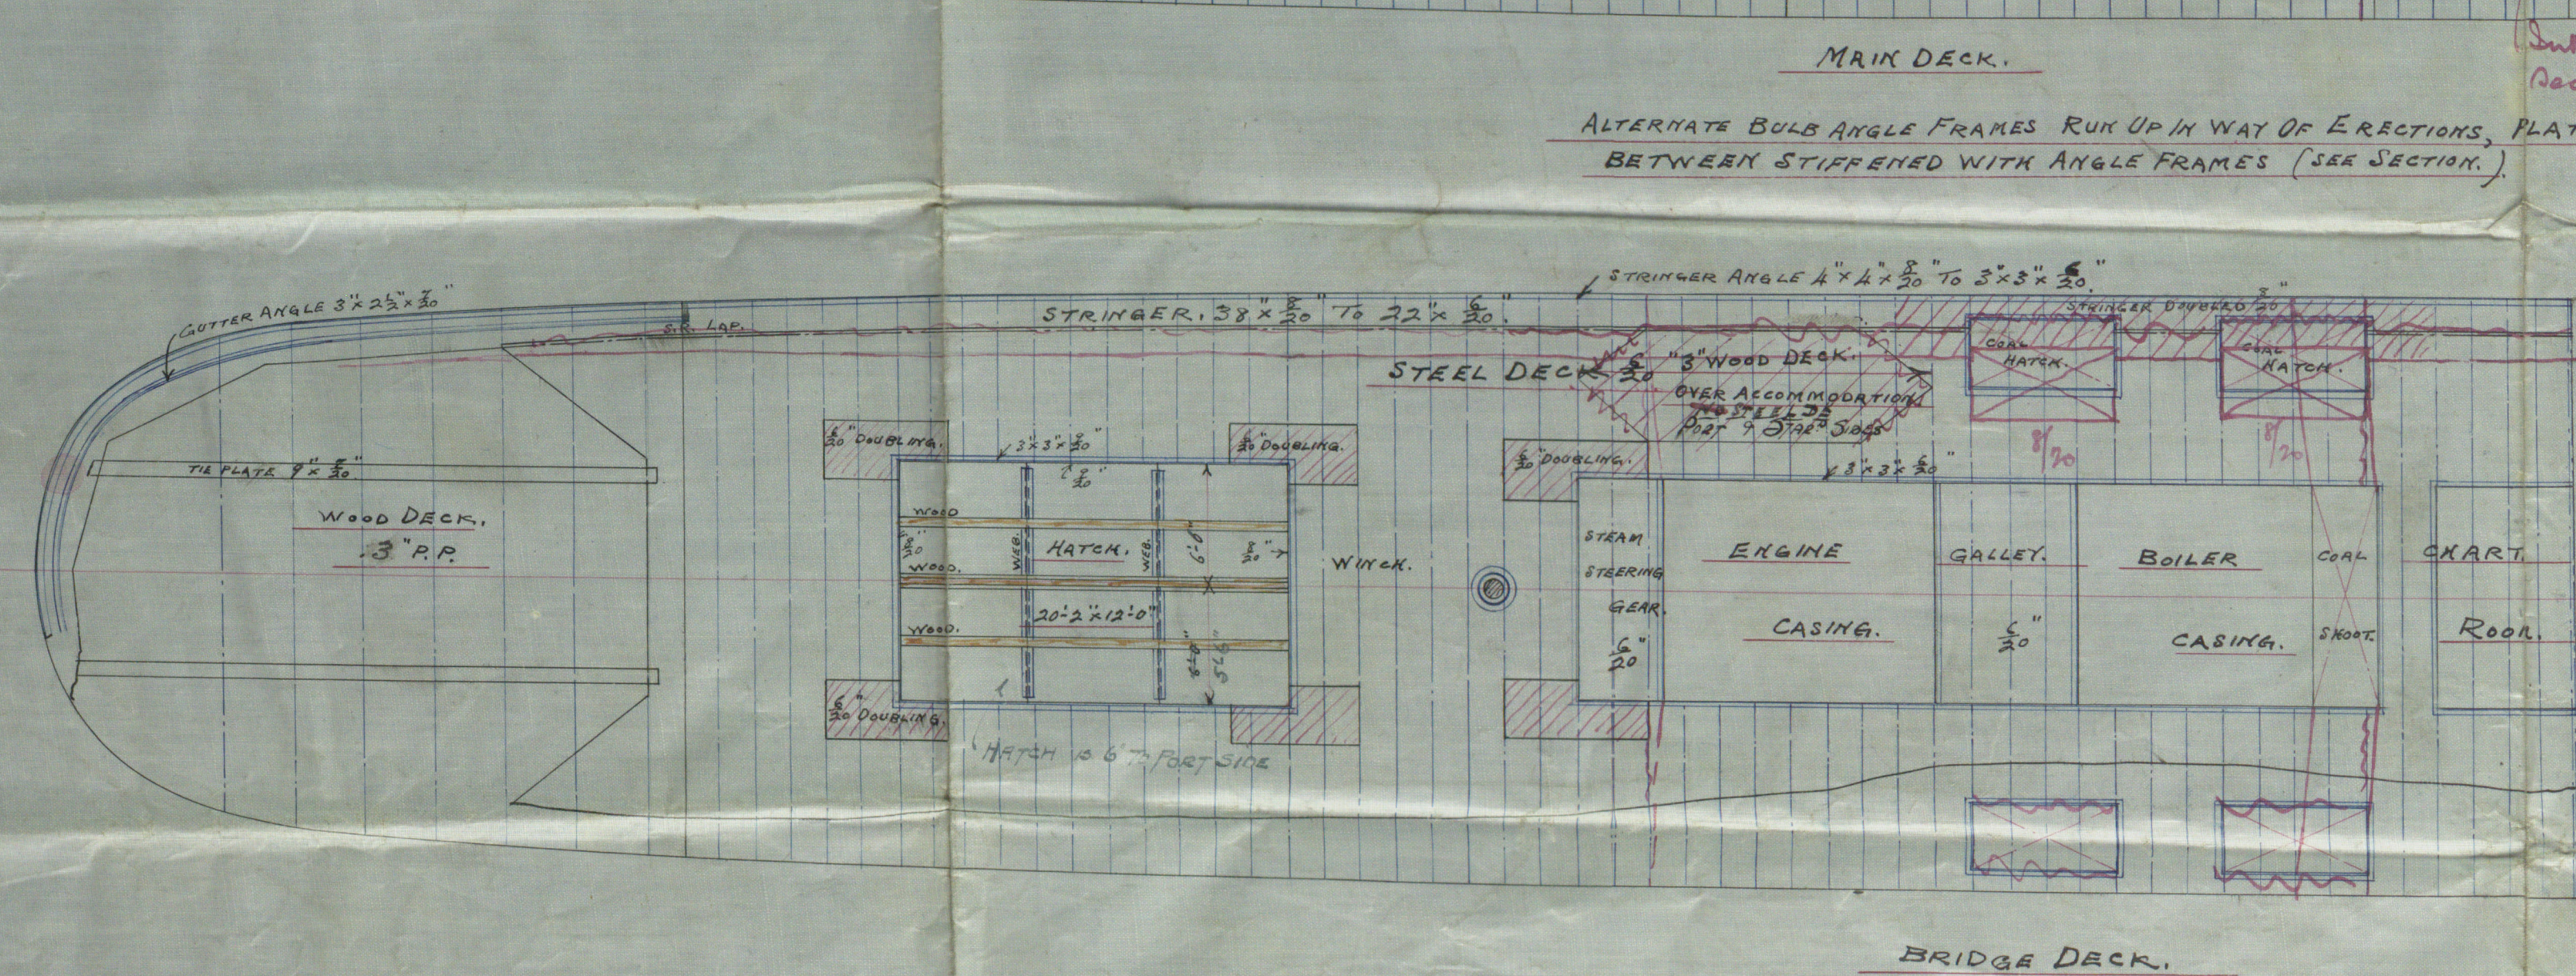

C.B.
20.7.08.

S. S. 8° 2/6 + 214

Amundid.

Propiti Plan

Messrs Ramage &

Ferguson
Leith

Inaki

Lth. 12574.



© 2019

Lloyd's Register
Foundation