


# Zweischrauben-Motorschiff Nr. 82 u. 83.

Klasse: Lloyd's Register + 100A, with Freeboard.  
entspr. 29'3" Tiefgang bei geschlossenen Verm.-Öffng.

Seiten: S. 82/83 Zeich. S.E. 3

*Philips*

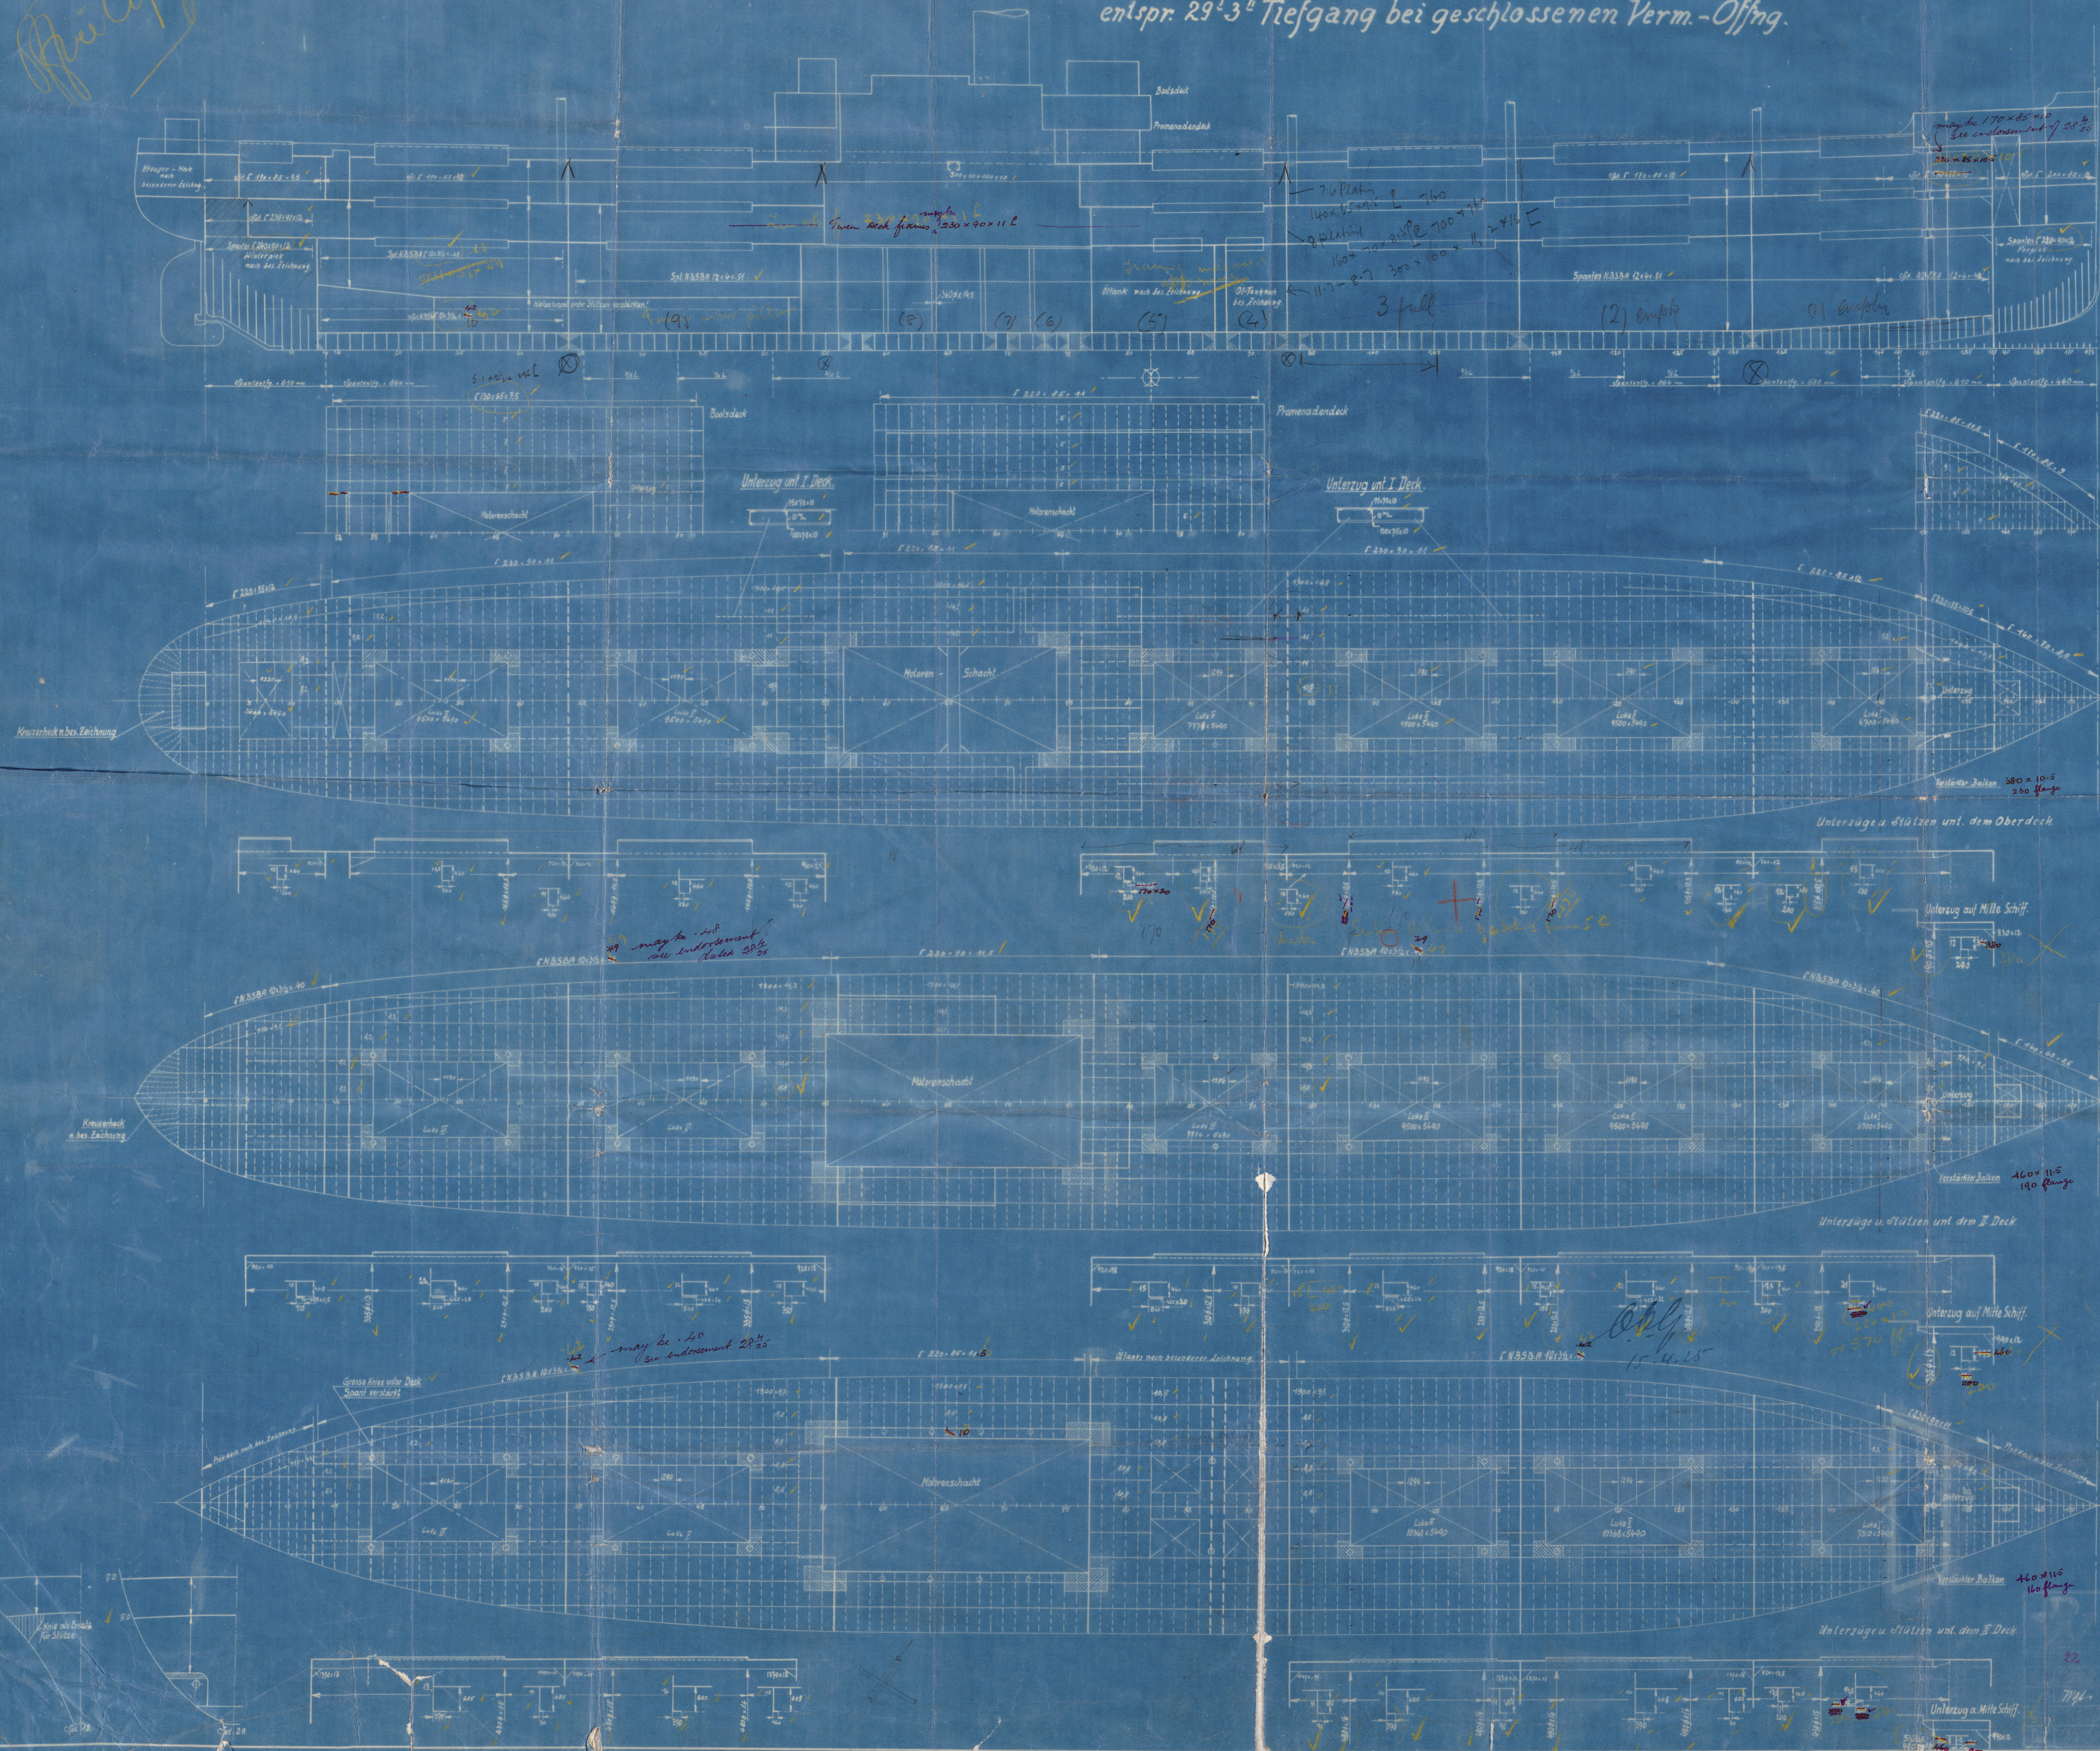

Abmessungen.

Länge zw. d. Steven 440' 0"  
Länge über Steven [Lloyd's Length] 441' 392"  
Breite auf Ganzen 60' 0"  
Stützenhöhe bis Oberdeck 42' 3"  
" " F. Deck 32' 3"

L x D = 14666  
L x (B + D) = 45173  
L : D = 10,455

Sprung.

10' 36" 1036 mm  
1/4 L von vorne 1000 mm  
1/4 L " 477 mm  
1/4 L " 129 mm  
1/4 L hinten 64 mm  
1/4 L " 238 mm  
1/4 L " 510 mm  
Hintersteilen 910 mm

d bei 22' 6" Tiefg. = 0,22

*Stützungen d. Masten sind  
für den Fall der Not  
ausgerüstet*

Backdeck.

Oberdeck.

II Deck.

III Deck.































































































Profile and decks  
Deutsche Werft's No. 82/83 & 93/95  
Hamburg letter 6. 4. 1925.

Japanese Prince Ham 16680.

~~Gen Box 502~~

2 empty  
1, 3, 4, 5 full  
9 full  
10 empty  
7 full empty

W182-0195



© 2019

Lloyd's Register  
Foundation