

CLASS DET NORSKE VERITAS I.A.I
OR NEW ZEALAND STANDARDS 1124
LOYD'S REGISTER 100A1 WITH FREEBOARD
FOR A DRAUGHT CORRESPONDING TO A COMPLETE
SUPERSTRUCTURE VESSEL HAVING A TONNAGE OPENING

[illegible]


(Alk. within blue)

Longitudinal section & plans.

N^o 466

AB. Gotaverken,
Söthenburg.

M^r. Kaaparen Got-9337.

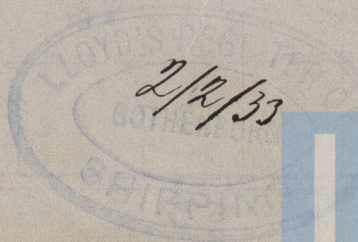

© 2020

Lloyd's Register
Foundation