



LENGTH B.P. 195' BREADTH MLD 32' DEPTH MLD 13'-9'

SCALE  $\frac{1}{8}$  = 1 FOOT.

Nº 152. SHIP.

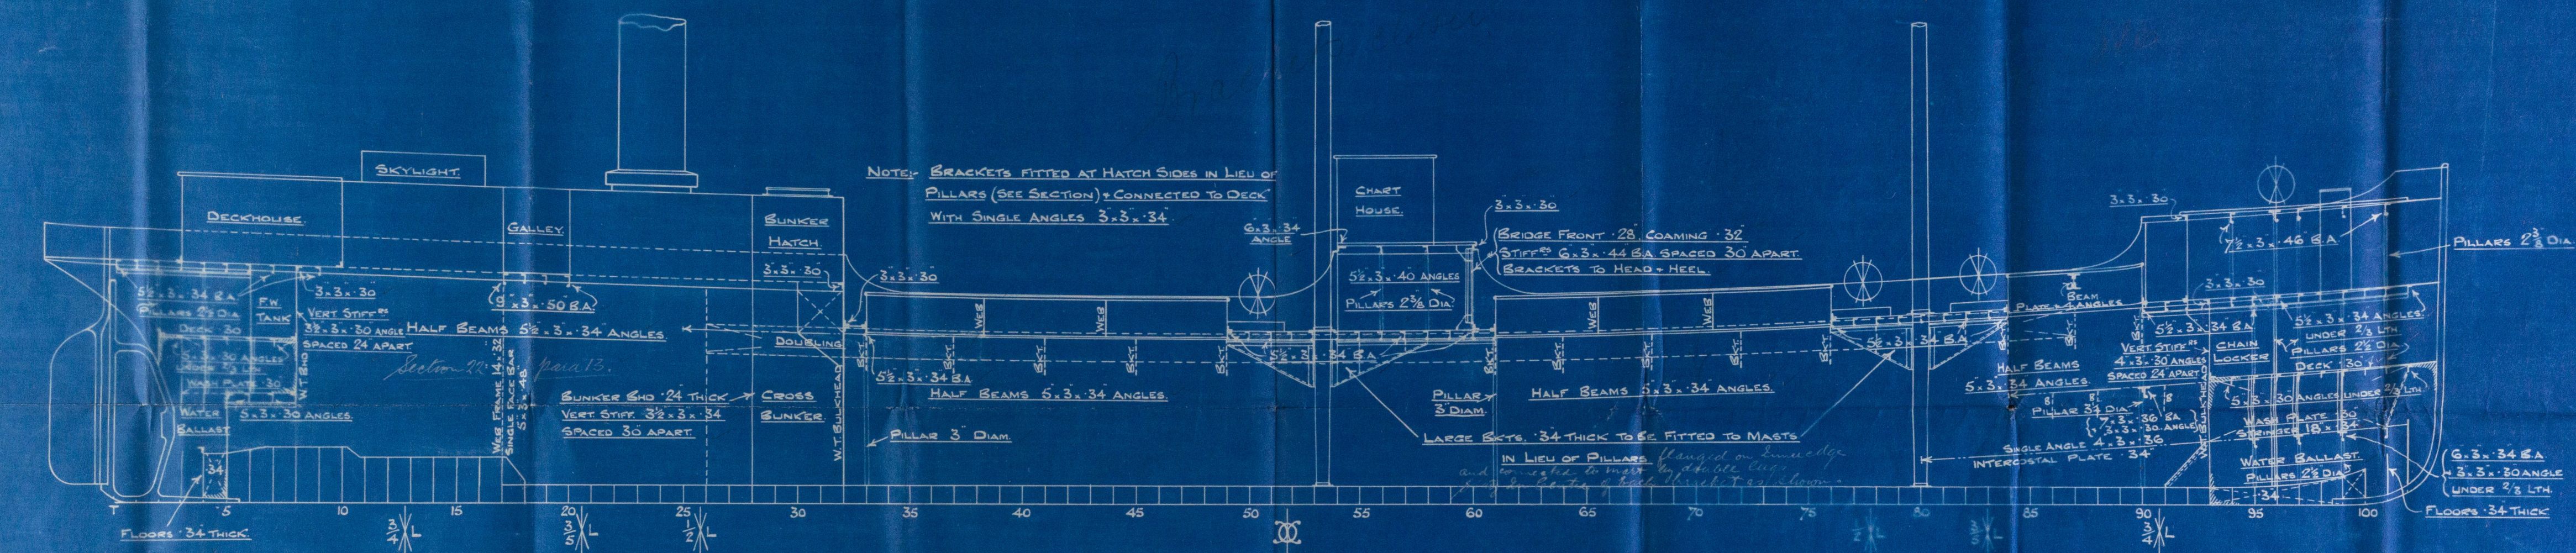

ADDITIONAL INTERCOSTALS + DOUBLE FRAMES, TO BE FITTED  
FROM NO 78 TO 97 INCLUSIVE. SHELL PLATING THICKENED + CLOSE  
RIVETED AS PER RULE. (SEE SECTION 17.)

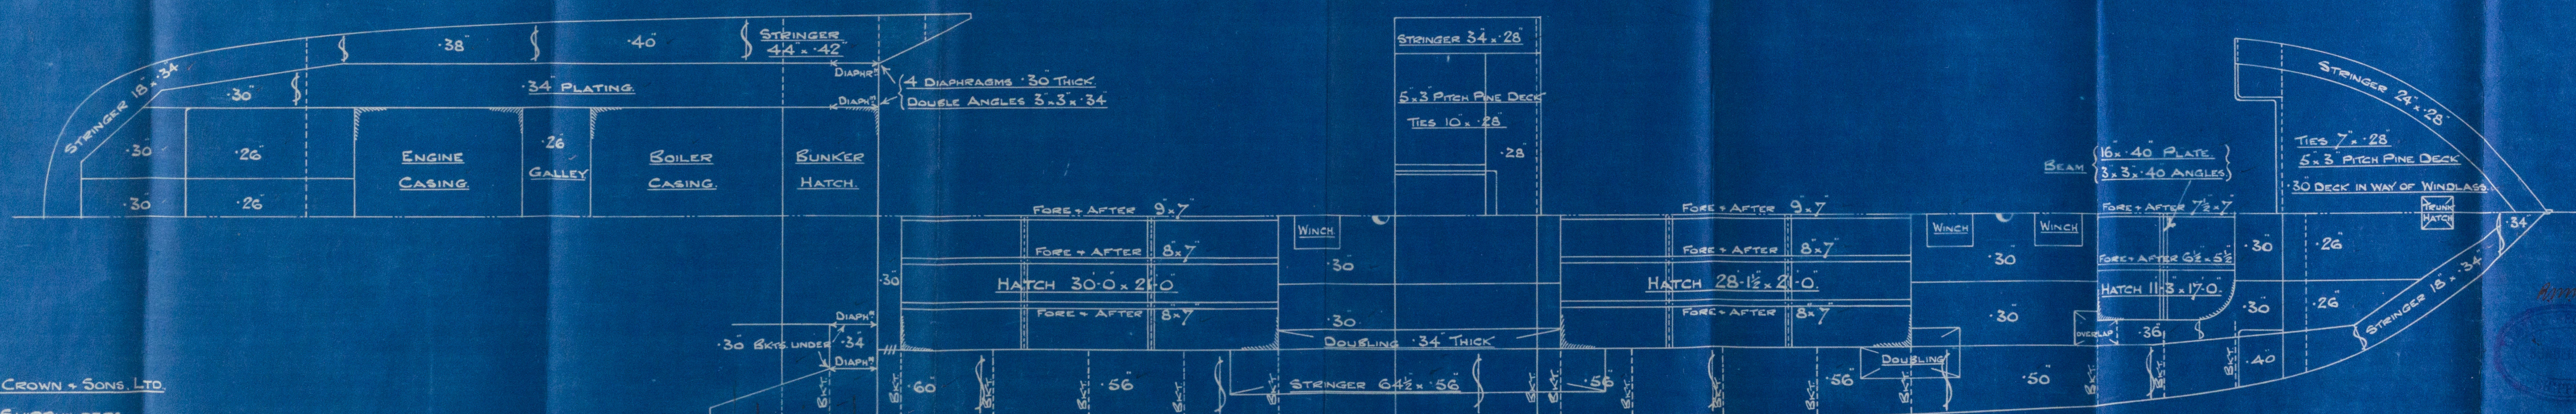


JULY 15<sup>TH</sup> 1913.



Profile & Deck Plan

No. 152


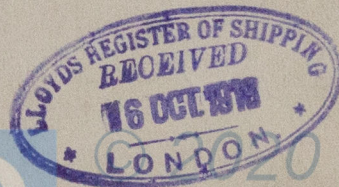

S.S. Kapara

Sld No 26006

W183-0219