


NO. 386.
CONSTRUCTION PROFILE & DECK PLANS.
SCALE 1/8" TO 1' (SHEET NO. 1)

 

APPROVED
LLOYD'S REGISTER
DEC 14 1901
KOBÉ


3


Ship's Name or No. 386.	
Name	REVISED PLAN OF CONSTRUCTION
of	
Drawing	PROFILE AND DECK PLANS.
Drawing No.	Sending No.

GEN. BOX NO 344

M.V. "KANO MARU"
YKA. 5343.

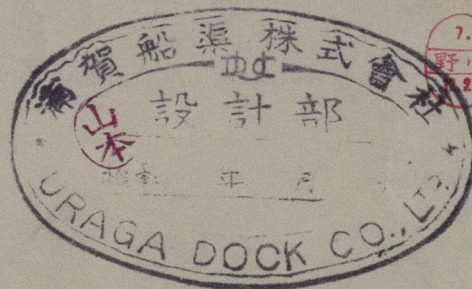

御承用

W184 - 0145



© 2019

Lloyd's Register
Foundation