


W184-0168

MAIN BEARINGS FINAL READINGS. N°5 CRANK DOWN.

N°8.	N°7.	N°6.	N°5.	N°4.	N°3.	N°2.	N°1.	COMP.
.016"	.022"	.020"	.025"	.024"	.040"	.038"	.033"	.030"

DOWN FROM LLOYDS GAUGE.

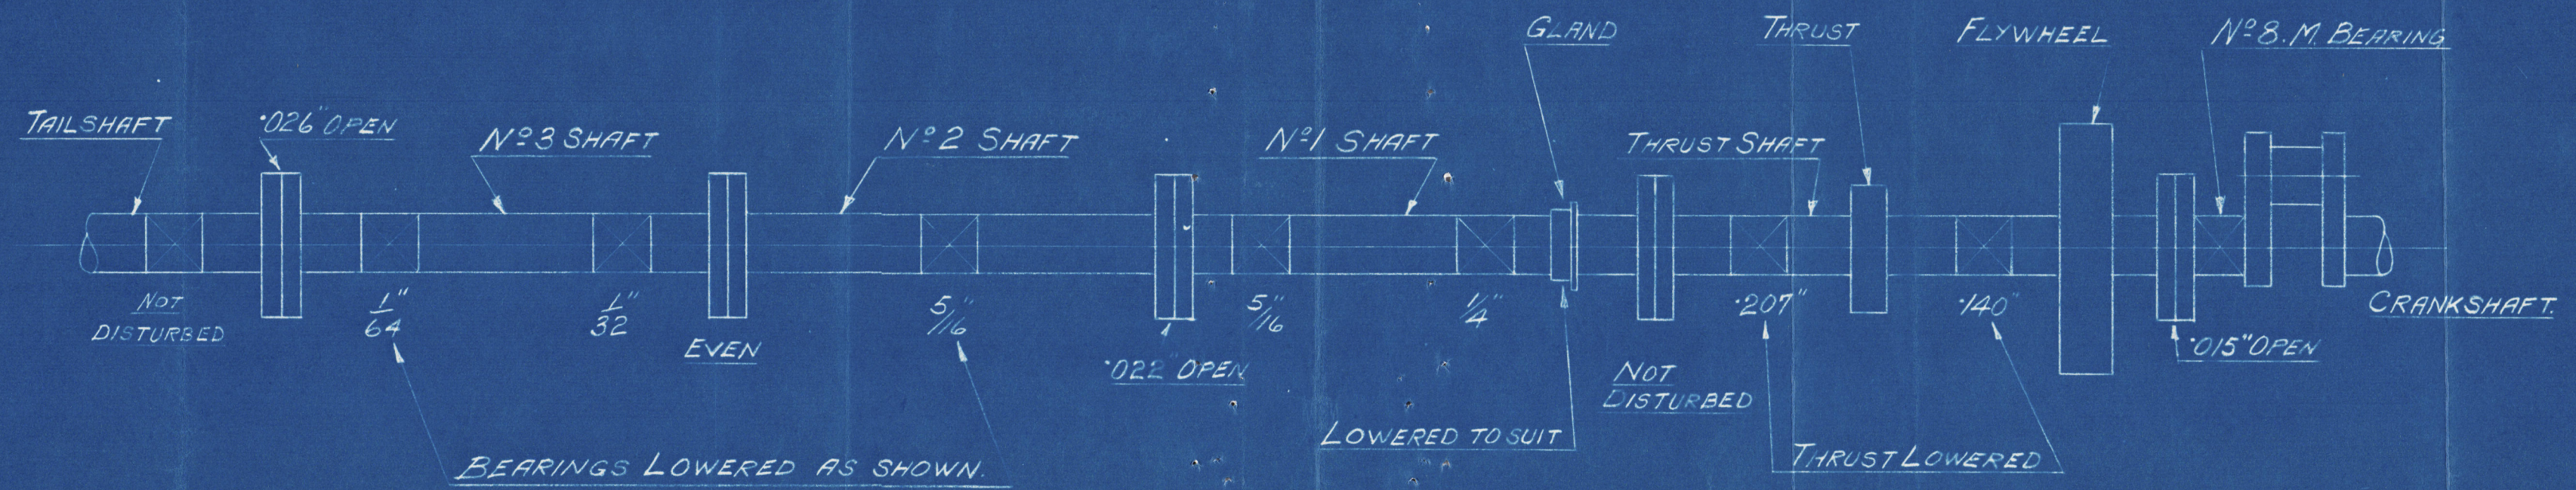


M. S. KING MALCOLM.  
CRANK & TUNNEL SHAFT READINGS  
YARROWS LTD ESQUIMALT. B. C.

7<sup>TH</sup> JULY 1934. DRG. N°1804.



J. D. King Malcolm,  
Ver. Ref. No. 3794

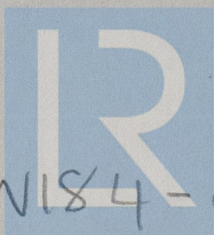

© 2019

Lloyd's Register  
Foundation

W184-0165