


— M.V. KING MALCOLM —

JULY 1934

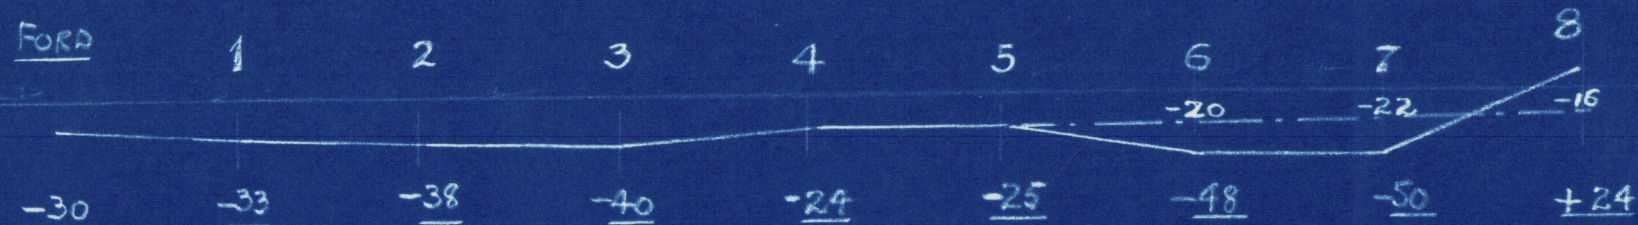

— ALIGNMENT OF CRANK SHAFT —

— LINE IN FULL SHOWS SHAFT ON ARRIVAL —

— DOTTED LINE SHOWS SHAFT AS IMPROVED —

FIGURES IN THOUSANDTHS



© 2019

Lloyd's Register
Foundation

W184-0166

Dr. King, Malcolm
Ver. Sept. No. 37 ne.

W184-0166



© 2019

Lloyd's Register
Foundation