


— FINAL MAIN BEARING READINGS WITH NO. 5 CRANK DOWN —

No.	8	7	6	5	4	3	2	1	COMPRESSOR
LOW TO LLOYD'S GAUGE	16	22	20	25	24	40	38	33	30

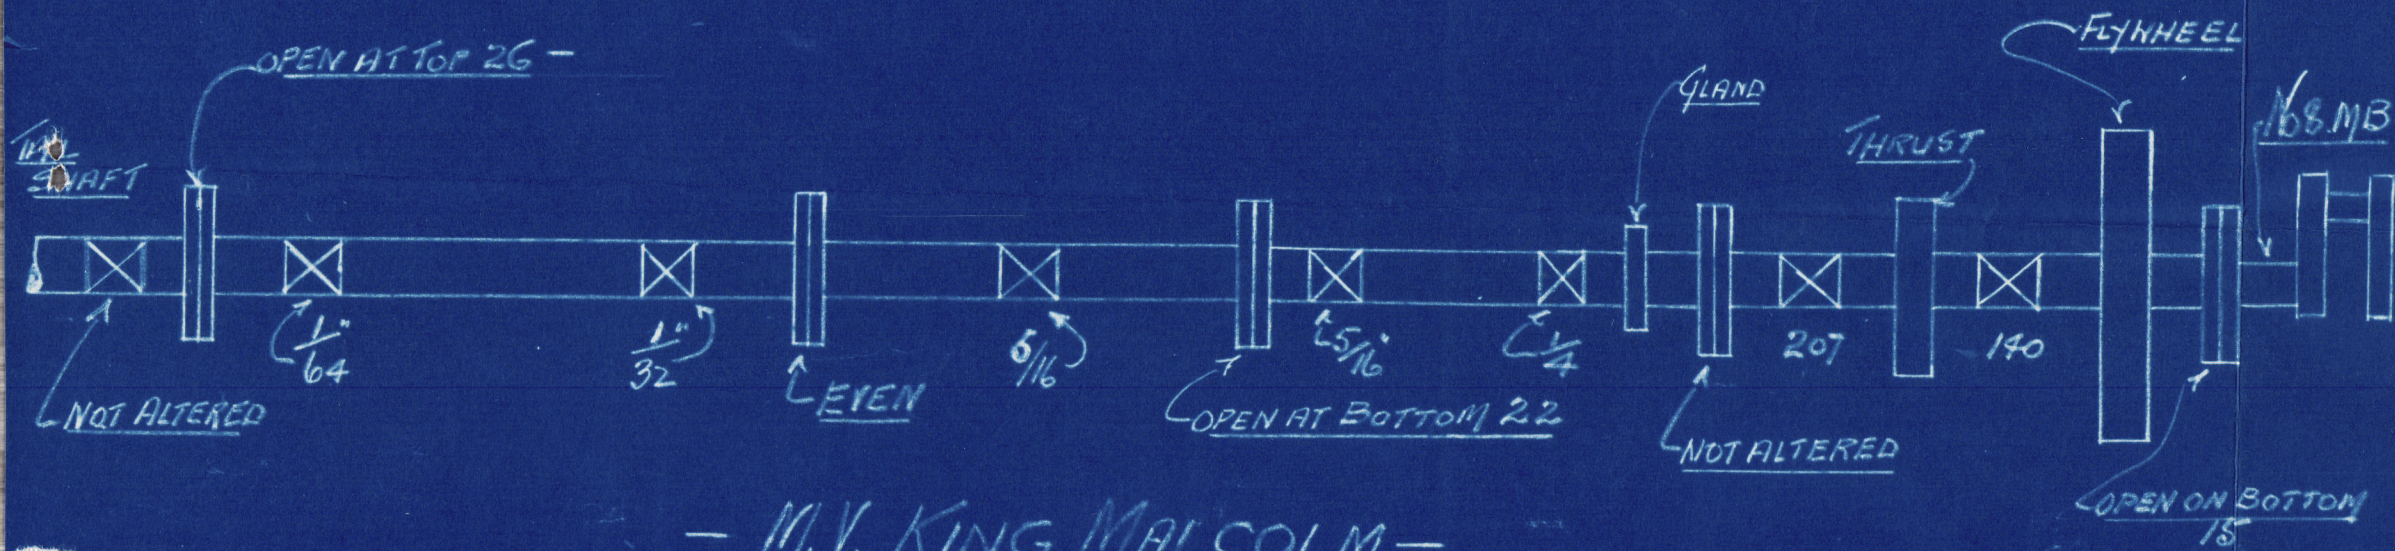

— M. V. KING MALCOLM —

July 1934




© 2019

Lloyd's Register  
Foundation



J. D. King Malcolm's

(Ver. rept. No. 3724)

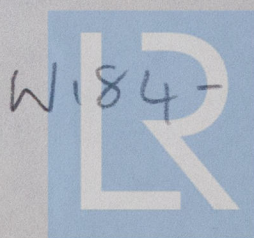

© 2019

0167

Lloyd's Register  
Foundation