



7.8.14
28.8.14
18.9.14
20.10.14
29.10.14

PROFILE No 253^s/_s.

SCALE 1/8" = ONE FOOT.

JOHN PRIESTMAN & CO
SHIPBUILDERS,
SUNDERLAND
30.7.14




DIMENSIONS
LENGTH B.P. 270'-0"
MOULDED 39'-0"
BREADTH EXTREME 40'-0"
DEPTH MLD 20'-0"

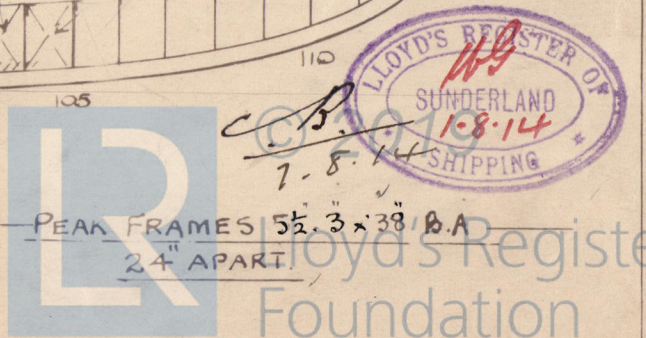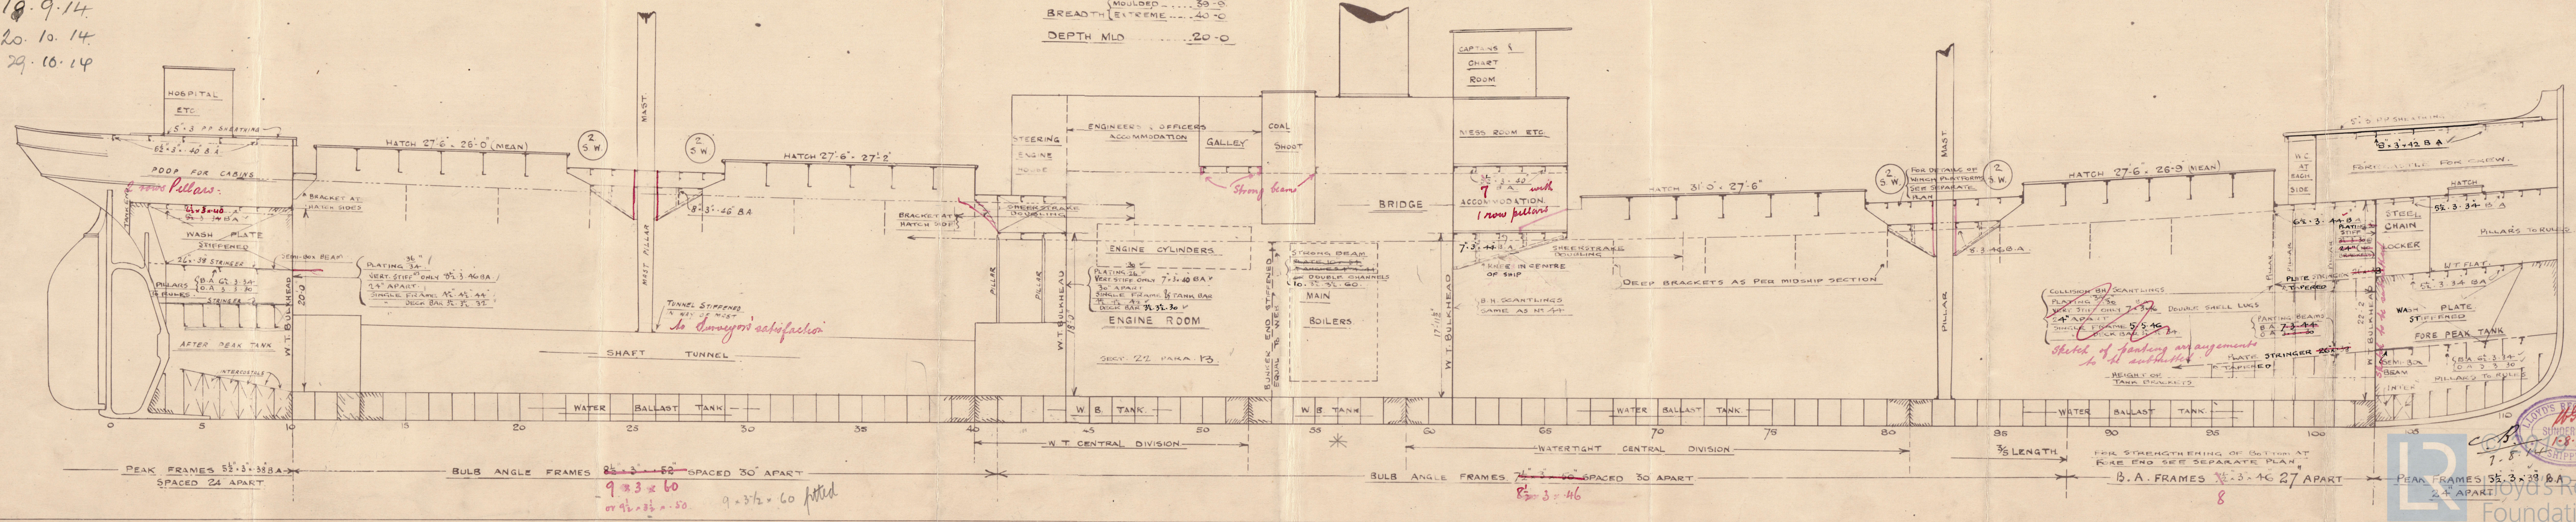

W184-0197

S.S. KOWARRA
PRIESTMAN'S No 253

PROFILE. SLD RPN.
26601

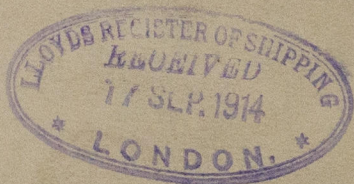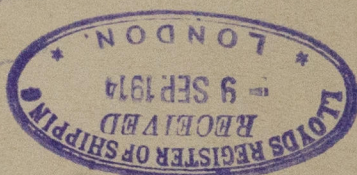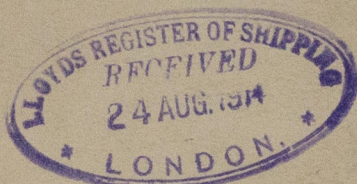

© 2019

Lloyd's Register
Foundation

W184-0197