



DECK PLANS No. 253 S/S.

SCALE 1/8" = ONE FOOT


POOP DECK.

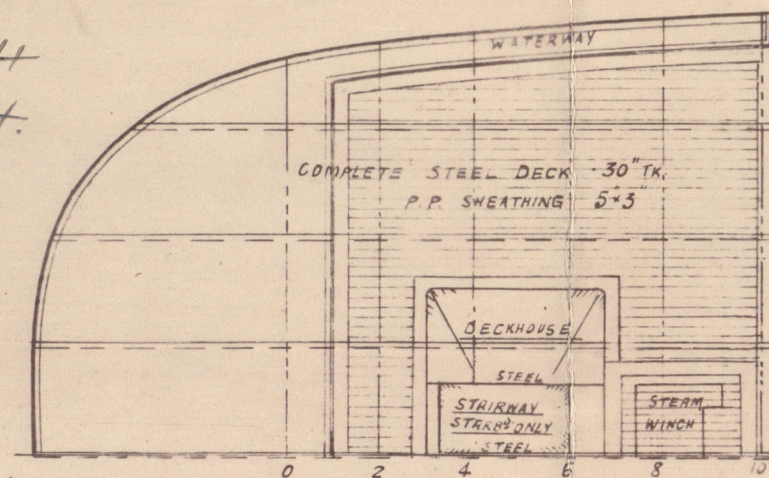

BRIDGE DECK.

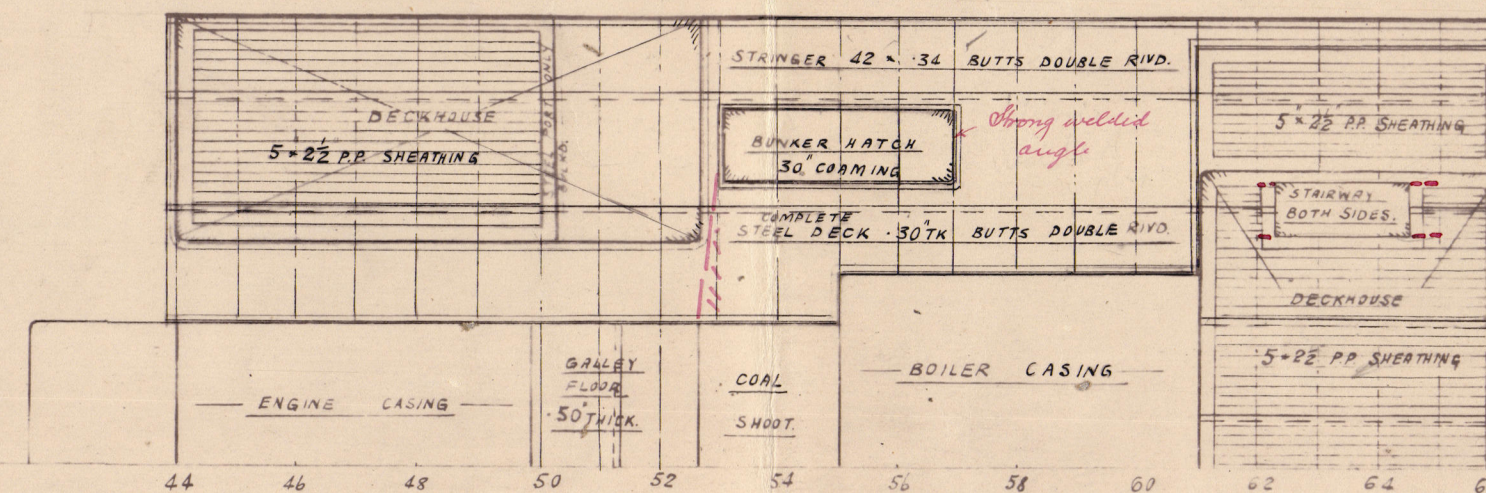


FORECASTLE DECK.

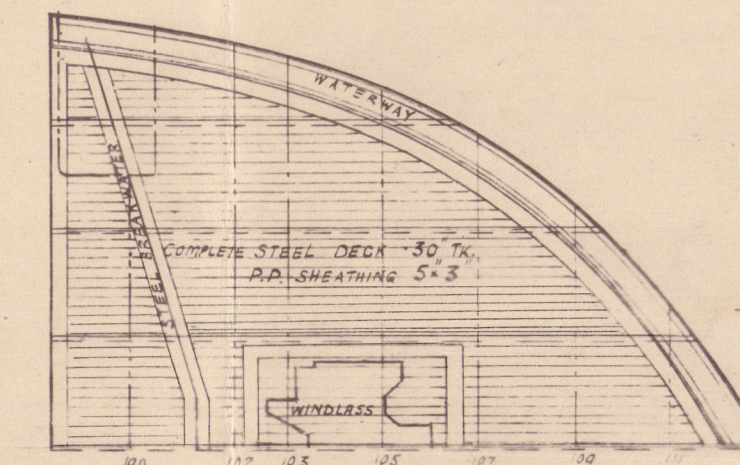

CABIN SOLE

RAISED QUARTER DECK.

MAIN DECK

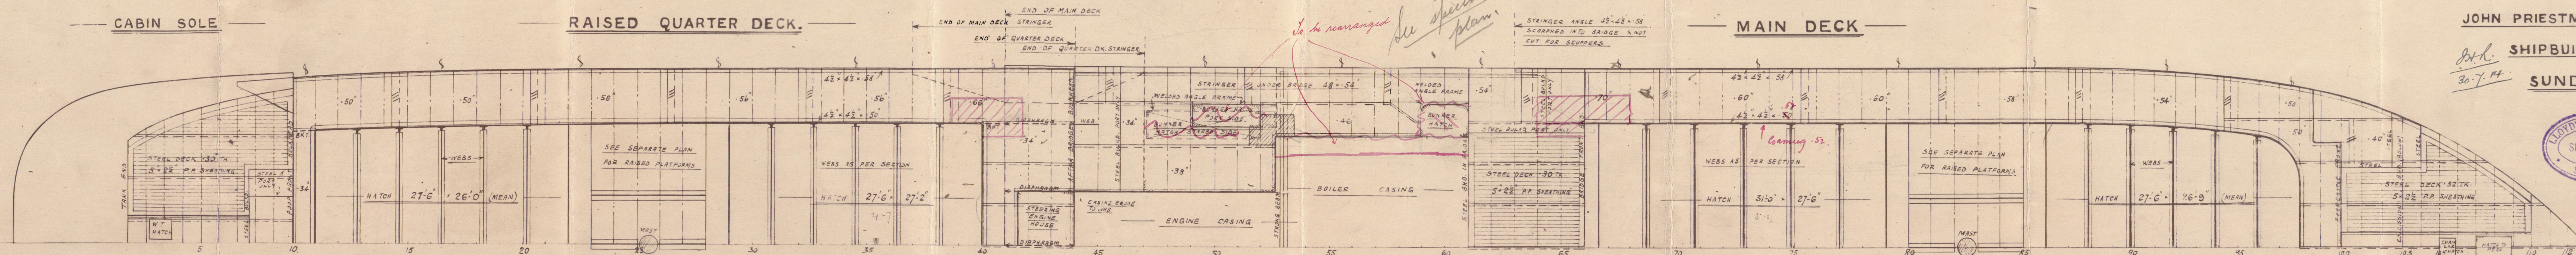

JOHN PRIESTMAN & CO,

SHIPBUILDERS,


SUNDERLAND.



C.B.
7-8-14

S. S. "KOWARRA"
PRIESTMANS N^o 253
DECK PLANS.

SLO RPT N^o 26601

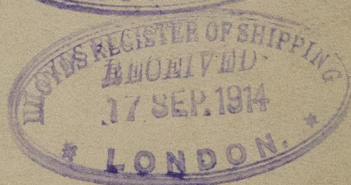

© 2019

Lloyd's Register
Foundation

W184-0198