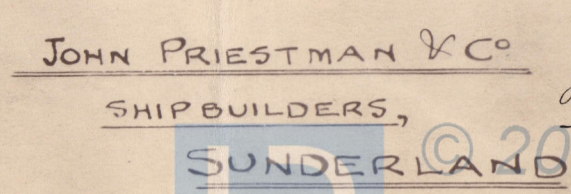


To CLASS 100 A.I. AT LLOYDS.

DEPTH METERS: - - - - 230.

$$12^v = 12^u = 12^q = 12^y = 12^z$$


24'0" TO RAISED QUARTER DECK.

34
See top sheet shell plan

Quadruple to
ITS TREBLE.
1
USED .04" IN LIEU

32.
90 faths each } Steel wire with
" " " } Owner's consent.

FORZ
C.B.
7.8.14

LLOYD'S REGISTER OF
SUNDERLAND
1-8.14
SHIPPING




JOHN PRIESTMAN & CO
SHIPBUILDERS,
SUNDERLAND



Lloyd's Register
Foundation

W184 - 0199

S. S. KOWARRA
PRIESTMANS N^o 253
MIDSHIP SECTION
SLO RPT N^o 26601

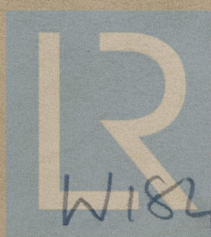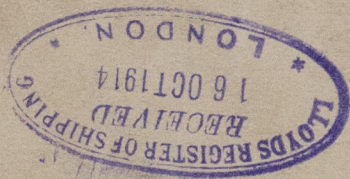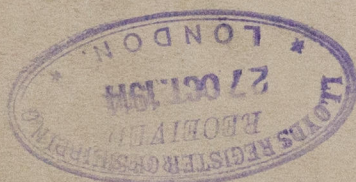

© 2019

Lloyd's Register
Foundation

W184-0199