


5.12.11

# ALTERNATIVE SECTION

S.S. N° 270.

SCALE  $\frac{1}{2}'' = 1 \text{ FOOT}$ .

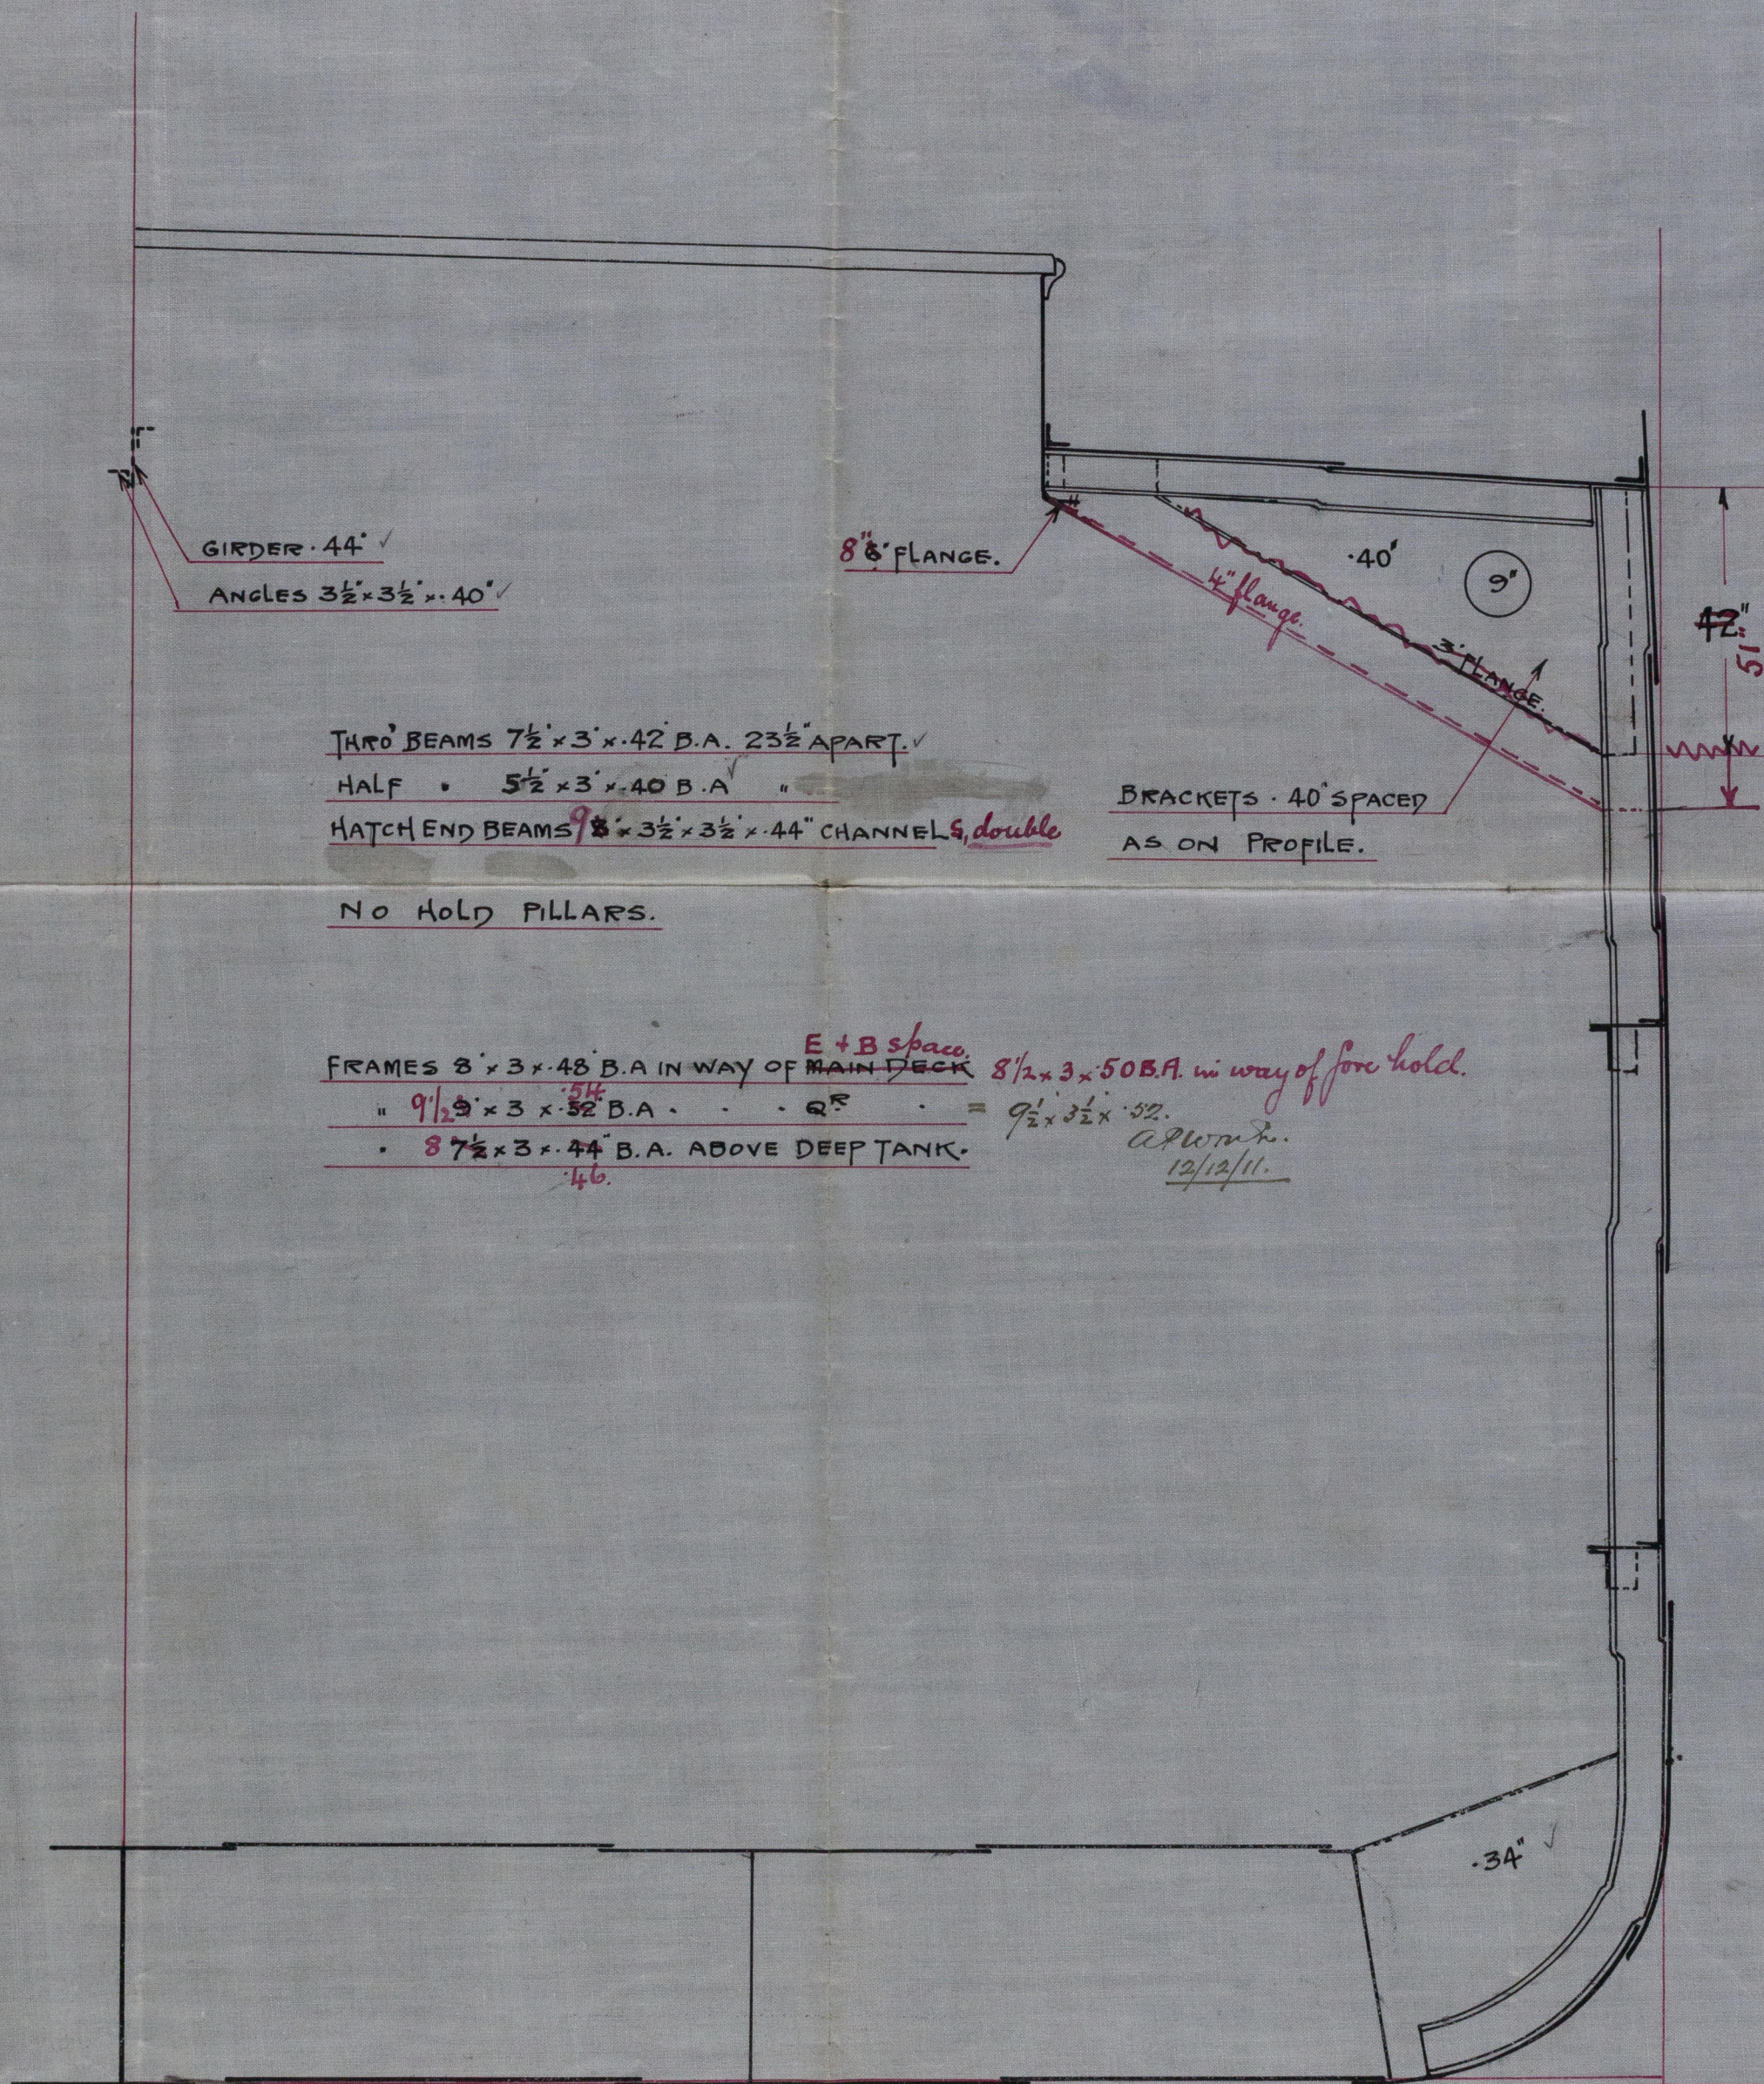

THRO BEAMS  $7\frac{1}{2} \times 3 \times 42$  B.A.  $23\frac{1}{2}''$  APART.

HALF •  $5\frac{1}{2} \times 3 \times 40$  B.A. "

HATCH END BEAMS  $9\frac{1}{2} \times 3\frac{1}{2} \times 3\frac{1}{2} \times 44$  CHANNELS, double

BRACKETS .40" SPACED  
AS ON PROFILE.

NO HOLD PILLARS.

FRAMES  $8 \times 3 \times 48$  B.A. IN WAY OF MAIN DECK


"  $9\frac{1}{2} \times 3 \times 52$  B.A. " " Q<sup>5</sup>

"  $8\frac{1}{2} \times 3 \times 44$  B.A. ABOVE DEEP TANK.

$8\frac{1}{2} \times 3 \times 50$  B.A. in way of fore hold.

$9\frac{1}{2} \times 3\frac{1}{2} \times 52$  A.P.W. in h.  
12/12/11.

C.B.  
5.12.11.

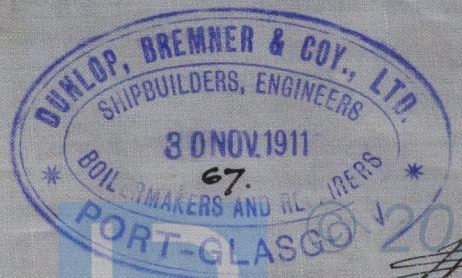



"Kehraa."

ex

5/8" "Gegarth."


Crk Report N° 16301.

W186-0081

VE SECTION

570.

Foot.

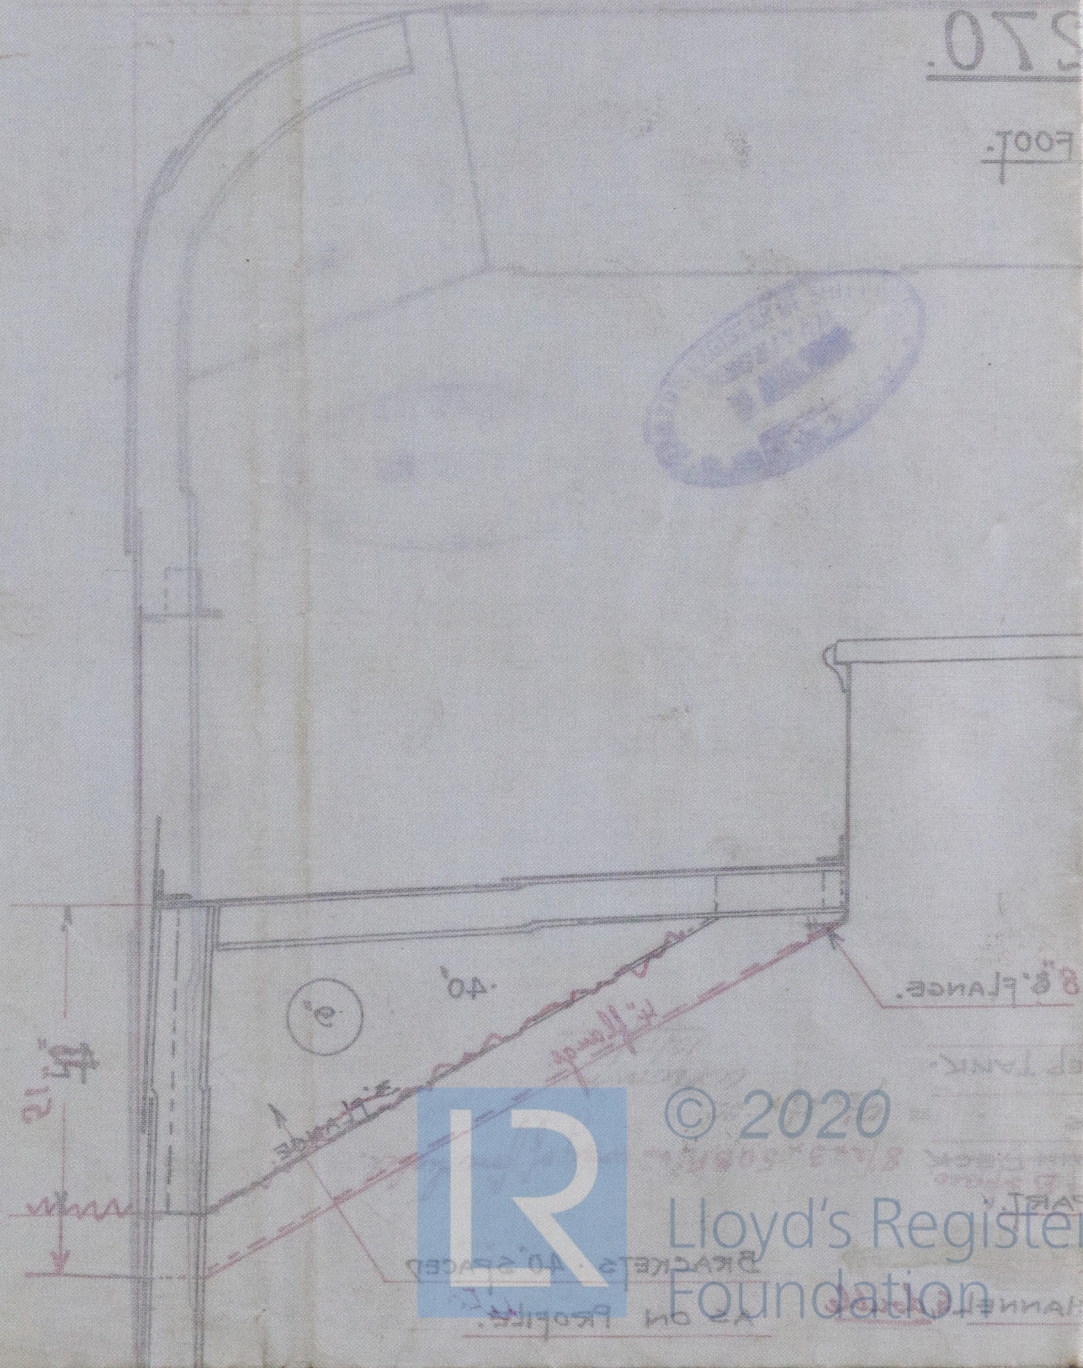

© 2020

Lloyd's Register Foundation