


MASTS, WINCHES, WINDLASS, DECKHOUSES, ETC.  
SUPPORTED TO SURVEYOR'S SATISFACTION.

# S.S. "LULWORTH HILL" PROFILE & DECK PLAN.

SCALE ~ 1/8" = 1 FOOT

DIMENSIONS ~ L.B.P. 415'-0". BREADTH MOULDED 60'-2". DEPTH MOULDED 38'-3" TO UPPER DECK. TO CLASS LLOYDS  
100.A1. WITH A FREEBOARD CORRESPONDING TO A DRAUGHT NOT EXCEEDING THAT CONTEMPLATED  
BY THE RULES FOR A COMPLETE SUPERSTRUCTURE VESSEL HAVING A TONNAGE OPENING  
WITH SPECIAL NOTATIONS - LONGITUDINAL FRAMING AT BOTTOM AND DECK.  
ISHERWOOD COMBINATION SYSTEM ARCFORM PATENT (N.B.S. NEW BRITISH STANDARD)

 


W<sup>m</sup>. Hamilton & Co. L<sup>ds</sup>.

N<sup>o</sup>. 440.

Profile & B<sup>t</sup> Plans  
as Built.

S. S. LULWORTH HILL

Gen. 1<sup>st</sup> E. Rpt. N<sup>o</sup>.

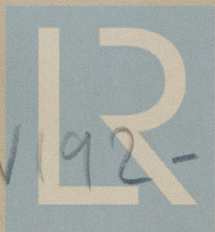

© 2019

W192-0023  
Lloyd's Register  
Foundation