

S.S. "MODLIN."

W192-0082

MES.

THE ARRANGEMENT COMPLIES WITH THE REQUIREMENTS OF SECTION 10 CLAUSES.

12. THERE IS NO CONNECTION FROM THE
11.6. DISCHARGE SIDE OF THE BALLAST PUMPS
7.62 THE TANK LINE.

3" E.R. STARBOARD

3" N°3 HOLD S.

3" N°4 HOLD S.

NR NR NR

3 1/4"

2 3/4" TUNNEL WELL

2 3/4" DRY SPACE
BELOW
AFTER
PEAK.

NR NR

SUCTIONS TO MAIN
ENGINE BILGE PUMPS
3.54" DIAM X 25.2" STROKE

"M" "Y"

SL NR
NR NR

SUCTION TO DUPLEX
BALLAST PUMP
STEAM CYL 6 1/2"
WATER " 7 1/2"
STROKE 6"


SUCTION TO SINGLE
CYL. BALLAST PUMP.
STEAM CYL 7 1/2"
WATER " 10 3/8"
STROKE 9"

NR NR NR

3" N°4 HOLD P
3" N°3 HOLD P

3" E.R. PORT

W.J.R.
31-7-41.

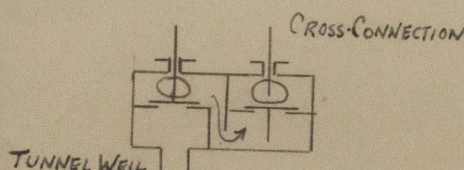

SECTION ON AB.

5 1/4" BILGE
INJECTION.

4" DIRECT
SUCTION
TO BALLAST
PUMPS

© 2018

Lloyd's Register
Foundation

noted
See Mech 10607

BP
8/8/4



© 2019

Lloyd's Register
Foundation